



PLAN	DATE	BY
SURVEYED		
PLOTTED		
CHECKED		
NOTED		
NO		

PROFILE	DATE	BY
SURVEYED		
PLOTTED		
CHECKED		
NOTED		
NO		

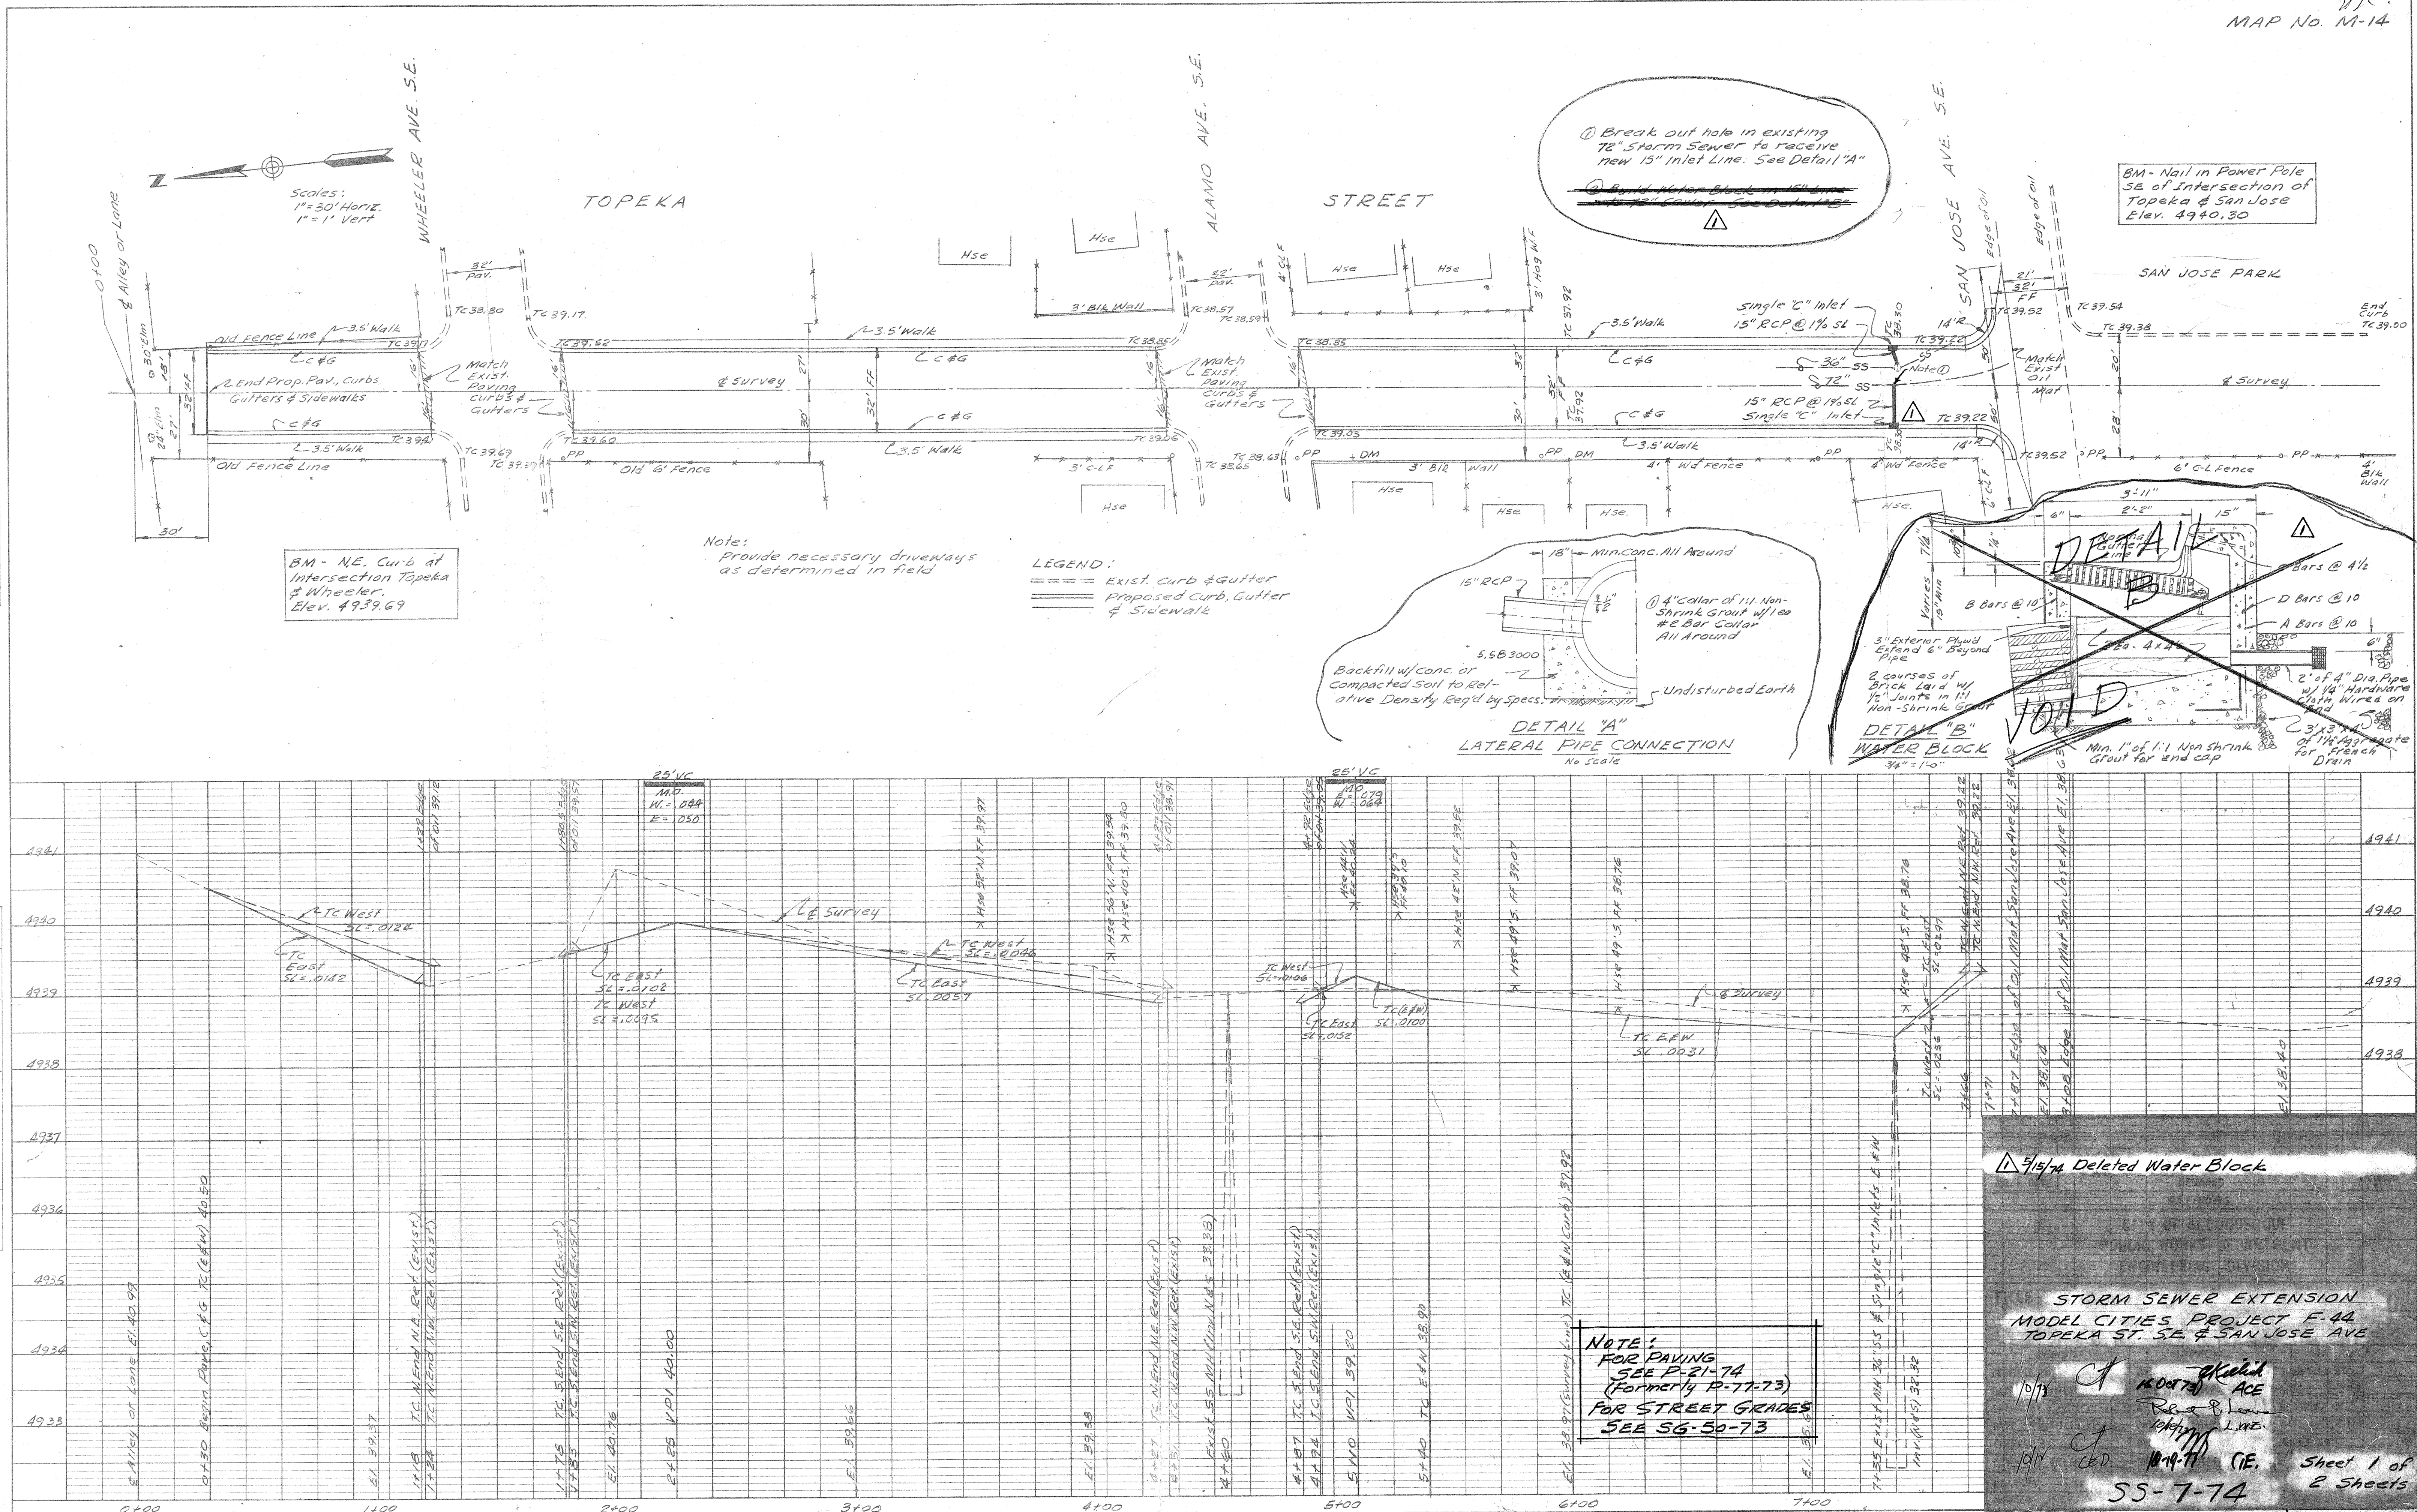

Scales:
1" = 30' Horiz.
1" = 2' Vert.

PLAN	SURVIVED	BY	DATE
	PLOTTED		
	NOTE BOOK		
	ALIGNMENT CHECKED		
	RT. OF WAY CHECKED		

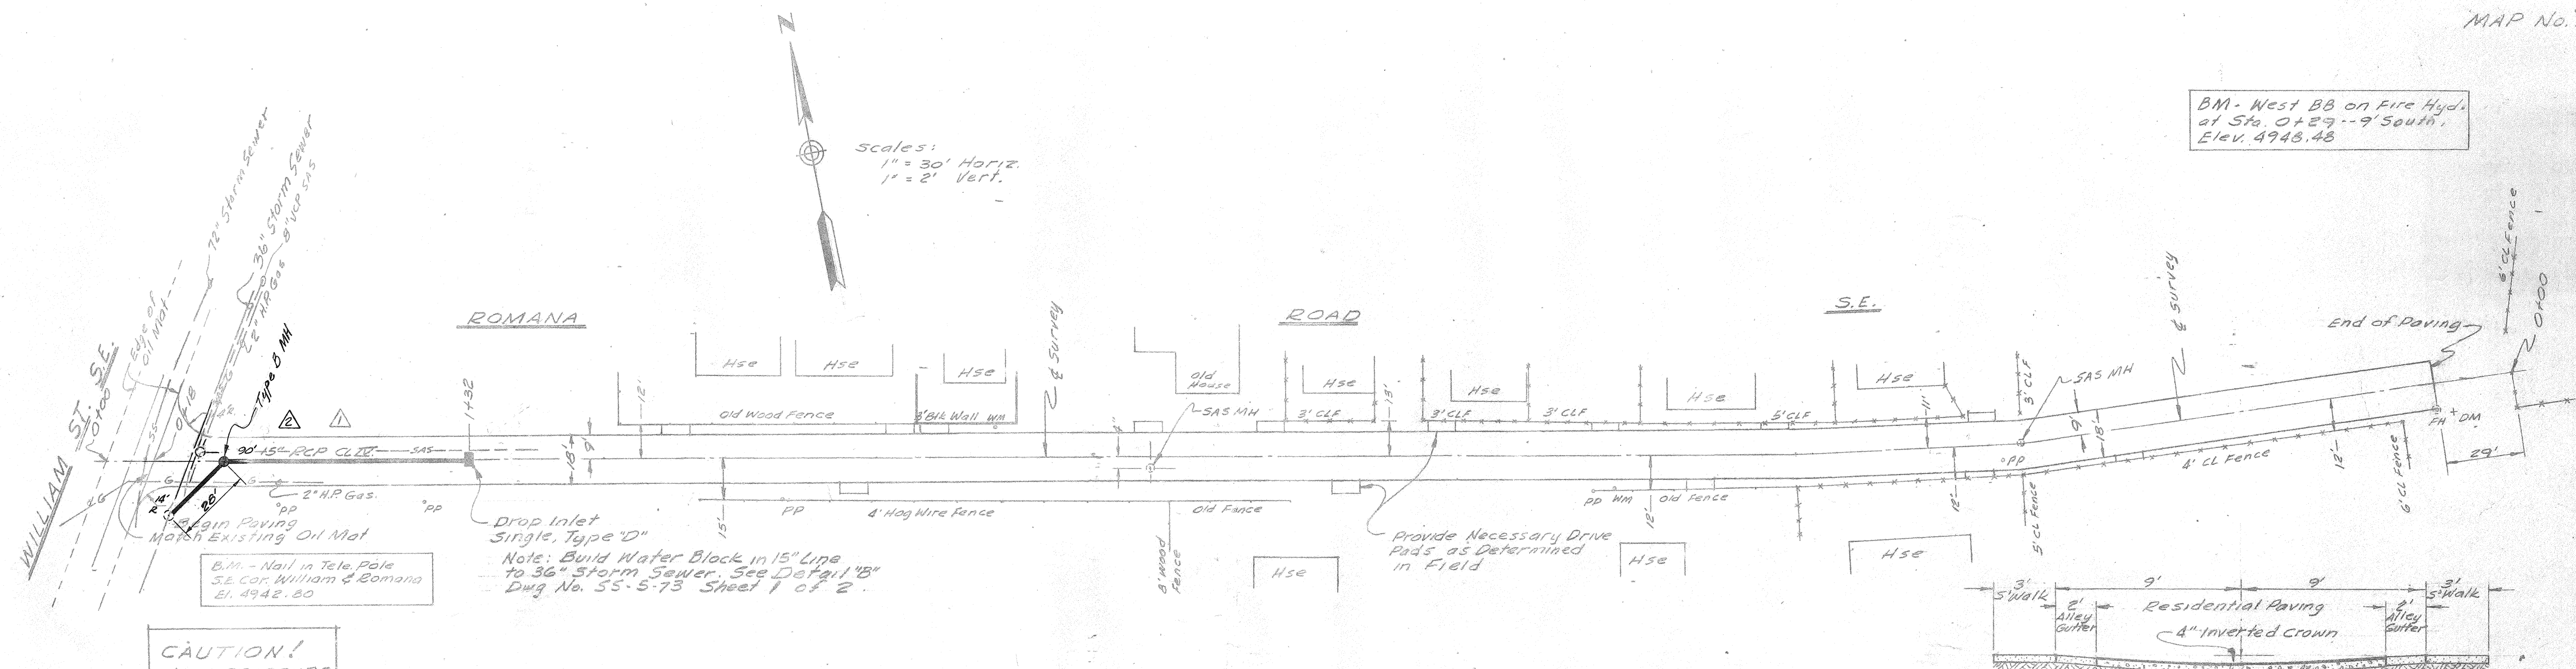


CAUTION!
HIGH PRESSURE
GAS LINES IN
THIS AREA.

TYPICAL PAVING
SECTION
1" = 1'

1	2	3	4	5	6	7	8	9	10	11	12	13	14	15	16	17	18	19	20	21	22	23	24	25	26	27	28	29	30	31
2	2			0	0	7		0	2	7	4			0	1									5	5	1	4	1	7	1

PROFILE	BY	DATE
SURVED		
PLOTTED		
GRADES CHECKED		
B. M. NOTED		

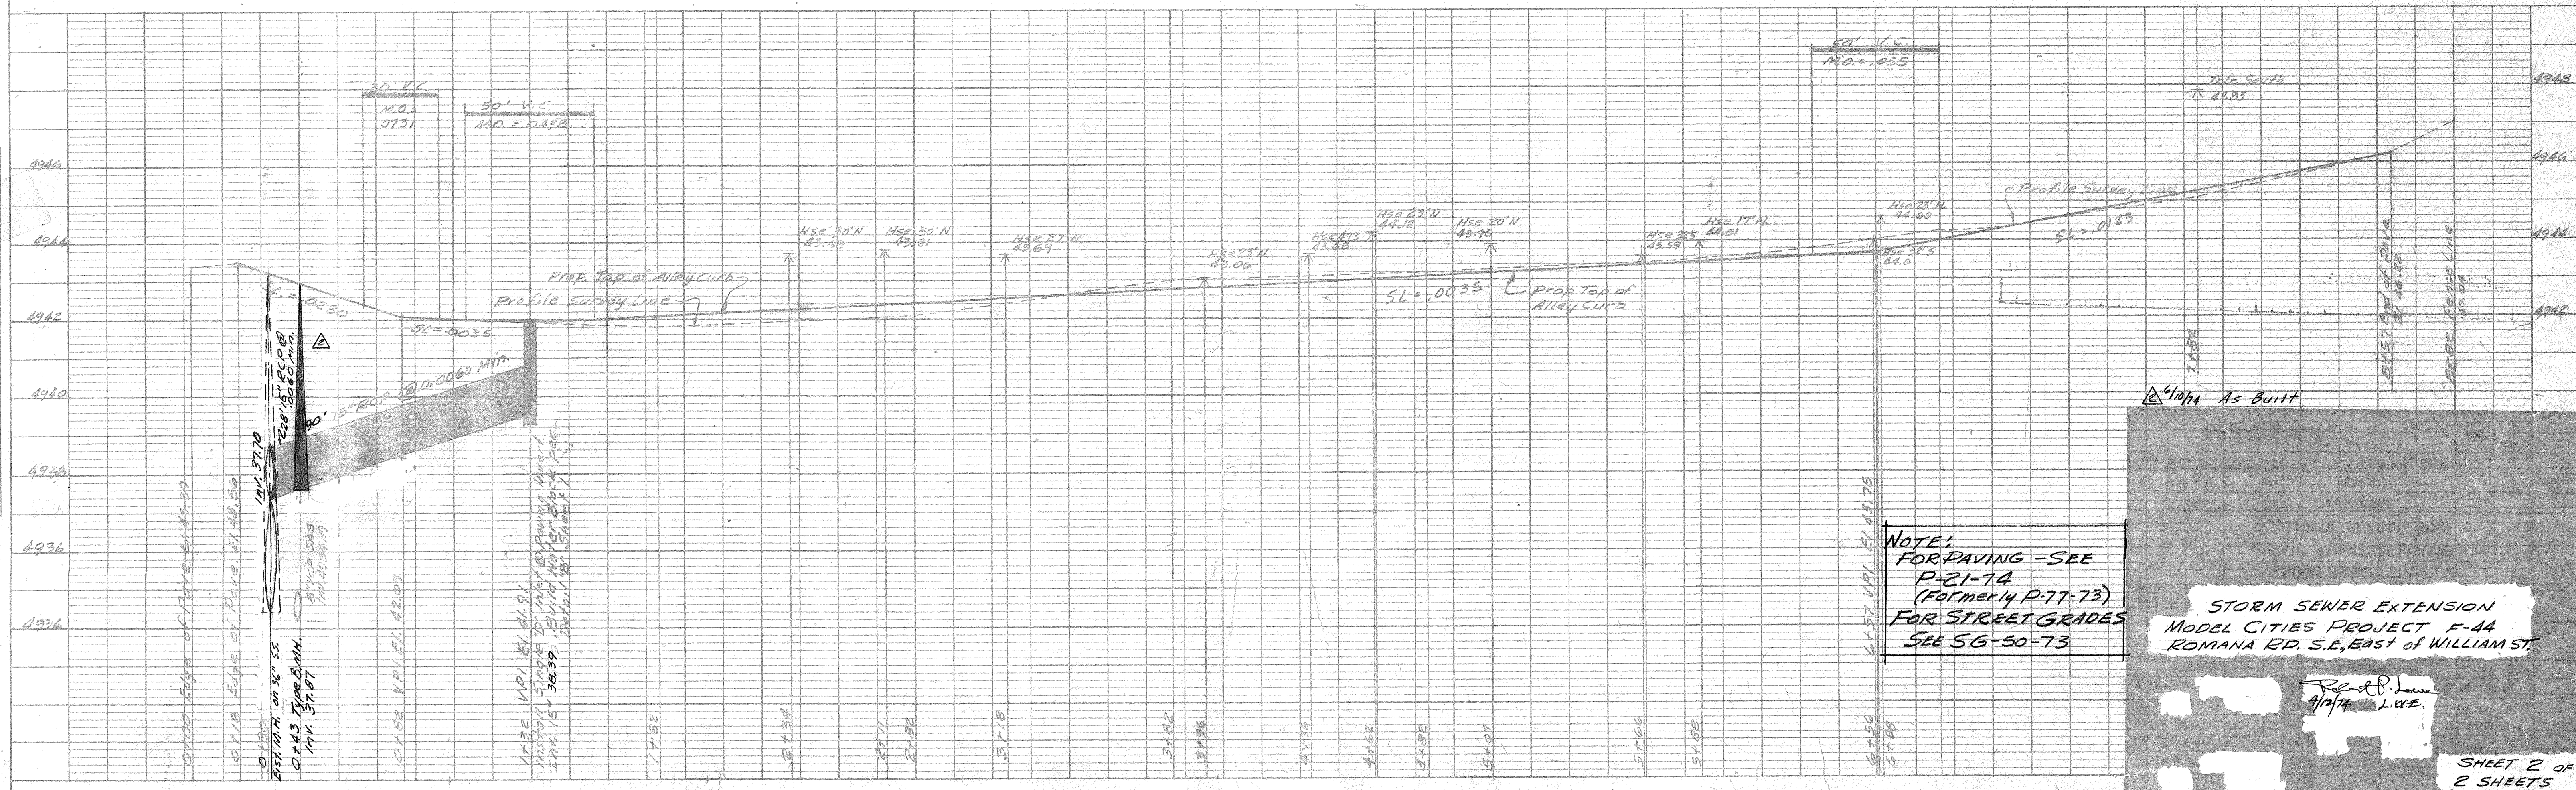

NOTE:
FOR PAVING - SEE
P-21-74
(Formerly P-77-73)
FOR STREET GRADES

STORM SEWER EXTENSION
MODEL CITIES PROJECT F-44
ROMANA RD. S.E., EAST OF WILLIAM ST.

Robert P. Lowe
4/12/14 L.O.E.

SHEET 2 OF
2 SHEETS

SS-7-74

(FORMERLY 55-5-73)

55-7-74

REVISION Δ 2