


DATE	BY	PROFILE
		SURVIVER
		PLOTTED
		GRADE CHECKED
		B. M. NOTED
		STRUCTURE NOTATIONS CH'NG
		MO.

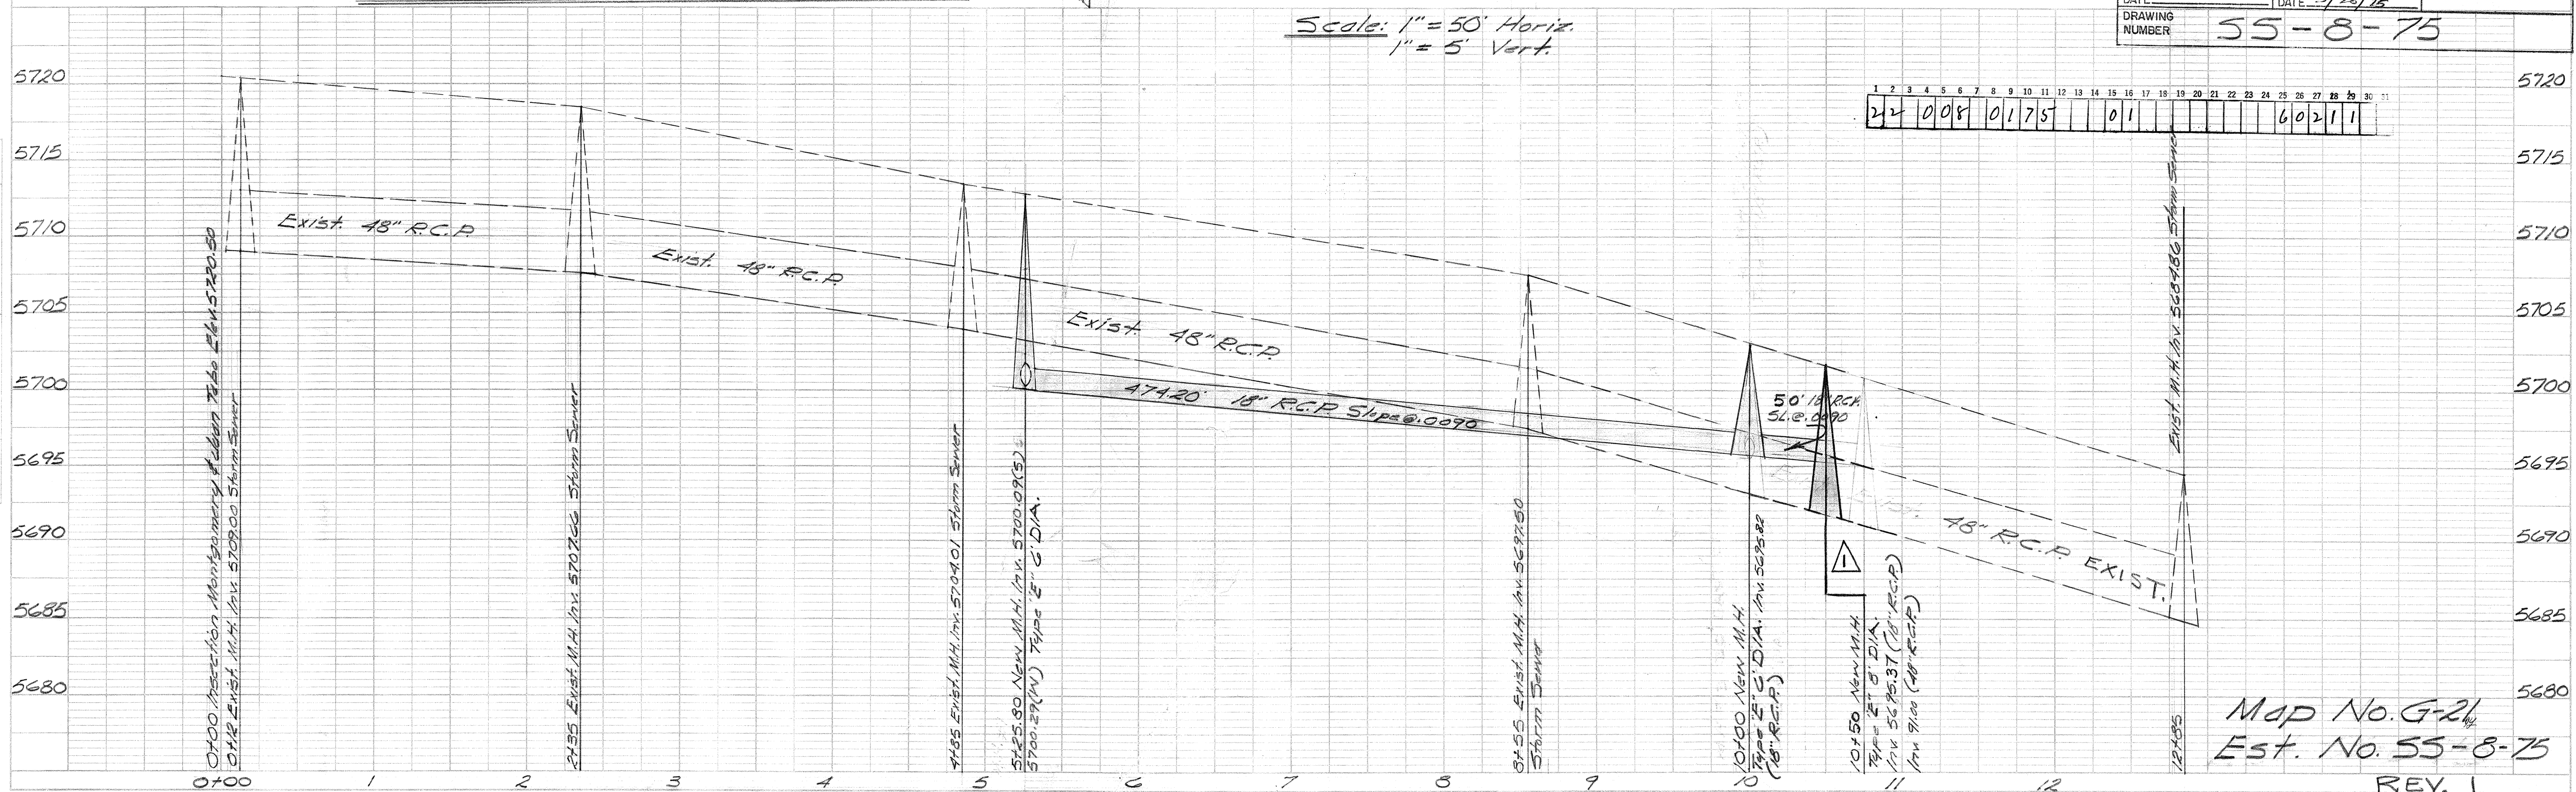

Map No. G-2^{1/2}
Est. No. 55-8-75
REV. 1