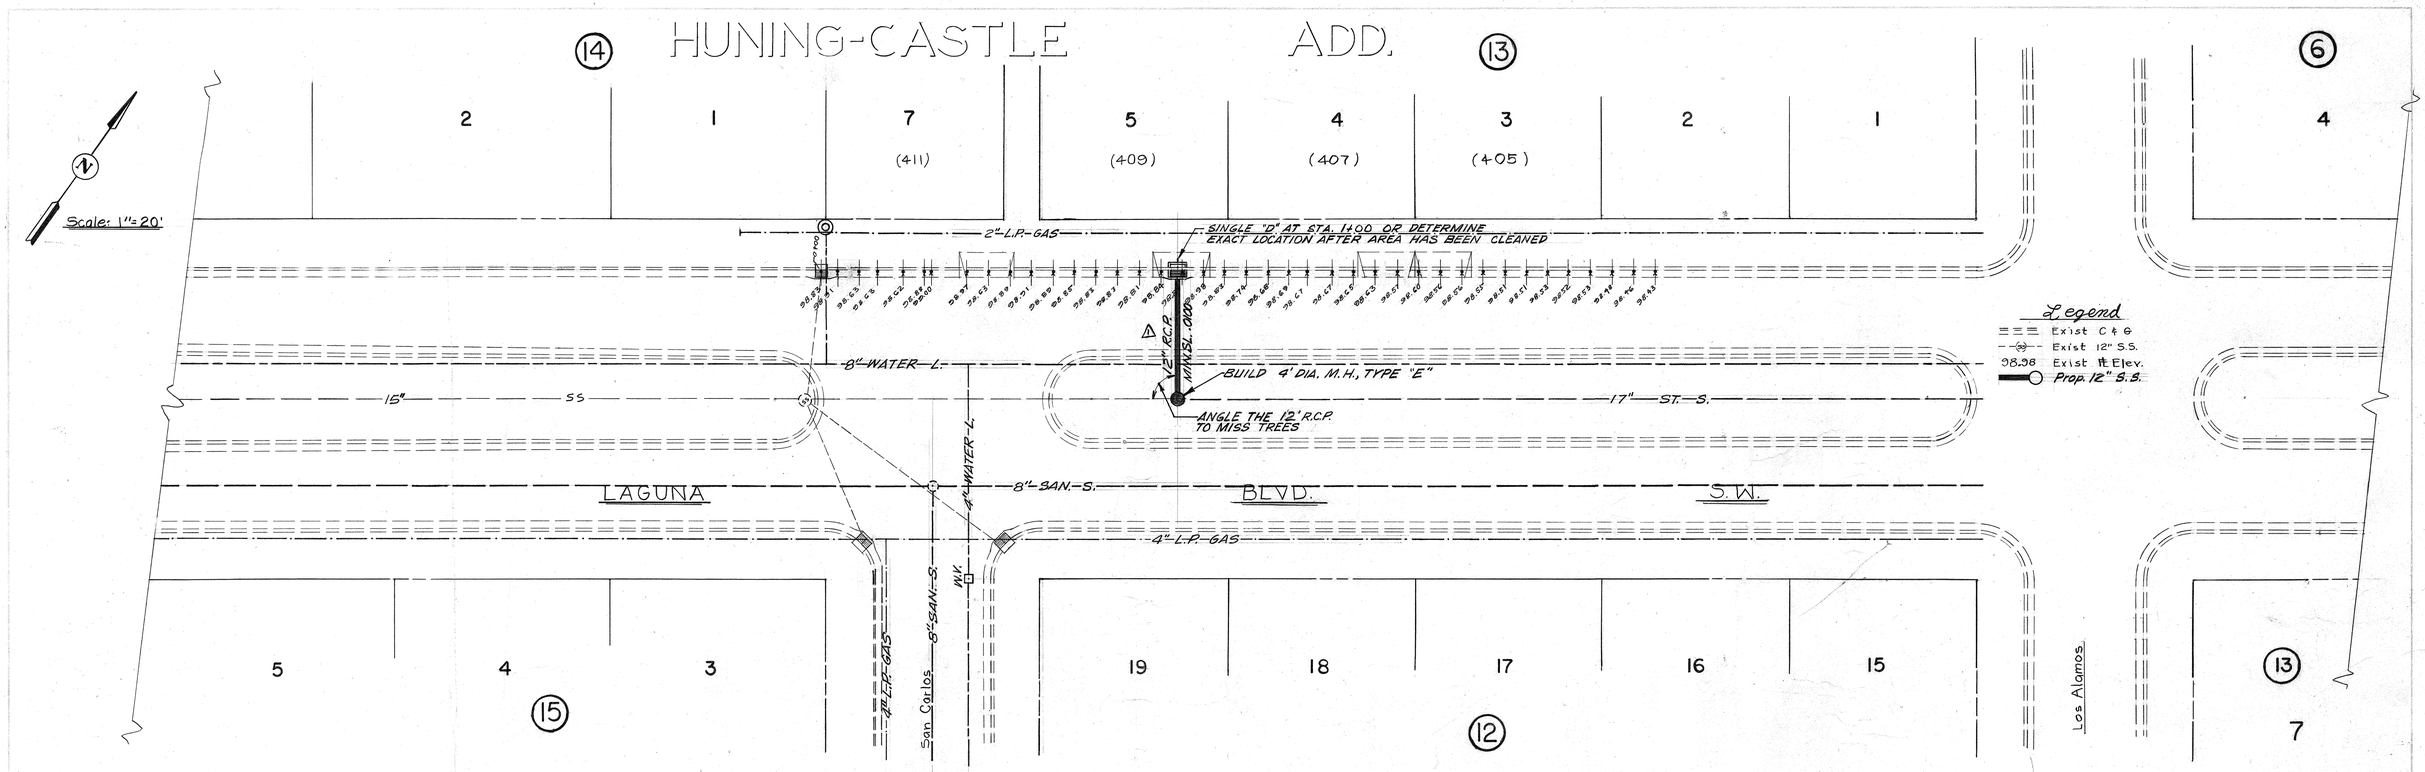

SCALES
Horiz: 1"=20'
Vert: 1"=1'

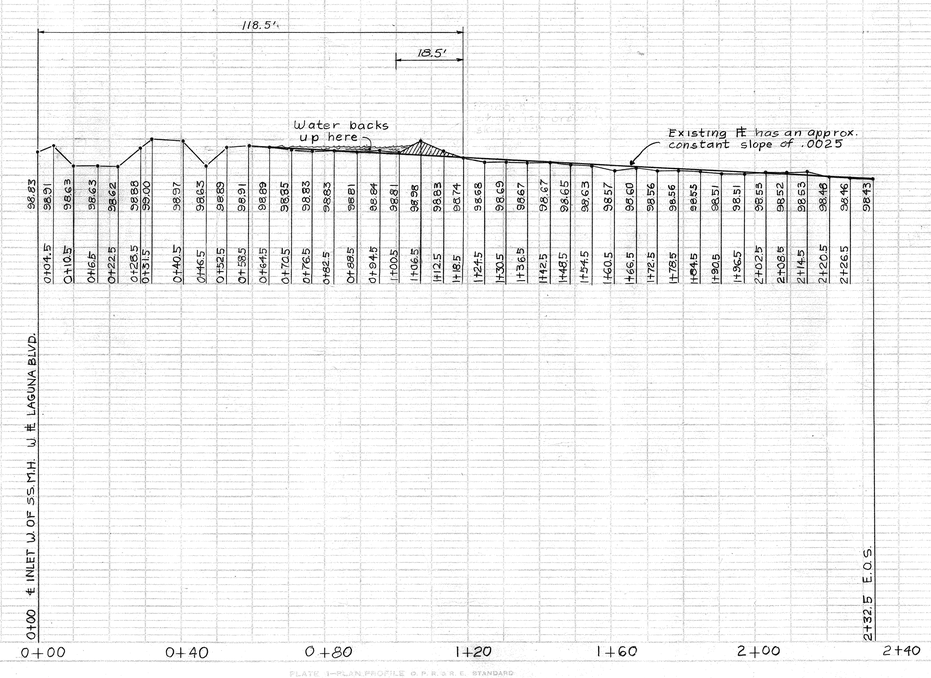

1	2	3	4	5	6	7	8	9	10	11	12	13	14	15	16	17	18	19	20	21	22	23	24	25	26	27	28	29	30	31
2	2	0	1	6	0	1	7	4						0	1									5	8	1	3	2		

Map No. J-13-S

CITY OF ALBUQUERQUE
PUBLIC WORKS DEPARTMENT
ENGINEERING DIVISION

TITLE Drainage Study @ 407 Laguna Blvd. S.W.

SUBMITTED BY DATE TITLE	APPROVED BY DATE TITLE ACE	PRELIMINARY DRWG. DATE
DESIGNED BY DATE TITLE	APPROVED BY DATE 7/30/74 TITLE	CONSTRUCTION DRWG. DATE
DRAWN BY T.L. Smith DATE 5/31/74 TITLE	APPROVED BY DATE 7-30-74 TITLE C.E.	AS BUILT DRWG. DATE
CHECKED BY DATE TITLE	APPROVED BY DATE TITLE	FILE NO. SS-16-74
REV. BY DATE 2/13/75	NOTES: CHANGED PIPE SIZE FOR MIN. COVER	
REV. BY DATE 7-24-74	NOTES: Added ST. M.H. "D" INLET & 15" R.C.P.	SHEET NO. SHEETS.

PLATE 1—PLAN-PROFILE G.P.R.G.R.E. STANDARD
THE FREDERICK POST CO., CHICAGO