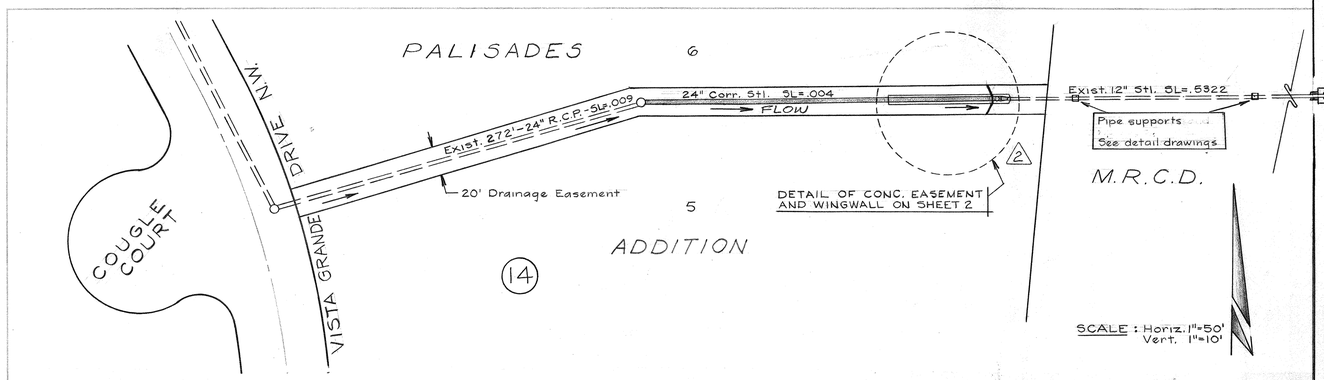

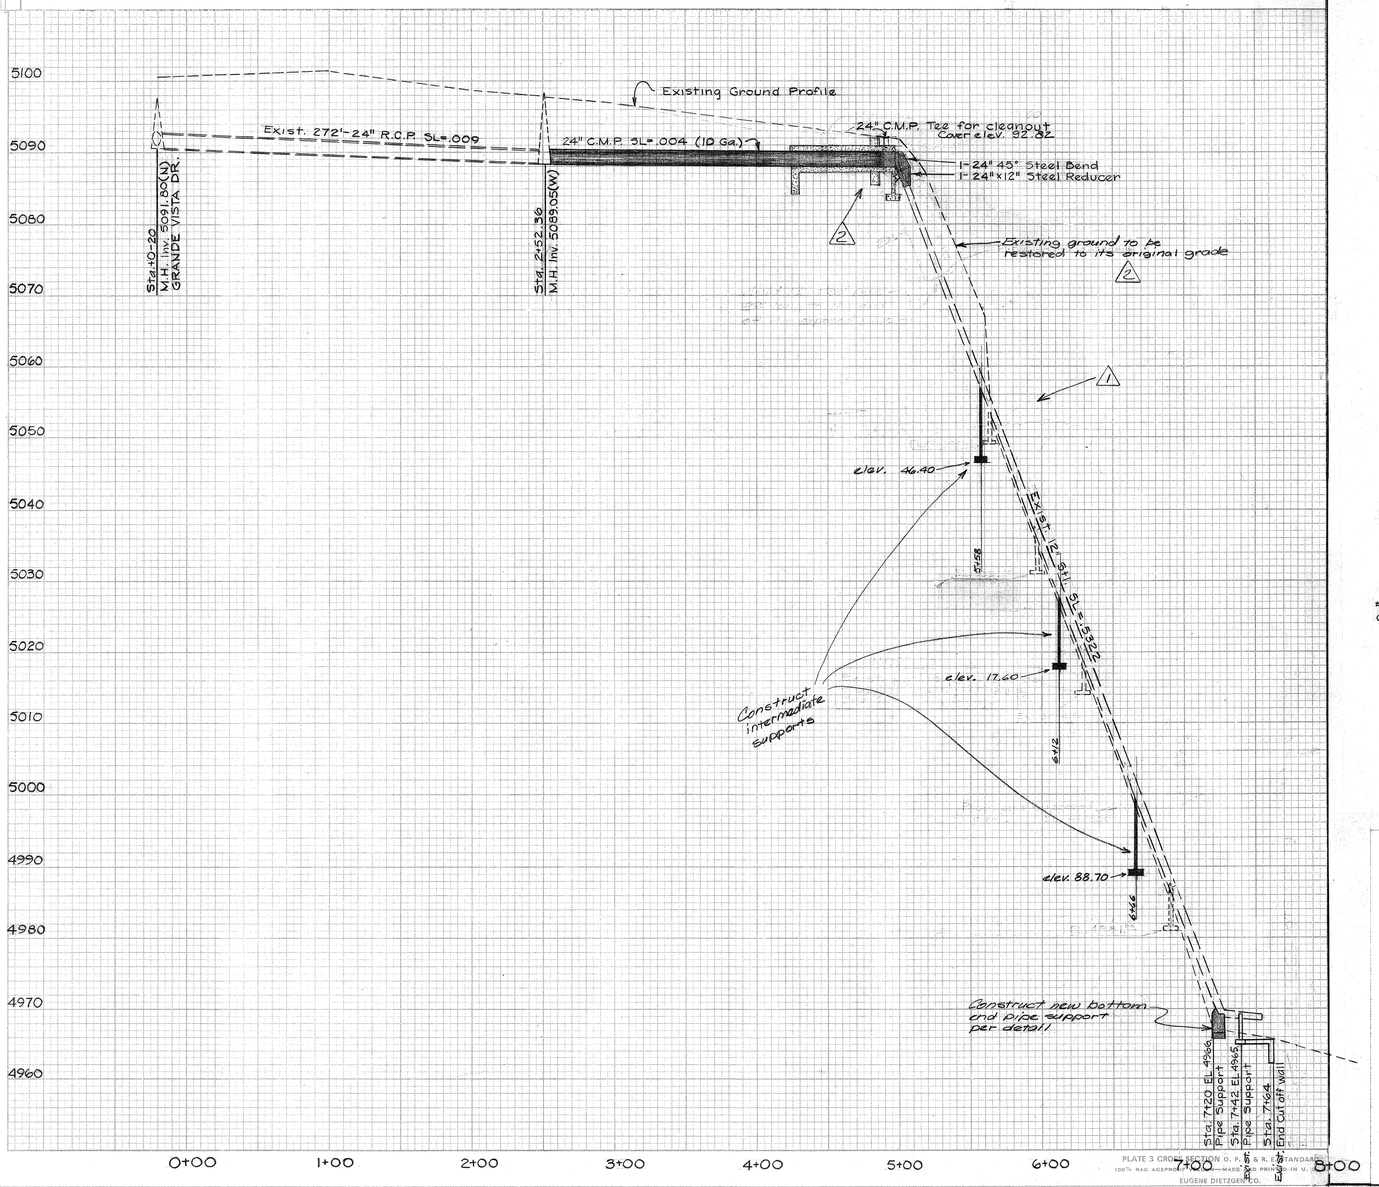

GENERAL NOTES

1. Expose both ends of existing 12" steel pipe (at washed out M.H. (sta. 5+00) and at riverbed which is covered by earth.)
2. Build a new intermediate support at stationing indicated and remove existing ones if necessary.
3. Install 24" C.M.P. tee and pipe where shown to be used as a cleanout with cover as detailed.
4. Build a new support at bottom end of existing 12" steel pipe (see detail).
5. For concrete encasement and wing-wall details see sheet #2.

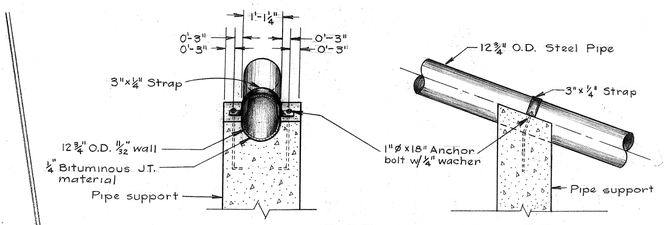

PIPE ANCHOR DETAIL

Scale : ½" = 1'-0"

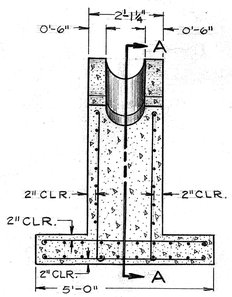

Scale : ½" = 1'-0"

PROFILE A-A

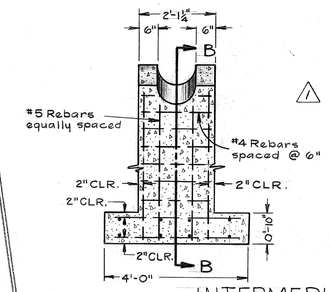

INTERMEDIATE PIPE SUPPORT DETAIL

Scale : ½" = 1'-0"

PROFILE B-B

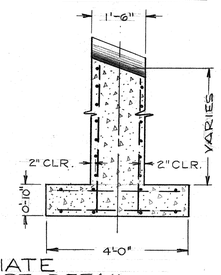

1.08 CY

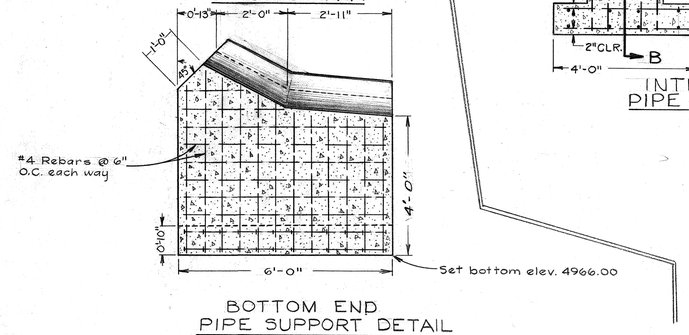

BOTTOM END PIPE SUPPORT DETAIL

2.61 CY

NO.	DATE	REMARKS	RECORDED BY
1	11/14/75	Corrections for adjustment to field conditions	BE
2	5/14/75	Manhole relocation and cut-off wall added, notes added	BE

REVISIONS

CITY OF ALBUQUERQUE
PUBLIC WORKS DEPARTMENT
ENGINEERING DIVISION

TITLE PALISADES ADDITION — Storm sewer line replacement between lots 5 & 6, blk. 14.

DESIGNED BY	DRAWN BY Zamora	AS BUILT
TITLE CKD	TITLE DFT. II	SUBMITTED BY
DATE 9/17/74	DATE 9-16-74	TITLE
APPROVAL		DATE
ASS'T CITY ENGINEER	CITY ENGINEER	RECORDED BY
DATE 18 Sep 74	DATE 3-10-75	TITLE
WATER ENGINEER	LIQUID WASTE ENGINEER	DATE
DATE	DATE 3/7/75	SHEET NO. 1 OF 2 SHEETS

DRAWING NUMBER SS-19-74 MAP H-11-N

1	2	3	4	5	6	7	8	9	10	11	12	13	14	15	16	17	18	19	20	21	22	23	24	25	26	27	28	29	30
2	2		0	1	9		0	1	7	4				0	5									5	9	1	1	1	

FINAL SURVEY		DATE	BY
SURVEYED			
PLOTTED			
TRAVERSE			
NOTE BOOK	AREAS CHECKED		
NO.			

ORIGINAL SURVEY		DATE	BY
SURVEYED			
PLOTTED			
TRAVERSE			
NOTE BOOK	AREAS CHECKED		
NO.			

PLATE 3 CROSS SECTION O. P. & R. STANDARDS
100% RAG ACEPRINT—MADE IN U.S.A. PRINTED IN U.S.A.
EUGENE DIETZGEN CO.

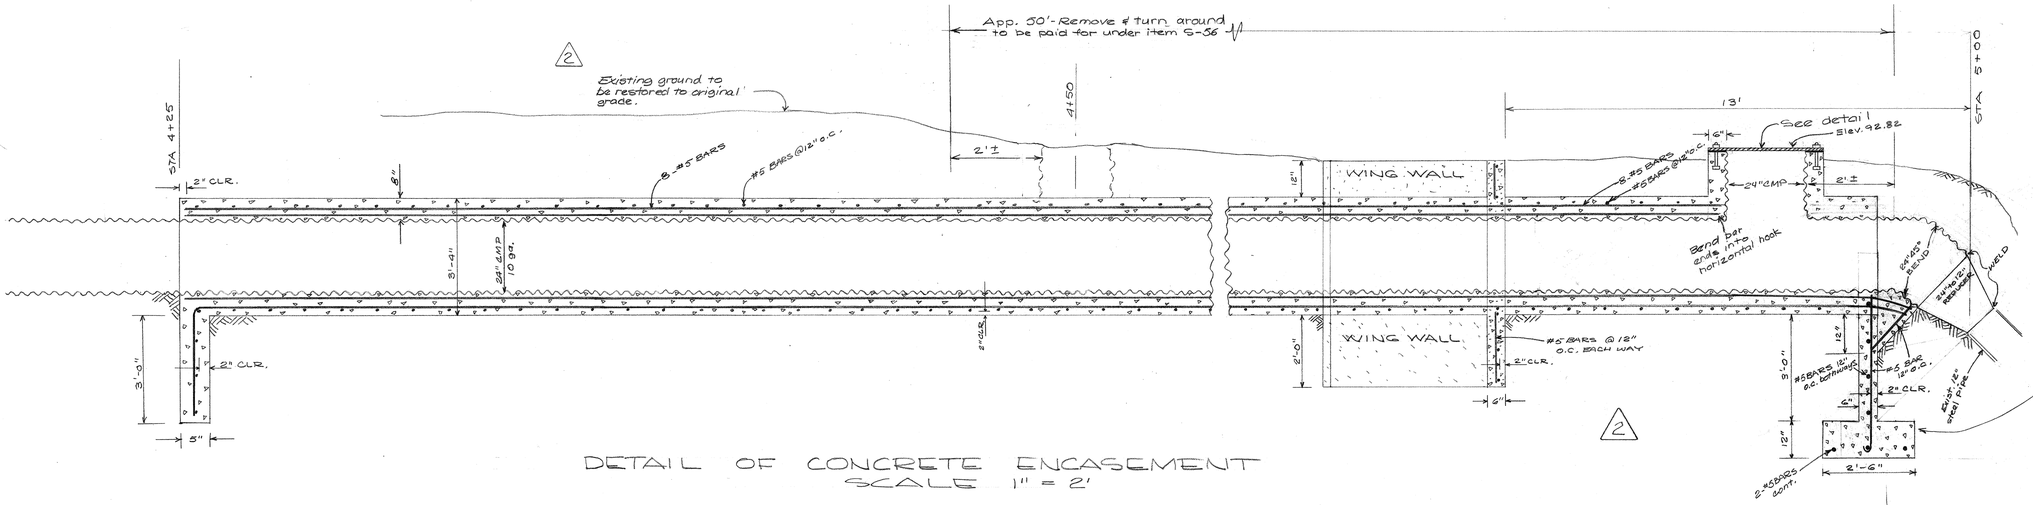

DETAIL OF CONCRETE ENCASEMENT
SCALE 1" = 2'

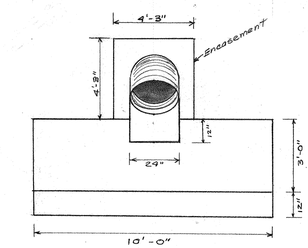

FRONT VIEW OF CUT-OFF WALL
Scale 1" = 3'

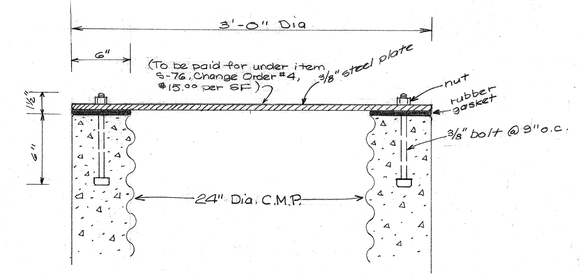

DETAIL OF CLEANOUT COVER
SCALE 1" = 6"

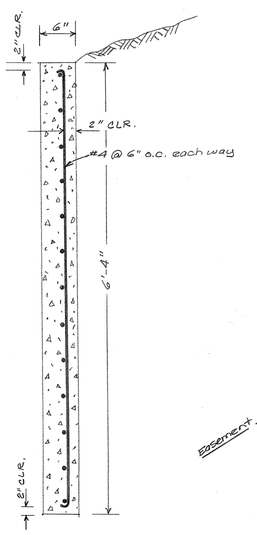

WING WALL SECTION
Section A-A

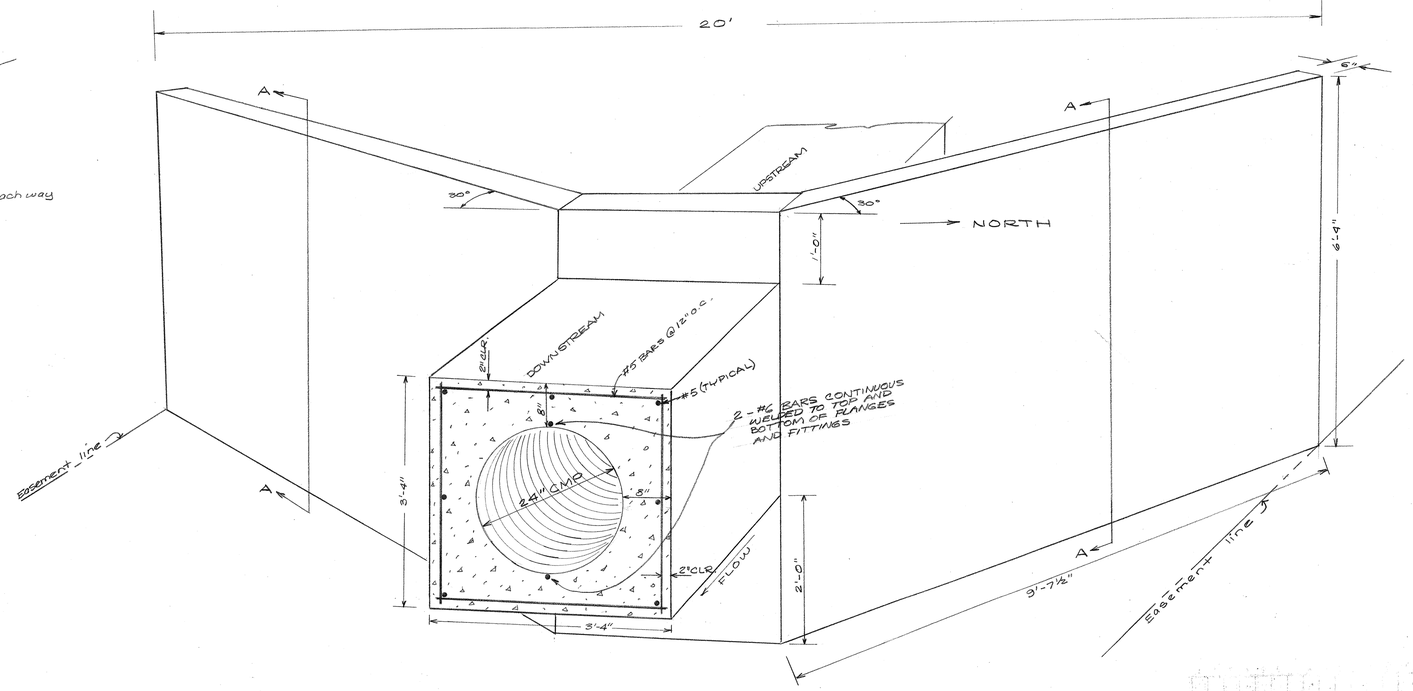

PERSPECTIVE OF WING WALL

MAP NO. H-11-N

NO.	DATE	REMARKS	RECORDED BY
1	4/16/75	Corrections for adjustment to field conditions	CE
2	5/14/75	Manhole relocation and cut-off wall added, notes added	RE

REVISIONS

CITY OF ALBUQUERQUE
PUBLIC WORKS DEPARTMENT
ENGINEERING DIVISION

TITLE Storm Sewer Replacement in Palisades Add
DETAILS

DESIGNED BY CJ TITLE CED DATE 9/16/74	DRAWN BY B. Emmert TITLE Draftsman DATE 9/11/74	AS BUILT SUBMITTED BY TITLE DATE
APPROVAL		
ASS'T CITY ENGINEER DATE 18 Sep 74	CITY ENGINEER DATE 3-10-75	RECORDED BY TITLE DATE
WATER ENGINEER DATE	LIQUID WASTE ENGINEER DATE 3/7/75	SHEET NO. 2 OF 2 SHEETS
DRAWING NUMBER SS-19-74		

1	2	3	4	5	6	7	8	9	10	11	12	13	14	15	16	17	18	19	20	21	22	23	24	25	26	27	28	29	30
2	2		0	1	9		0	2	7	4				0	5									5	9	1	1	1	