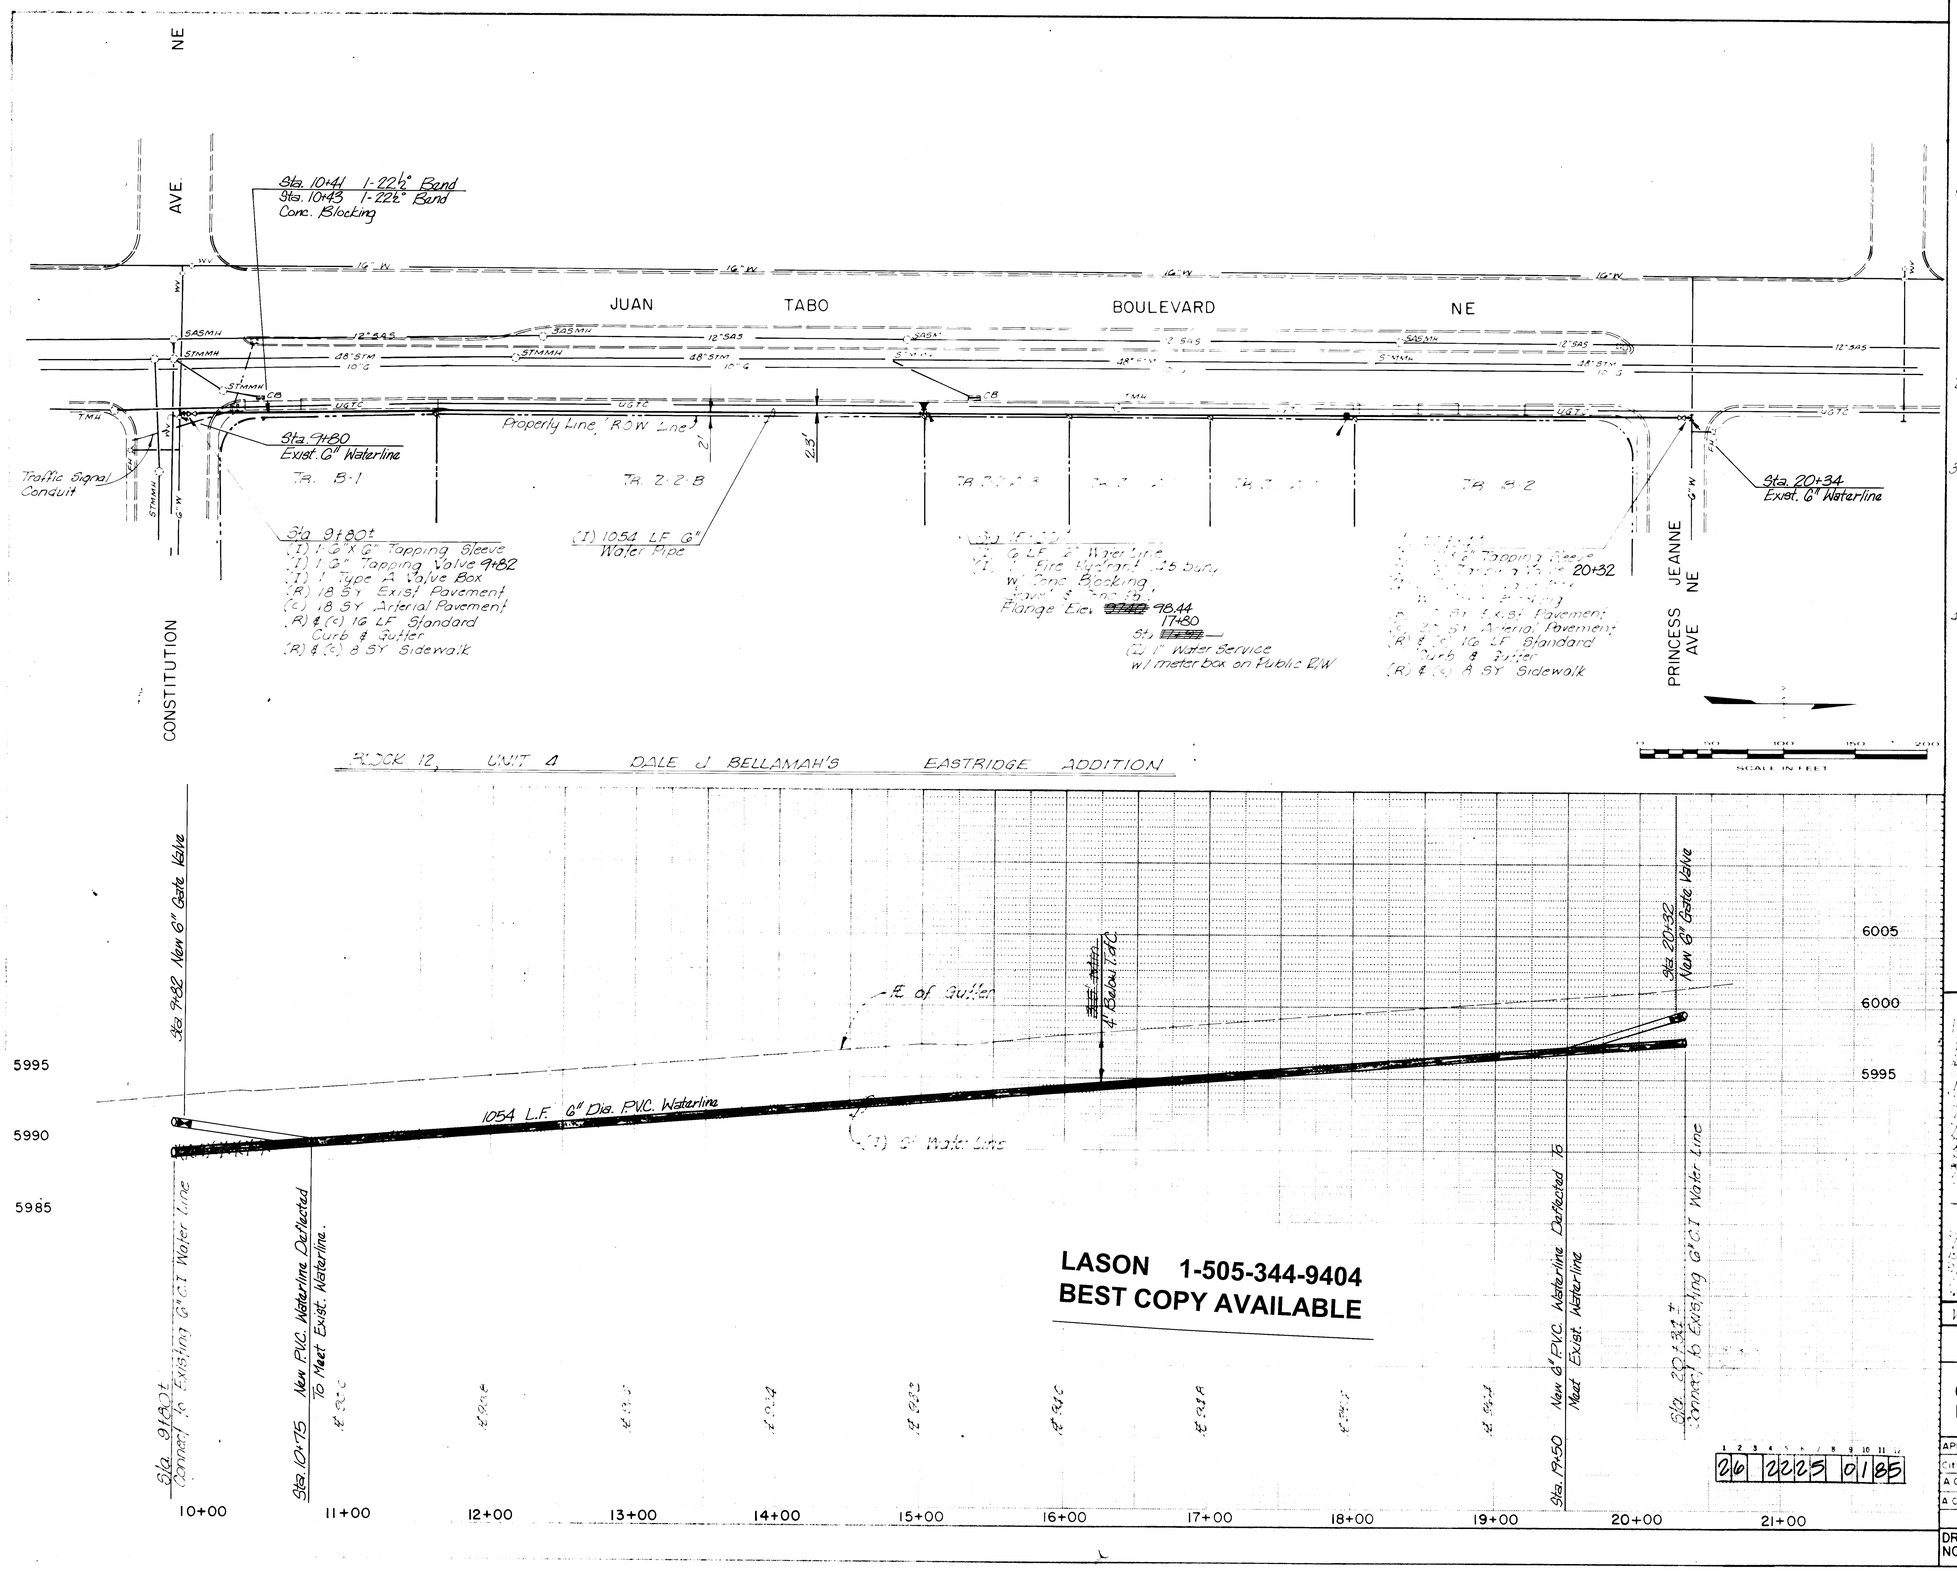

LASON 1-505-344-9404
BEST COPY AVAILABLE

LEGEND

W	Water Line
SAS	Sanitary Sewer
STM	Storm Sewer
G	Gas Line
UGTC	Underground Tel Cable
WV	Water Valve
SASMH	Sanitary Manhole
STMMH	Storm Manhole
FH	Fire Hydrant

NOTES

1. All work detailed on these plans to be performed under contract shall, except as otherwise stated or provided for hereon, be constructed in accordance with the New Mexico Standard Specifications for Public Works Construction - 1979 Edition (Referred to herein as the Standard Specifications.) & Contract Documents for PWC 84-3.
2. Two (2) working days prior to any excavation, contractor must contact line locating service, 765-1234, for location of existing utilities.
3. Prior to construction, the contractor shall excavate and verify the horizontal and vertical locations of all obstructions. Should a conflict exist, the contractor shall notify the Engineer or Surveyor so that the conflict can be resolved with minimum amount of delay.
4. Prior to construction the Contractor shall submit a traffic control plan for work in Constitution Ave & obtain a barricading permit.

AS BUILT INFORMATION
INSPECTOR'S CHANGES
FIELD VERIFICATION BY
CORRECTED BY
MICRO-FILM INFORMATION
RECORDED BY
DATE
NO

BENCH MARKS
BENCH MARK - Standard ACS Brass Tablet Stamped "5" C.E.A." set flush with the curb 510' South of the Construction Ave. and Juan Tabo Blvd. Intersection
Elev. 5594.29G

SURVEY INFORMATION
FIELD NOTES
NO. DATE BY

APPROVAL OF AS BUILT DRAWINGS
ASST. CITY ENGINEER - FIELD
DATE 1/18/86

ENGINEER'S SEAL

Project Site

VICINITY MAP

NO.	DATE	REMARKS	BY
		REVISIONS	

WILSON & COMPANY, ENGINEERS & ARCHITECTS
DESIGNED BY VER DATE JULY 1984
DRAWN BY MDJ DATE JULY 1984
CHECKED BY DATE

CITY OF ALBUQUERQUE
WATER RESOURCES DEPARTMENT

6" WATER LINE ON JUAN TABO BLVD. NE BETWEEN CONSTITUTION & PRINCESS JEANNE

APPROVALS	ENGINEER	DATE	APPROVALS	ENGINEER	DATE
City Engineer			Liquid Waste		
A.C.E. - Design			Traffic		
A.C.E. - Hydrology			Water		

26 2225 0185

DRAWING NO 2225 | MAP NO. J-22-Z | SHEET 1 OF 1

WILSON & COMPANY
ENGINEERS ARCHITECTS
ALBUQUERQUE NEW MEXICO

84-501