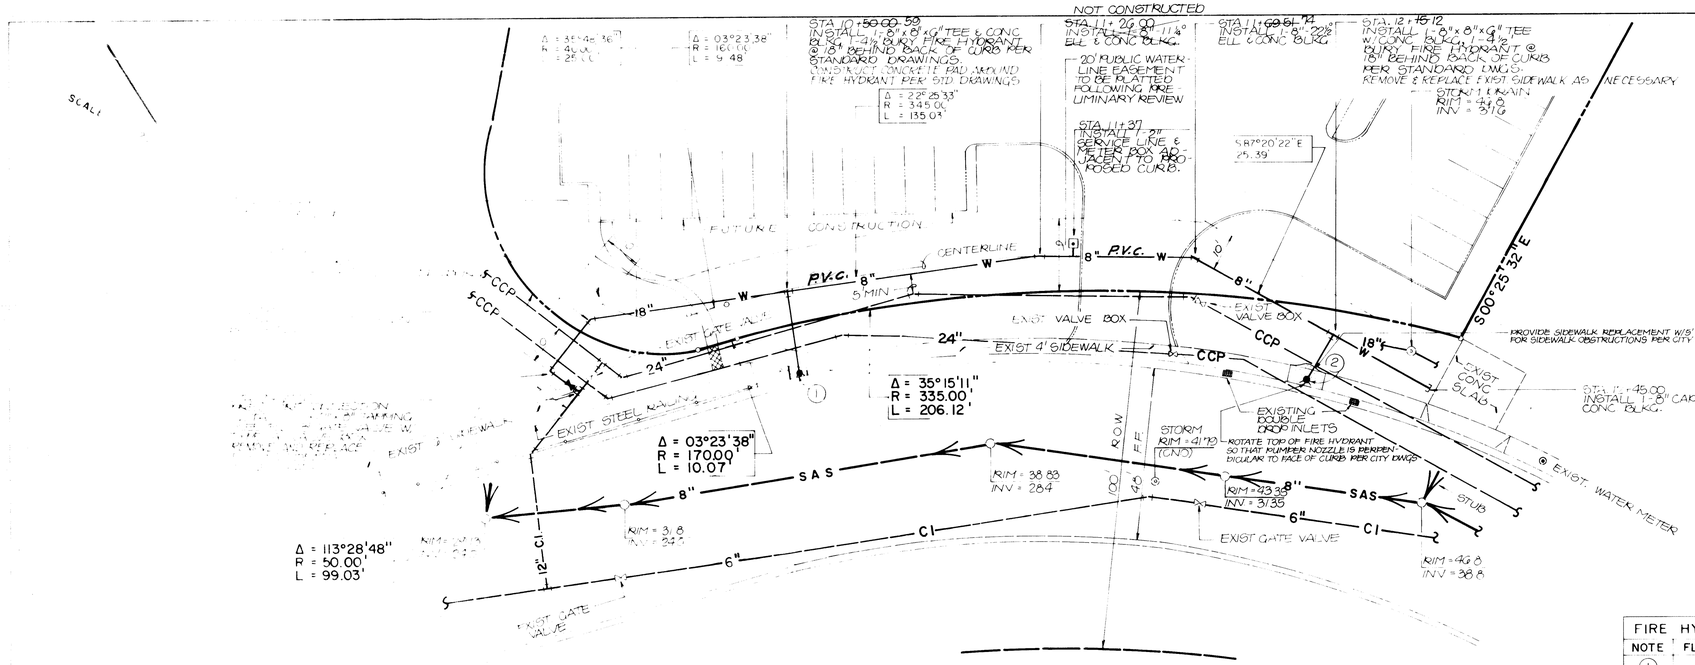

FIRE HYDRANT TABLE	
NOTE	FLANGE ELEVATION
①	~~5736.4~~ 5736.88
②	~~5745.5~~ 5745.78

...ICATES THE "AS-BUILT" CONDITIONS TO THE BEST
...AGE BELIEF. ALL CONDITIONS SHOULD BE FIELD
...H USING THIS DRAWING IN CONJUNCTION WITH FUTURE WORK.

ENCANTADO ROAD N.E.

HORIZONTAL SCALE 1"=20'
VERTICAL SCALE 1"=10'

AS - BUILT

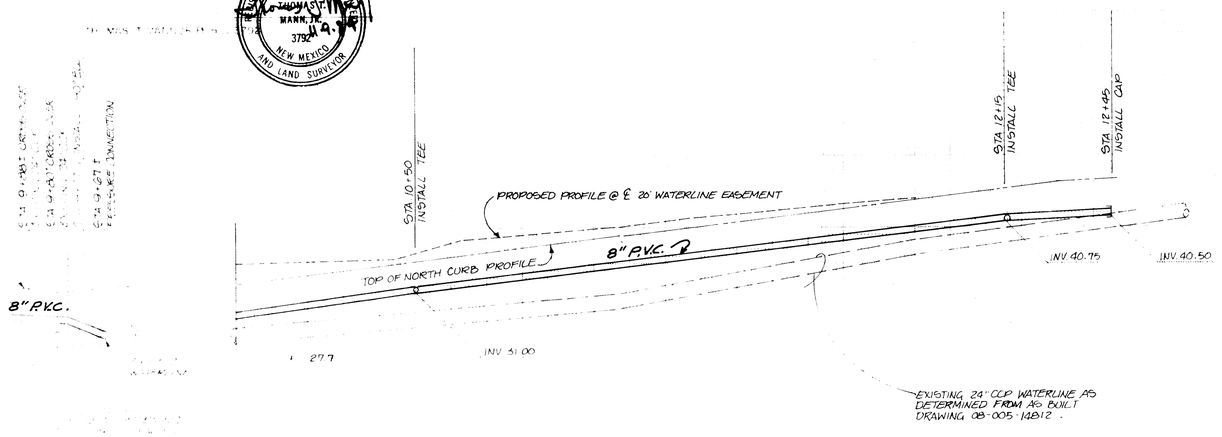

TMA JOB NO. 40133

VICINITY MAP K·23

SCALE 1" = 800'

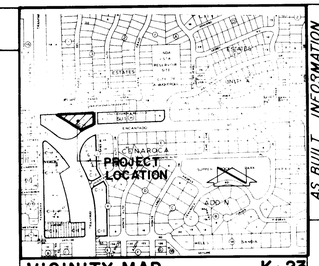

GENERAL NOTES:

1. ALL WORK DETAILED ON THESE PLANS TO BE PERFORMED UNDER CONTRACT SHALL, EXCEPT AS OTHERWISE STATED OR PROVIDED FOR HEREON, SHALL BE CONSTRUCTED IN ACCORDANCE WITH THE NEW MEXICO STANDARD SPECIFICATIONS FOR PUBLIC WORKS CONSTRUCTION - 1979 EDITION (REFERRED TO HEREIN AS THE STANDARD SPECIFICATIONS) AND THE CONTRACT DOCUMENTS FOR PUBLIC WORKS CONTRACT NO. 84-2.
2. TWO (2) WORKING DAYS PRIOR TO ANY EXCAVATION, CONTRACTOR MUST CONTACT LINE LOCATING SERVICE 765-1234, FOR LOCATION OF EXISTING UTILITIES.
3. PRIOR TO CONSTRUCTION, THE CONTRACTOR SHALL EXCAVATE AND VERIFY THE HORIZONTAL AND VERTICAL LOCATION OF ALL POTENTIAL OBSTRUCTIONS. SHOULD A CONFLICT EXIST, THE CONTRACTOR SHALL NOTIFY THE ENGINEER SO THAT THE CONFLICT CAN BE RESOLVED WITH A MINIMUM AMOUNT OF DELAY.
4. THE CONTRACTOR SHALL MAINTAIN ACCESS TO ADJACENT PROPERTIES DURING CONSTRUCTION.
5. ALL WORK ON THIS PROJECT SHALL BE PERFORMED IN ACCORDANCE WITH APPLICABLE FEDERAL, STATE AND LOCAL LAWS, RULES AND REGULATIONS CONCERNING CONSTRUCTION SAFETY AND HEALTH.
6. THE CONTRACTOR MUST SUBMIT A CONSTRUCTION SIGNING AND BARRICADING PLAN TO TRAFFIC ENGINEERING TO RECEIVE A BARRICADING PERMIT PRIOR TO CONSTRUCTION.
7. ALL STATIONING IS BASED ON EASEMENT CENTERLINE.
8. WATER MAIN SHALL BE PVC C-900 PIPE OR AS APPROVED BY THE CITY OF ALBUQUERQUE WATER RESOURCES DIVISION (SEE NOTE 11).
9. WATER LINE SHALL HAVE A MINIMUM COVER OF 4' 0" (TOP OF CURB TO TOP OF PIPE).
10. ELECTRONIC MARKER DISKS (EMD) SHALL BE INSTALLED IN ACCORDANCE WITH THE CITY OF ALBUQUERQUE "CONTRACT DOCUMENTS FOR PUBLIC WORKS CONTRACT NO. 84-2."
11. DUCTILE IRON AND ASBESTOS CEMENT ARE ACCEPTABLE PIPE MATERIALS IN LIEU OF PVC.
12. WHERE REMOVAL OF EXISTING CURB AND GUTTER, SIDEWALK OR PAVEMENT IS REQUIRED, THE CONTRACTOR SHALL SAWCUT AND/OR REMOVE TO THE NEAREST JOINT. CURB AND GUTTER SHOWN AS EXISTING AND NOT TO BE REMOVED UNDER THIS CONTRACT WHICH IS DAMAGED OR DISPLACED BY THE CONTRACTOR SHALL BE REMOVED AND REPLACED BY THE CONTRACTOR AT THE CONTRACTOR'S EXPENSE.
13. ALL PAVING REMOVALS AND REPLACEMENTS SHALL BE PER CURRENT CITY STANDARDS. STREET PAVING IS ARTERIAL.
14. ALL WATER VALVES SHALL BE RESILIENT GATE VALVES OR AS APPROVED BY THE CITY OF ALBUQUERQUE WATER RESOURCES DEPARTMENT.

APPROVAL OF AS BUILT DRAWINGS
ASST. CITY ENGINEER-FIELD
DATE 12-11-84

1	2	3	4	5	6	7	8	9	10	11	12
2	6	2272			0	184					

APPROVED FOR CONSTRUCTION
CITY ENGINEER DATE 12/13/84

BENCH MARKS
AN A.C.S. BENCHMARK, NO 14 K23, A CHISEL ED SQUARE ON TOP OF CONCRETE CURB @ THE NORTH, NORTHWEST RETURN LOCATED IN THE NORTHWEST QUADRANT OF INTERSECTION OF MEL SMITH RD. N.E. AND ENCANTADO RD. N.E.
ELEVATION = 5761.495 (MSLD, 1929)

AS BUILT INFORMATION
CONTRA. No.
INSPECTOR'S ACCEPTANCE BY DATE
FIELD VERIFICATION BY DATE
DRAWINGS CORRECTED BY DATE
MICRO-FILM INFORMATION
RECORDED BY DATE
NO

SURVEY INFORMATION
FIELD NOTES
NO BY DATE

ENGINEER'S SEAL
REGISTERED PROFESSIONAL ENGINEER AND LAND SURVEYOR
STATE OF NEW MEXICO
THOMAS T. MANN, JR.
9792

NO BY DATE REMARKS

CITY OF ALBUQUERQUE
MUNICIPAL DEVELOPMENT DEPARTMENT
ENGINEERING DIVISION

TITLE LOVELACE ENCANTADO WATERLINE EXTENSION

APPROVALS	ENGINEER	DATE	APPROVALS	ENGINEER	DATE
City Engineer			Solid Waste		
A.C.E. Design			Traffic		
~~A.C.E.~~ Hydrology			Water		

DRAWING NO 2272 | MAP NO K·23 | SHEET 1 OF 1