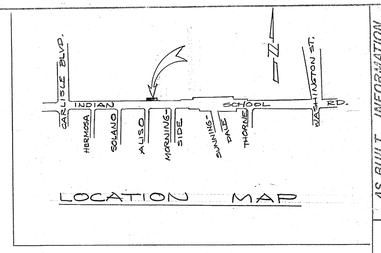

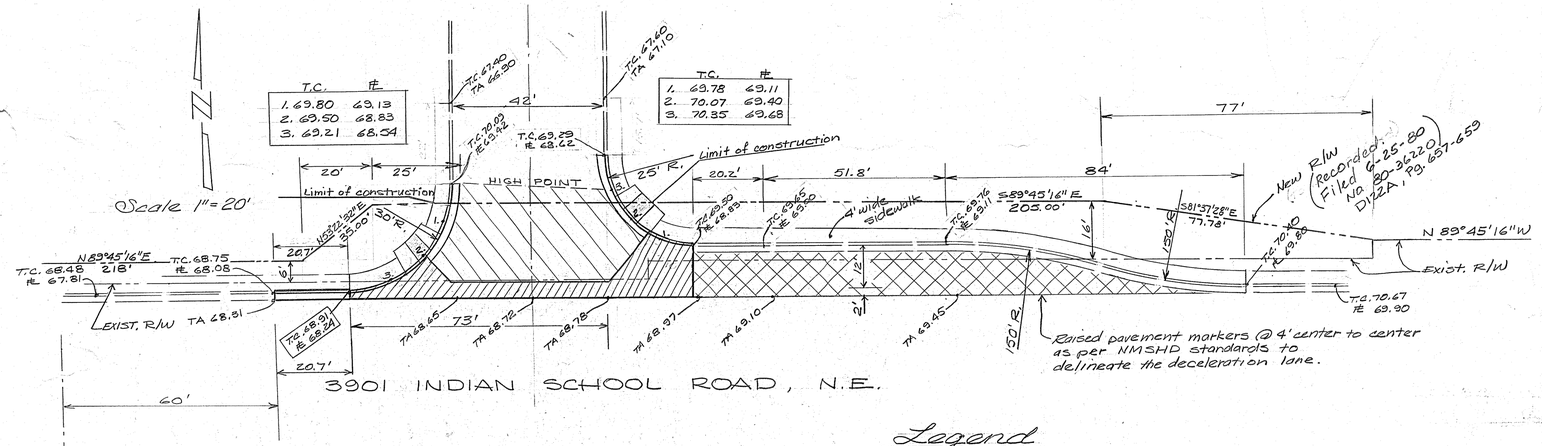

Legend

- PROPOSED STD. CURB & GUTTER
- EXISTING CURB & GUTTER
- PROPOSED VALLEY GUTTER SEE STD. DWG. P-9 FOR CONST. JOINTS
- RESIDENTIAL PAVING
- ARTERIAL PAVING
- STD. WHEEL CHAIR RAMP
- T.C. 65.21 PROPOSED ELEVATION
- T.C. 66.19 EXISTING ELEVATION

1	2	3	4	5	6	7	8	9	10	11	12
2	4		2	2	8		0	1	2	9	

APPROVAL OF AS BUILT DRAWINGS
ASST. CITY ENGINEER - FIELD
DATE 9-16-80

1	2	3	4	5	6	7	8	9	10	11	12
2	0		2	2	8		0	1	2	9	

APPROVED FOR CONSTRUCTION
CITY ENGINEER — DATE 7/3/80

AS BUILT INFORMATION
CONTRACTOR
WORK STAKED BY — DATE
INSPECTORS ACCEPTANCE BY — DATE
FIELD VERIFICATION BY — DATE
COMPUTED BY — DATE
MICRO-FILM INFORMATION
RECORDED BY — DATE
NO.

BENCH MARKS

SURVEY INFORMATION
FIELD NOTES
NO. | BY | DATE

REFERENCES
MAP NO. H-17 | W.O. NO.
EST. NO. P-29-228

NO.	DATE	REMARKS	BY
		REVISIONS	

DESIGNED BY C. TOMLINSON — DATE
DRAWN BY B. EMMETT — DATE
CHECKED BY — DATE

CITY OF ALBUQUERQUE
PUBLIC WORKS DEPARTMENT
ENGINEERING DIVISION

TITLE: DECELERATION LANE AT 3901 INDIAN SCHOOL RD., N.E. & VALLEY GUTTER

APPROVALS	ENGINEER	DATE	APPROVALS	ENGINEER	DATE
City Engineer	Richard S. Stoller	7/3/80	Liquid Waste		
A.C.E.-Design	Chief Inspector	6/25/80	Traffic	Robert A. Sandoval	6/12/80
A.C.E.-Hydrology			Water		

DRAWING NO. P-29-228 — SHEET 1 OF 1

85-0-1-58