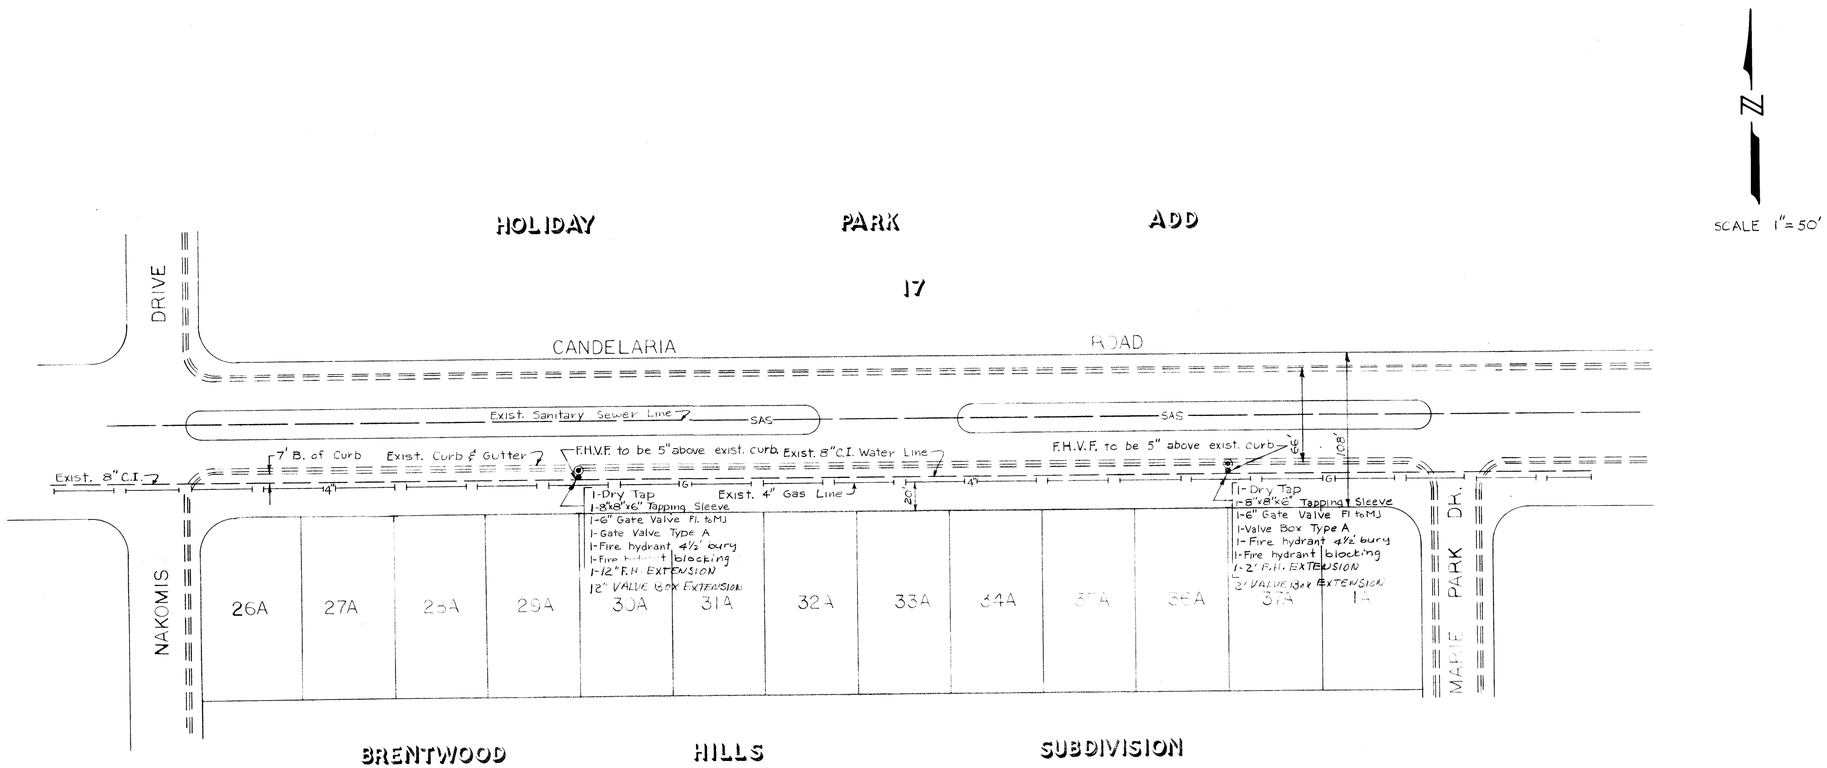

48 HOURS PRIOR TO ANY EXCAVATION, CONTRACTOR MUST CONTACT LINE AND CABLE LOCATING SERVICE 765-1234, FOR LOCATION OF EXISTING UTILITIES.

23 049 01 78

SCANNED BY BY LASON

AS-BUILT INFORMATION	
CONTRACTOR	
WORK ACCEPTED BY	DATE
DRAWING CORRECTED BY	DATE

MICRO-FILM INFORMATION	
RECORDED BY	DATE
NO.	

BENCH MARKS

SURVEY INFORMATION		
FIELD NOTES		
NO.	BY	DATE

REFERENCES	
MAP NO.	H-22
EST. NO.	
W.O. NO.	W-49-78
	W-28-23

NO.	DATE	REMARKS	BY
REVISIONS			

DESIGN

DESIGNED BY C. TOMLINSON DATE 3/31/78
DRAWN BY E. CASAUS DATE 3/31/78
CHECKED BY B. BENNETT DATE 4/3/78

APPROVAL OF AS BUILT DRAWINGS
ASST. CITY ENGINEER-FIELD
DATE 10-6-80

APPROVED FOR CONSTRUCTION
Richard D. Dalle 1/9/79
CITY ENGINEER DATE

CITY OF ALBUQUERQUE
PUBLIC WORKS DEPARTMENT
ENGINEERING DIVISION

TITLE: FIRE HYDRANTS ON CANDELARIA RD. BETWEEN NAKOMIS DR. & MARIE PARK DR.

APPROVALS	ENGINEER	DATE	APPROVALS	ENGINEER	DATE
City Engineer		4-11-78	Liquid Waste		
A.C.E.-Design		4-11-78	Traffic		
A.C.E.-Hydrology			Water		4/4/78

DRAWING NO. W-49-78 SHEET 1 OF 1