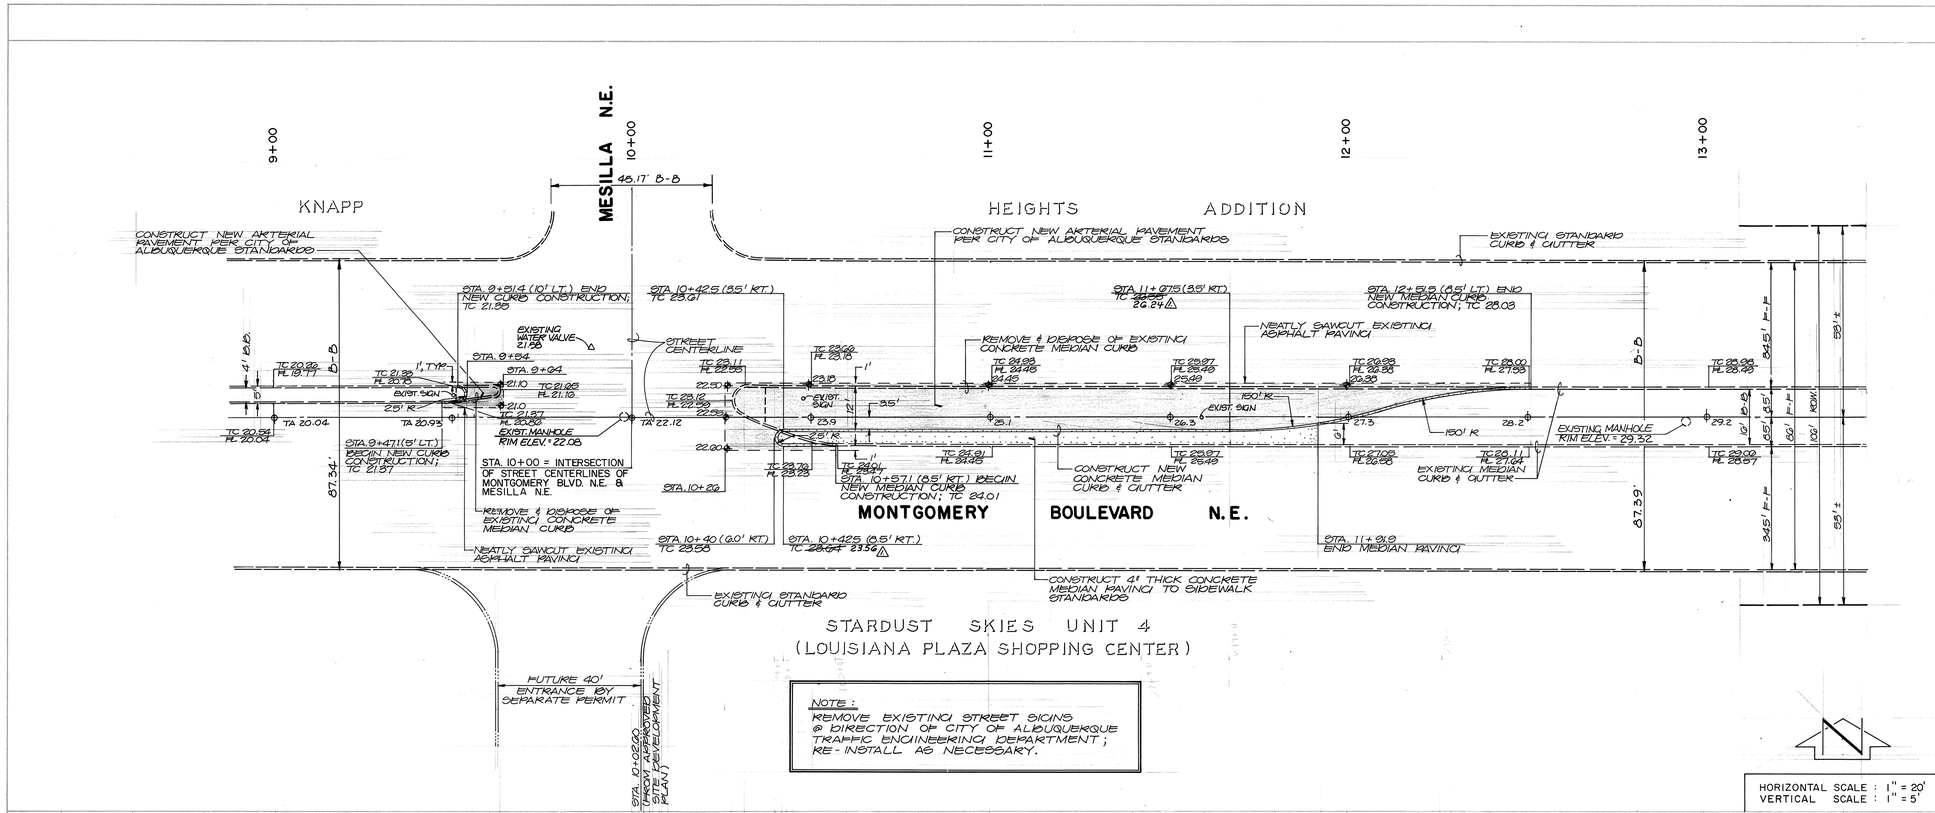

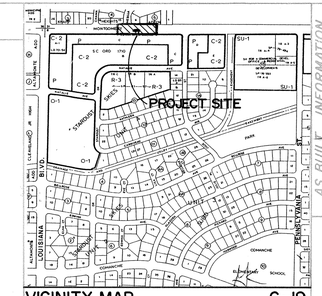

VICINITY MAP G-19

SCALE : 1" = 800'

GENERAL NOTES

1. All work detailed on these plans to be performed under contract shall, except otherwise stated or provided for hereon, be constructed in accordance with the New Mexico Standard Specifications for Public Works Construction - 1979 Edition (referred to herein as the Standard Specifications) and the City of Albuquerque Contract Documents for Public Works Contract No. 85-1.
2. Two working days prior to any excavation, Contractor must contact Line Locating Service, 765-1234, for the location of existing utilities.
3. Prior to construction, the Contractor shall excavate and verify the horizontal and vertical locations of all existing utilities and potential obstructions. Should a conflict exist, the Contractor shall notify the Engineer so that the conflict can be resolved with a minimum amount of delay.
4. The Contractor shall maintain access to adjacent properties at all times.
5. All work on this project shall be performed in accordance with applicable Federal, State and Local laws, rules and regulations concerning construction safety and health.
6. The Contractor must submit a construction signing and barricading plan to Traffic Engineering to receive a barricading permit prior to construction.
7. All slopes as shown on profiles are based on centerline stationing.
8. All dimensions and radii of curb and curb returns are shown to face of curb unless otherwise noted.
9. The centerline has been established as the physical centerline of the street.
10. Where removal of existing curb and gutter, sidewalk or pavement is required, the Contractor shall sawcut and/or remove to the nearest joint. Curb and gutter shown as existing and not to be removed under this contract which is damaged or displaced by the Contractor shall be removed and replaced by the Contractor at the Contractor's expense.

1	2	3	4	5	6	7	8	9	10	11	12
Z	G		2	4	7	0	0	1	8	6	

APPROVAL OF AS BUILT DRAWINGS
ASST. CITY ENGINEER - FIELD
W. H. McNamara
DATE 2-12-86

SCANNED BY LASER

BENCH MARKS
ACS BENCHMARK G-019, A SQUARE CHISELED ON TOP OF CONCRETE CURB @ THE EDGE RETURN @ THE JUNCTION OF MONTGOMERY BLVD. NE & JULE ST. NE
ELEVATION = 5932.12 FEET (MSL D.)

AS BUILT INFORMATION
CONTRACTOR J.R. HALE
WORK STAKED BY
ASBUILTS PREPARED BY E. ROYBAL DATE 2-11-86
FIELD VERIFICATION BY DATE
DRAFTING BY DATE
CORRECTED BY E. NEZ DATE 2-12-86
MICRO-FILM INFORMATION
RECORDED BY DATE
NO.

SURVEY INFORMATION
FIELD NOTES
NO. BY DATE

ENGINEER'S SEAL
JEREMY G. MORRISON NEW MEXICO 5347 REGISTERED PROFESSIONAL ENGINEER

NO.	REMARKS	BY
2	Revision from As-Built Drawings	EMB

REVISIONS

		DATE
DESIGNED BY	TOM MANN & ASSOC.	4/11/85
DRAWN BY	G.G.H. & L.B.D.	4/11/85
CHECKED BY	J.G.M. (21425)	4/11/85

CITY OF ALBUQUERQUE
MUNICIPAL DEVELOPMENT DEPARTMENT
ENGINEERING DIVISION

TITLE:
LOUISIANA PLAZA SHOPPING CENTER
MONTGOMERY BLVD. N.E. - LEFT TURNBAY

APPROVALS	ENGINEER	DATE	APPROVALS	ENGINEER	DATE
City Engineer		4/21/85	Liquid Waste	N.A.	5/29/85
A.C.E.-Design		4/21/85	Traffic		5/29/85
-Hydrology	N.A.	5/29/85	Water	N.A.	5/29/85

APPROVED FOR CONSTRUCTION
CITY ENGINEER 10/15/85 DATE

DRAWING NO. 2470 MAP NO. G-19 SHEET 1 OF 1

21+25