AF 22440A

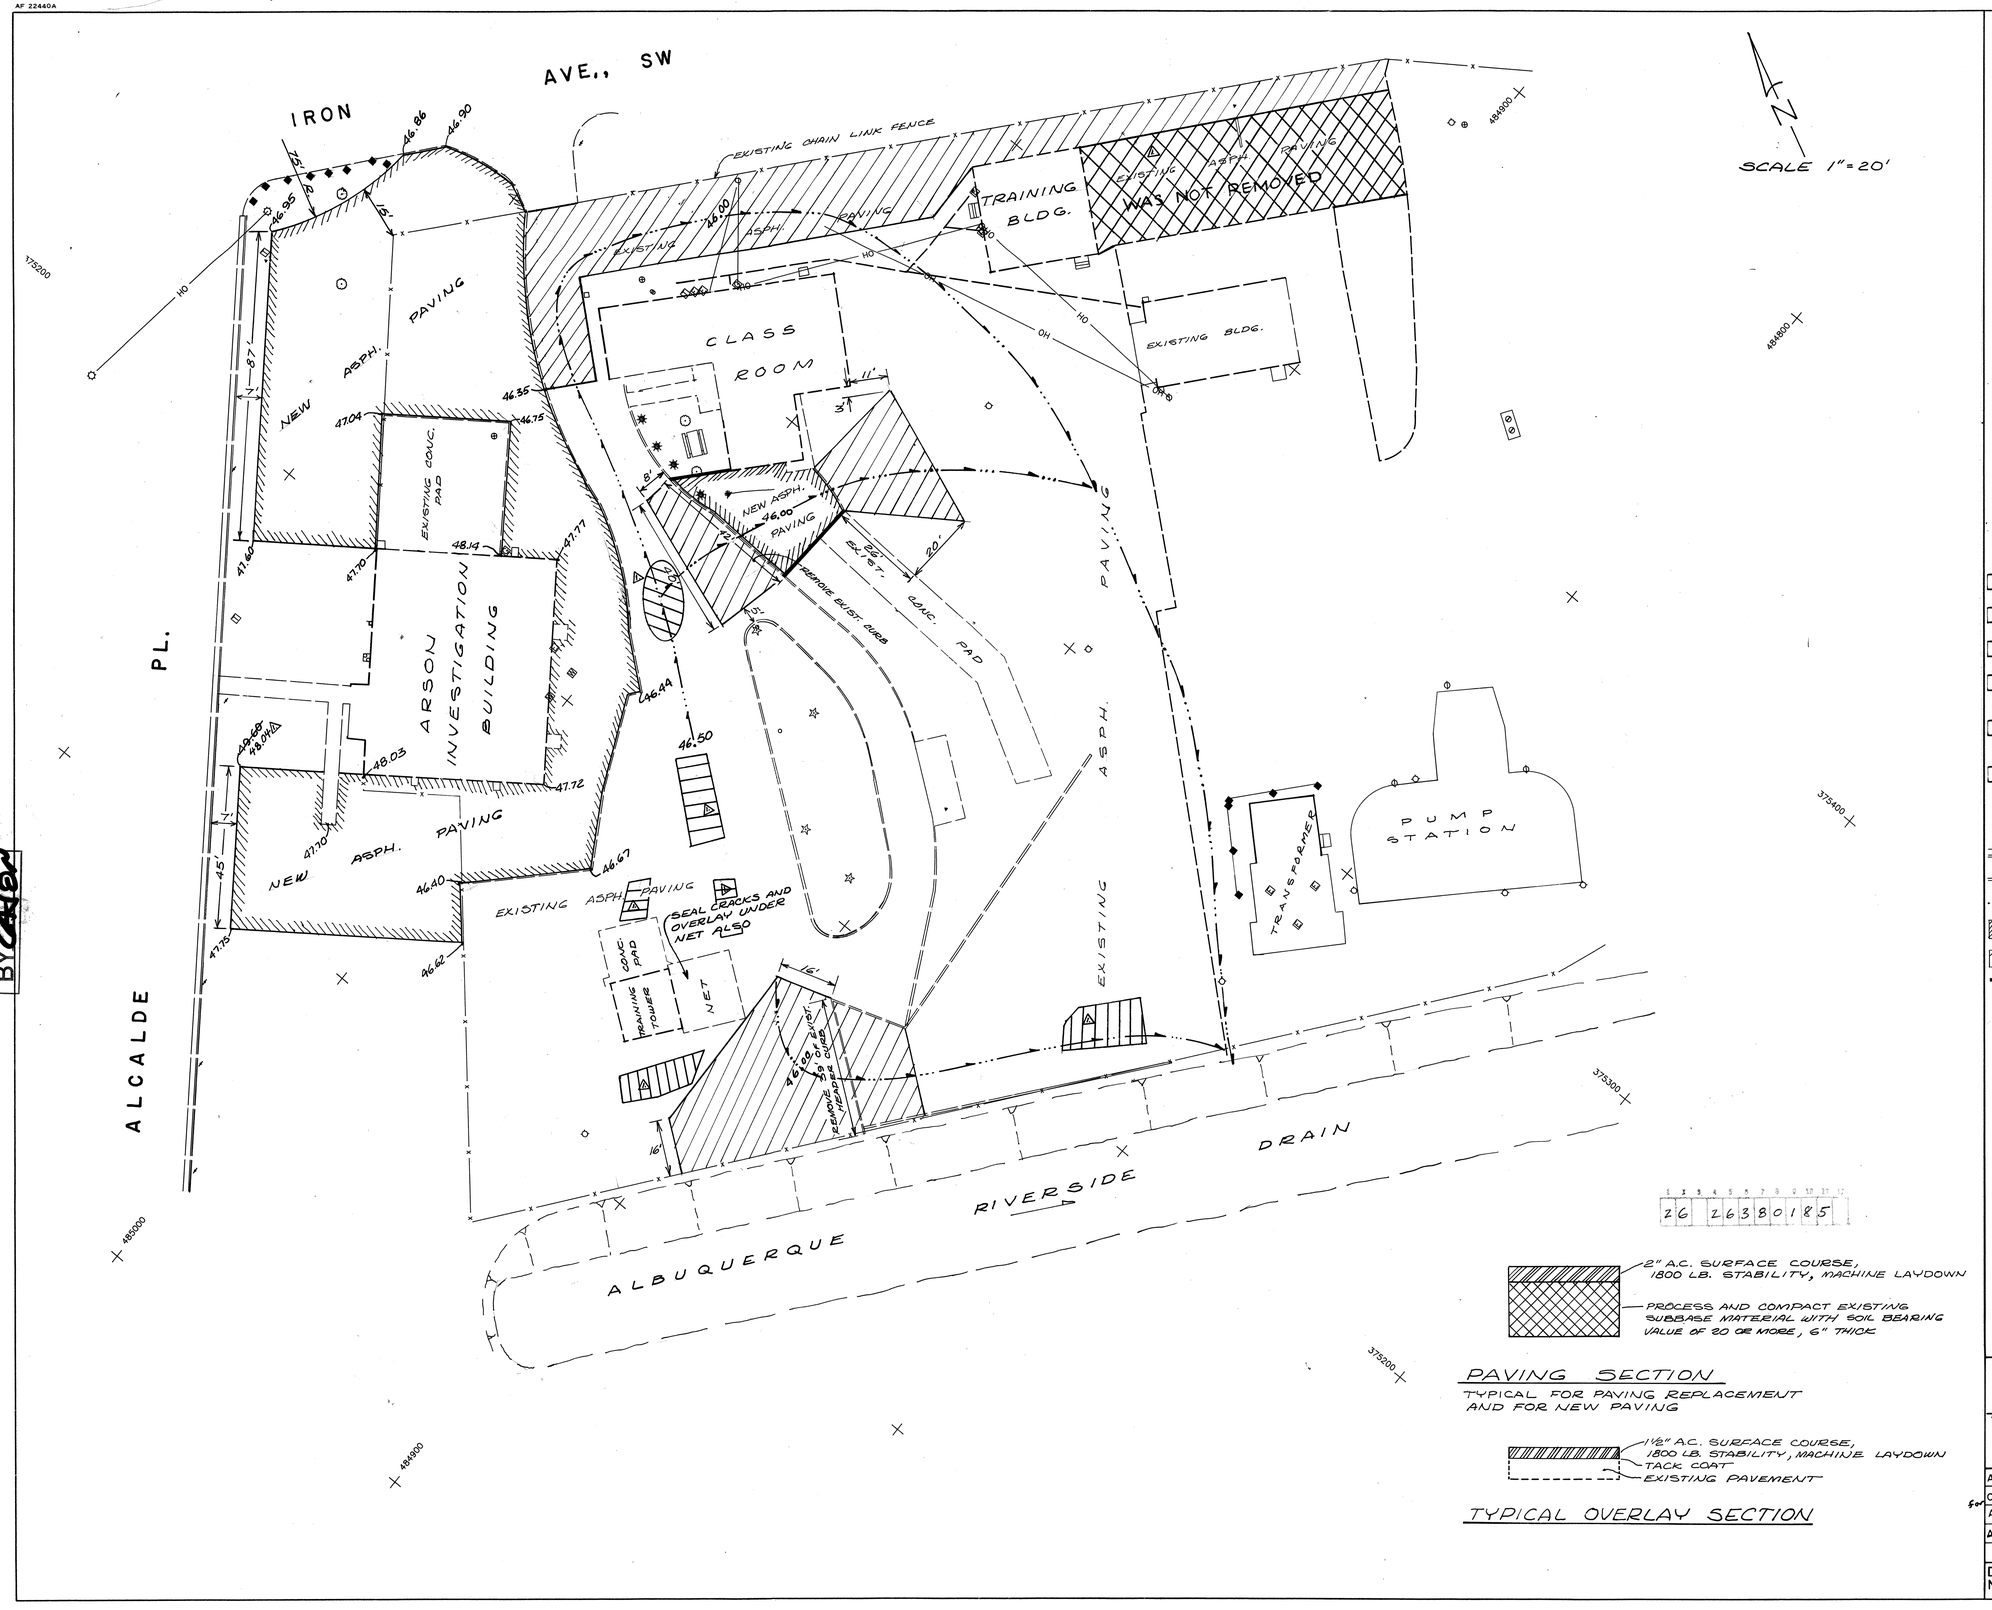

NOTICE TO CONTRACTORS

1. All work detailed on these plans to be performed under contract shall, except as otherwise stated or provided for hereon, be constructed in accordance with the City of Albuquerque Interim Standard Specifications for Construction 1985.
2. Two (2) working days prior to any excavation, the contractor must contact Line Locating Service, 765-1234, for location of existing utilities.
3. Prior to construction, the contractor shall excavate and verify the horizontal and vertical locations of all obstructions. Should a conflict exist, the contractor shall notify the engineer or surveyor so that the conflict can be resolved with minimum amount of delay.

THE FOLLOWING NOTES ALSO APPLY WHEN CHECKED

- ☐ All utilities and utility service lines shall be installed prior to paving.
- ☐ Backfill compaction shall be according to specified street use.
- ☐ Tack coat requirements shall be determined by the City Engineer.
- ☐ Sidewalks and wheelchair ramps within the curb returns shall be constructed wherever a new curb return is constructed.
- ☐ If curb is depressed for a drivepad or a handicap ramp, the drivepad or ramp shall be constructed prior to acceptance of the curb and gutter.
- ☐ All storm drainage facilities shall be completed prior to final acceptance.

LEGEND

- EXIST. STD. C&G
- EXIST. HEADER CURB
- NEW SWALE
- NEW ASPH. PAVING
- REMOVE & REPLACE EXIST. PAVING
- NEW HEADER CURB

NOTE:

NEW PAVEMENT ELEVATIONS TO MATCH EXISTING PAVEMENT WHERE THE TWO PAVING SECTIONS MEET. SPOT ELEVATIONS ARE SHOWN IN THE AREAS WHERE PAVEMENT IS TO BE REMOVED AND REPLACED. THESE ELEVATIONS ARE TO BE USED IN CONJUNCTION WITH THE SYMBOL FOR DRAINAGE SWALE TO LAY OUT A REVISED DRAINAGE PATTERN.

APPROVAL OF AS BUILT DRAWINGS
ASST. CITY ENGINEER - FIELD
W. J. McNamara
DATE 12-24-85

1	2	3	4	5	6	7	8	9	10	11	12
2	6	2	6	3	8	0	1	8	5		

PAVING SECTION
TYPICAL FOR PAVING REPLACEMENT AND FOR NEW PAVING

TYPICAL OVERLAY SECTION

AS BUILT INFORMATION

CONTRACTOR	K.L.C.
WORK STAKED BY	
INSPECTOR'S ACCEPTANCE BY	Reynaldo Garcia DATE 10-14-85
FIELD VERIFICATION BY	DATE
DRAWINGS CORRECTED BY	E. Kiez DATE 12-24-85
MICRO-FILM INFORMATION	
RECORDED BY	DATE
NO.	

BENCH MARKS

ACS BM 6-K13 ELEV. 4956.95
NW COR. TINGLEY DR. & ALCALDE, ACS CAP
CBM1 - "0" CUT ON TOP OF CONC. SLAB ON TRUCK RAMP. ELEV. 4946.91

SURVEY INFORMATION

FIELD NOTES

NO.	BY	DATE
3½" FLOPPY DISK 24958 - ALBUQ. FIRE DEPT ACADEMY	M. GONZALES	9/9/85
9/9/85		

ENGINEER'S SEAL

NO.	DATE	REVISIONS	BY
1	12-24-85	Revision from As Built Drawings	

REMARKS

DESIGNED BY PHIL FISCHER DATE 9/85
DRAWN BY B. EMMETT DATE 9/85
CHECKED BY DATE

CITY OF ALBUQUERQUE
MUNICIPAL DEVELOPMENT DEPARTMENT
ENGINEERING DIVISION

TITLE: PAVING AT FIRE ACADEMY AND ARSON INVESTIGATION BUILDING

APPROVALS	ENGINEER	DATE	APPROVALS	ENGINEER	DATE
City Engineer		12/10/85	Liquid Waste		
A.C.E.- Design			Traffic		
~~A.C.E.~~-Hydrology	Don Hogan	12/21/85	Water	N/A	

DRAWING NO.	MAP NO.	SHEET
2638	K13	1 OF 1

SCANNED BY