


05-ES-20

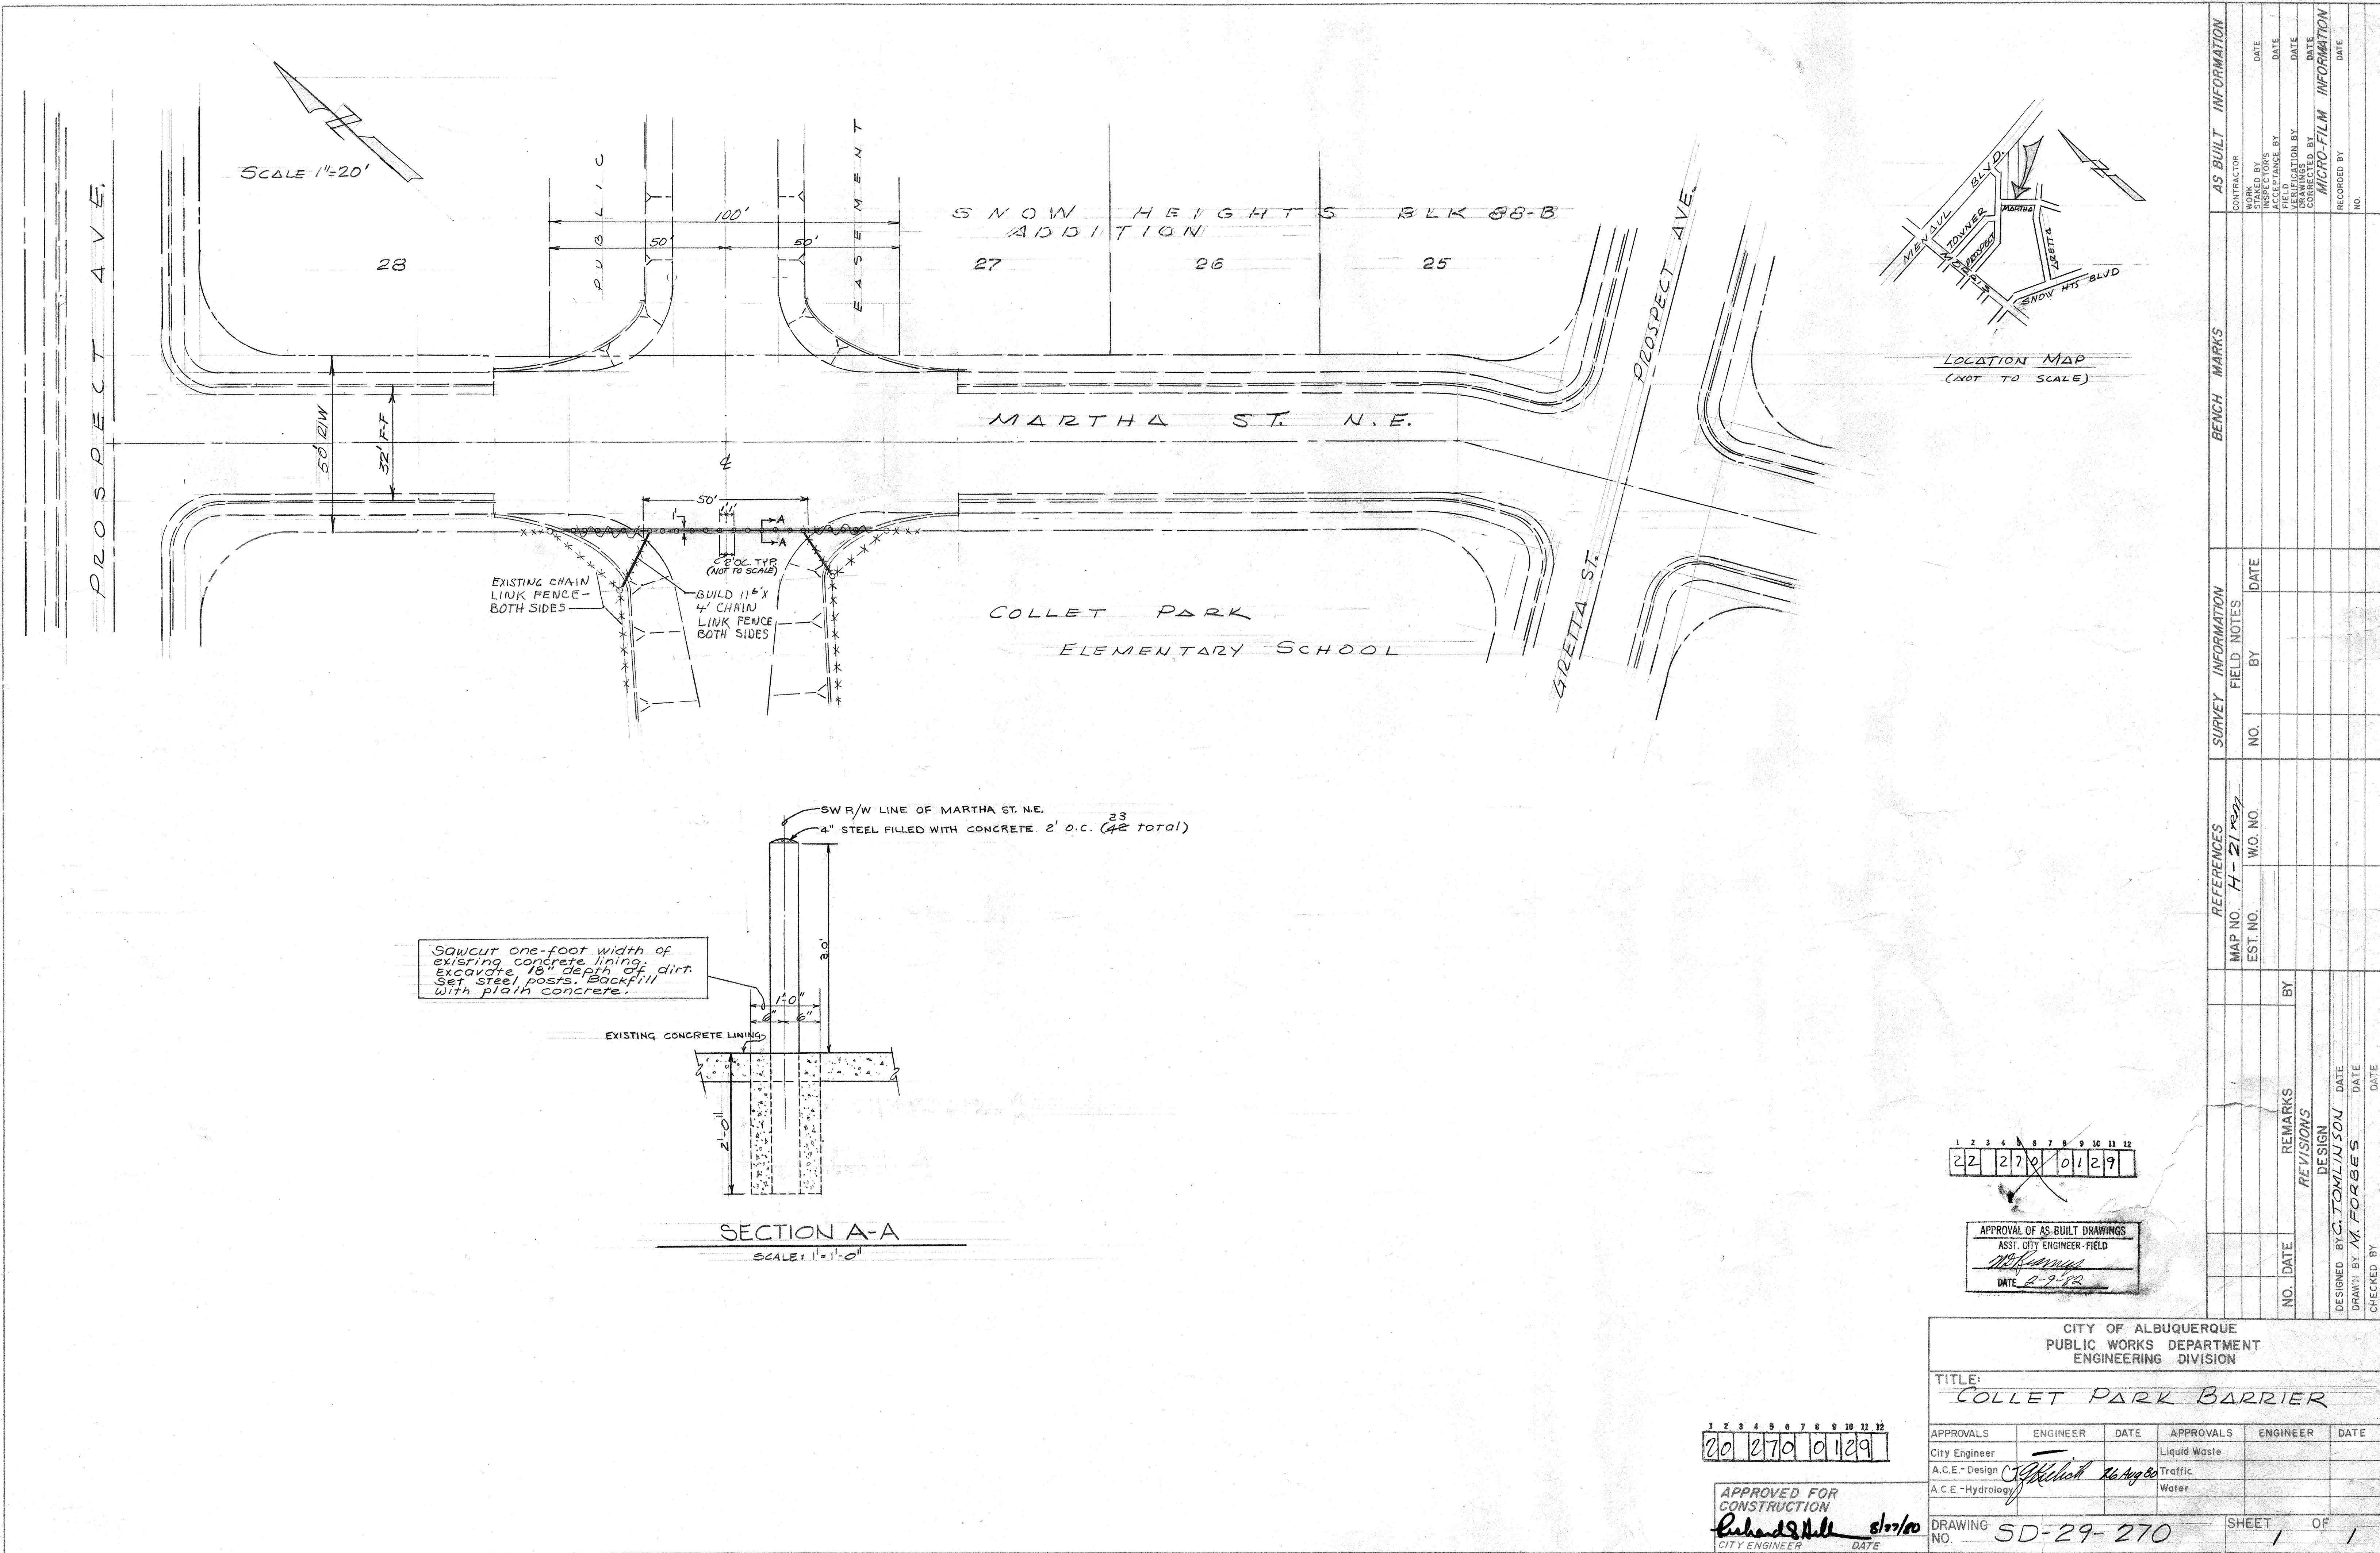

05-ES-20