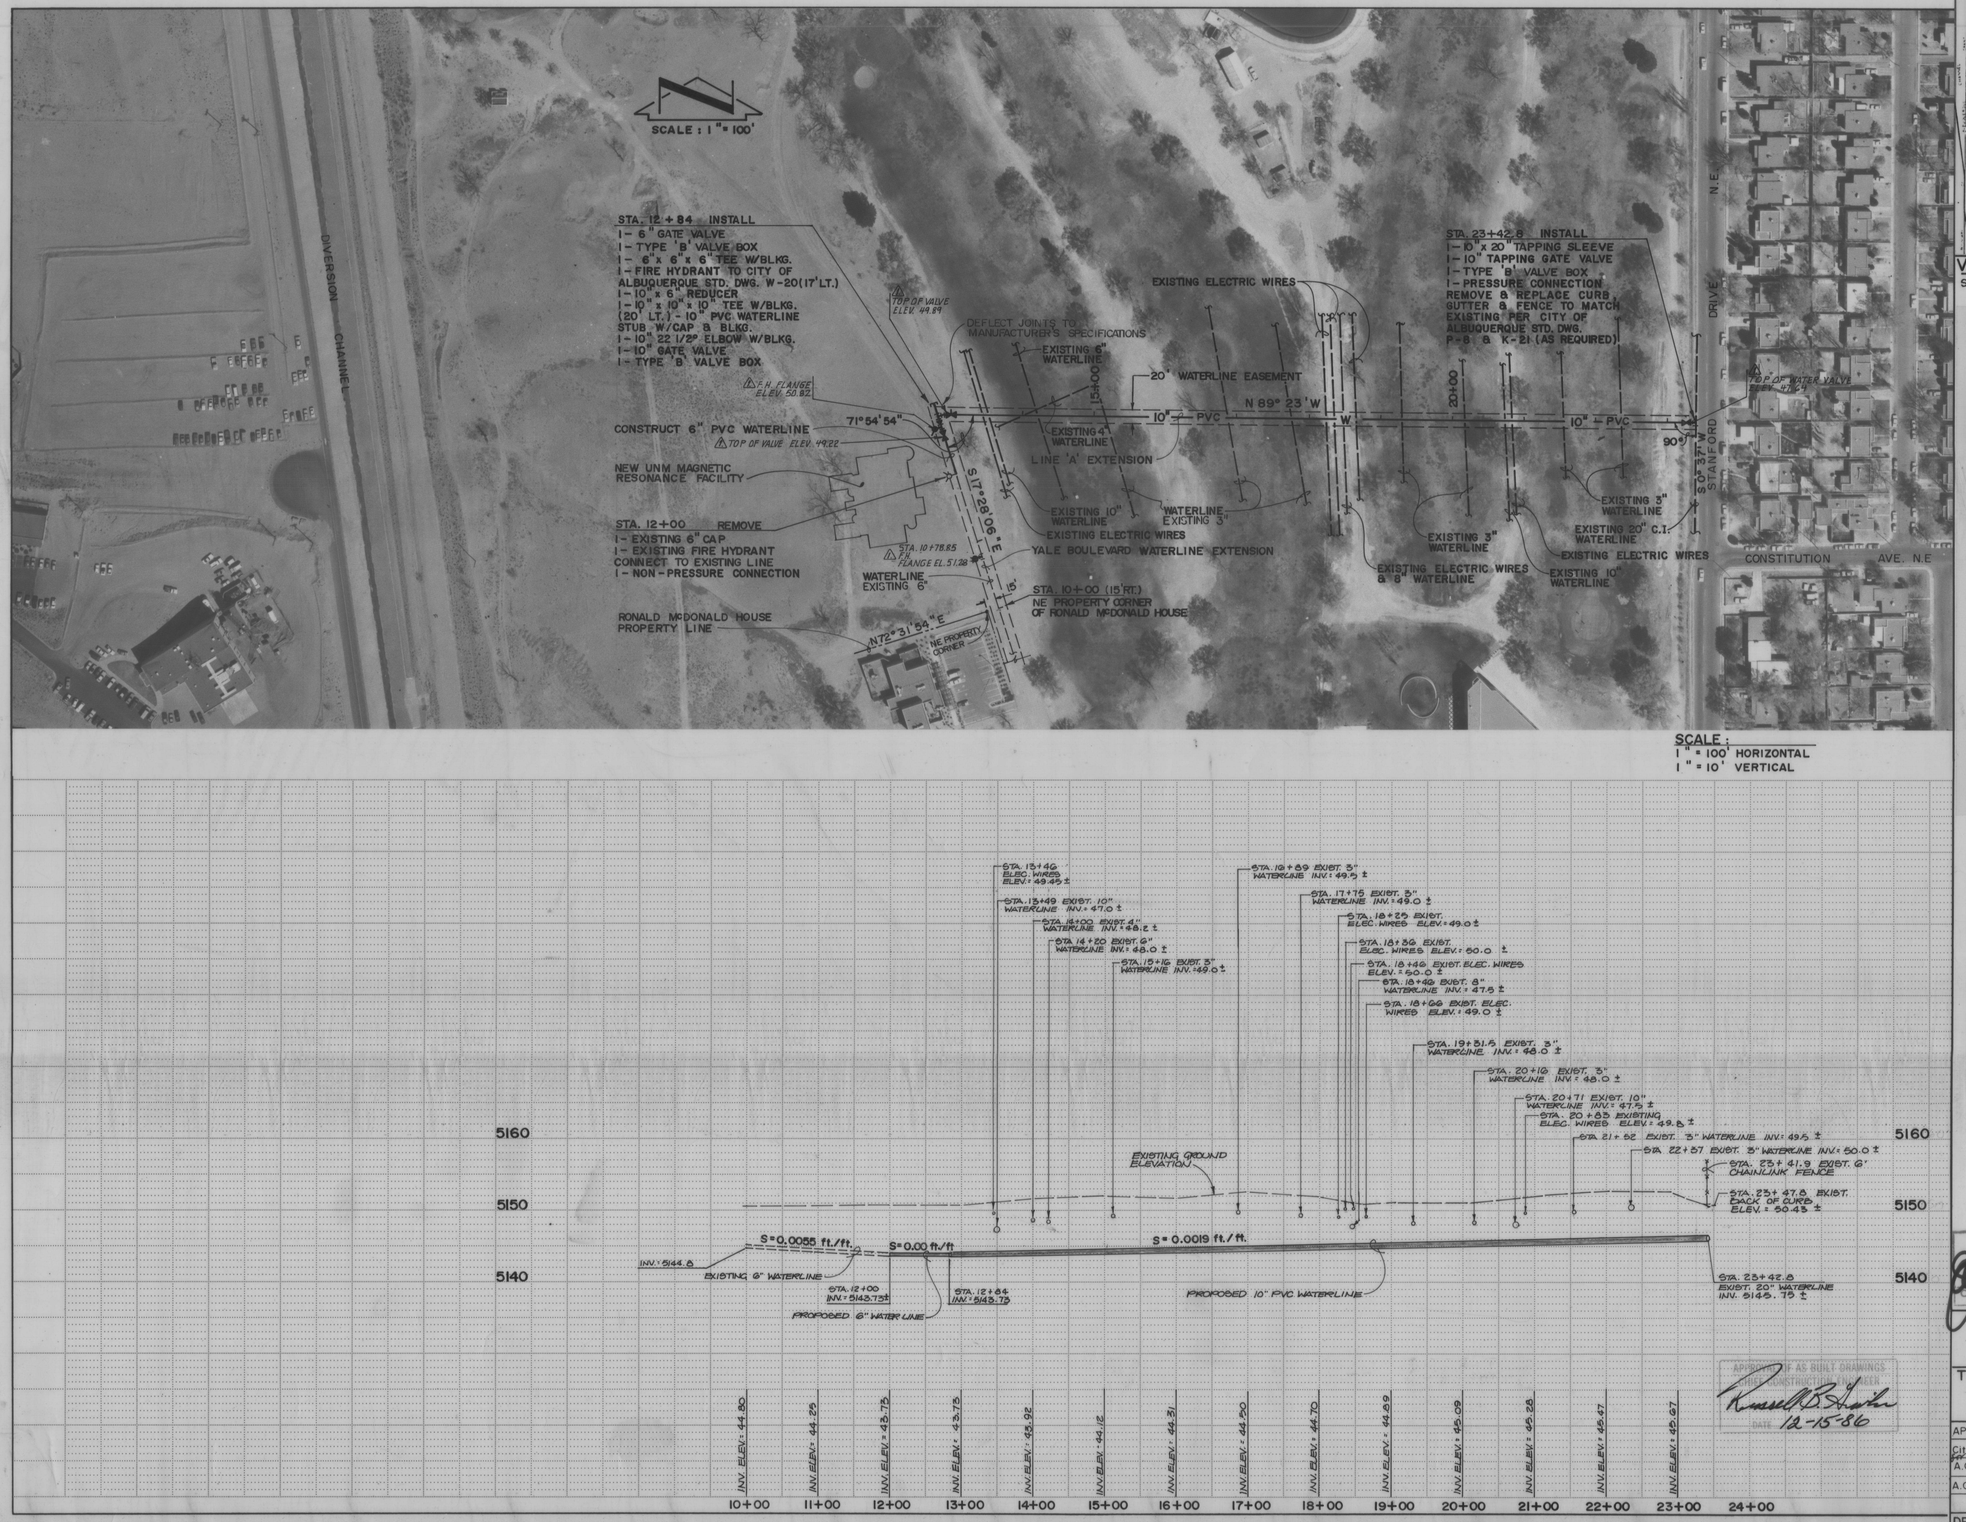

SCALE:
1" = 100' HORIZONTAL
1" = 10' VERTICAL

APPROVAL OF AS BUILT DRAWINGS THIS CONSTRUCTION HAS BEEN REVIEWED FOR GENERAL CONFORMANCE WITH THE DESIGN CONCEPT OF THE PROJECT. DATE 12-15-86

JOB NO. 20083

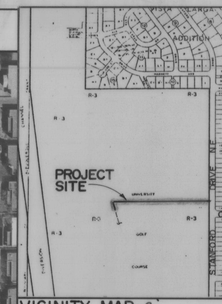

VICINITY MAP J15 & 16
SCALE: 1" = 800'

GENERAL NOTES:

1. ALL WORK DETAILED ON THESE PLANS TO BE PERFORMED UNDER CONTRACT SHALL, EXCEPT AS OTHERWISE STATED OR PROVIDED FOR HEREON, BE CONSTRUCTED IN ACCORDANCE WITH THE CITY OF ALBUQUERQUE INTERIM STANDARD SPECIFICATIONS - PUBLIC WORKS CONSTRUCTION - 1985.
2. TWO (2) WORKING DAYS PRIOR TO ANY EXCAVATION, CONTRACTOR MUST CONTACT LINE LOCATING SERVICE, 765-1234, FOR LOCATION OF EXISTING UTILITIES.
3. PRIOR TO CONSTRUCTION, THE CONTRACTOR SHALL EXCAVATE AND VERIFY THE HORIZONTAL AND VERTICAL LOCATION OF ALL POTENTIAL OBSTRUCTIONS. SHOULD A CONFLICT EXIST, THE CONTRACTOR SHALL NOTIFY THE ENGINEER SO THAT THE CONFLICT CAN BE RESOLVED WITH A MINIMUM AMOUNT OF DELAY.
4. THE CONTRACTOR SHALL MAINTAIN ACCESS TO ADJACENT PROPERTIES DURING CONSTRUCTION.
5. ALL WORK ON THIS PROJECT SHALL BE PERFORMED IN ACCORDANCE WITH APPLICABLE FEDERAL, STATE AND LOCAL LAWS, RULES AND REGULATIONS CONCERNING CONSTRUCTION SAFETY AND HEALTH.
6. THE CONTRACTOR MUST SUBMIT A CONSTRUCTION SIGNING AND BARRICADING PLAN TO TRAFFIC ENGINEERING TO RECEIVE A BARRICADING PERMIT PRIOR TO CONSTRUCTION.
7. ALL STATIONING IS BASED ON STREET CENTERLINE UNLESS INDICATED OTHERWISE.
8. WATER LINE SHALL HAVE A MINIMUM COVER OF 4'-0" TOP OF GROUND TO TOP OF PIPE.
9. ELECTRONIC MARKER DISKS (EMD) SHALL BE INSTALLED IN ACCORDANCE WITH THE CITY OF ALBUQUERQUE "CONTRACT DOCUMENTS FOR PUBLIC WORKS CONTRACT NO 85-1."
10. ONLY ONE FAIRWAY MAY BE SHUT DOWN AT A TIME FOR A MAXIMUM PERIOD OF 3 DAYS.
11. ALL VEHICLES AND CONSTRUCTION ARE TO BE RESTRICTED TO THE EXISTING SERVICE ROADS AND THE 20' WATERLINE EASEMENT SHOWN.
12. CONSTRUCTION OF WATERLINE MUST BE COORDINATED BETWEEN THE CONTRACTOR AND U.N.M. GOLF COURSE ADMINISTRATION, 277-2236.
13. FAIRWAY GRASS WHICH IS REMOVED MUST BE STORED AND REPLACED, THEN MAINTAINED FOR 30 DAYS.
14. CARE MUST BE TAKEN WHEN CONSTRUCTING THE WATERLINE. MOST KNOWN OBSTRUCTIONS ARE SHOWN, BUT UNKNOWN WATERLINES MAY EXIST AND MUST BE REPAIRED AT THE CONTRACTOR'S EXPENSE.

1	2	3	4	5	6	7	8	9	10	11	12
2	6		2	7	4	4	0	1	8	6	

APPROVED FOR CONSTRUCTION
CITY ENGINEER — DATE 12/15/86

AS BUILT INFORMATION
CONTRACTOR SHAMROCK FIVE
WORK BY
INSPECTORS
ACCEPTANCE BY — DATE
FIELD VERIFICATION BY J. ROMERO DATE 12/5/86
DRAWINGS CORRECTED BY E.N. DATE 12/10/86
MICRO-FILM INFORMATION
RECORDED BY — DATE
NO.

BENCH MARKS
STA. 6-1G BRASS TABLET SET FLUSH WITH GROUND 2.0 FT. BEHIND BACK OF CURB. 1.3 FT. NORTH, 22 FT. WEST OF THE INTERSECTION OF STANFORD DRIVE AND CONSTITUTION AVENUE NE.
ELEVATION = 5155.18 FEET (M.S.L.D.)

SURVEY INFORMATION
FIELD NOTES

NO.	BY	DATE

ENGINEER'S SEAL
STATE OF NEW MEXICO — REGISTERED PROFESSIONAL ENGINEER — THOMAS T. HUEM, JR.

NO.	DATE	REMARKS	BY
1	12-10-86	REVISION FROM AS-BUILT INFORMATION	E.N.

REVISIONS

DESIGNED BY	RHD	DATE 12/85
DRAWN BY	SGH	DATE 12/85
CHECKED BY	TTM	DATE 12/85

CITY OF ALBUQUERQUE
MUNICIPAL DEVELOPMENT DEPARTMENT
ENGINEERING DIVISION

TITLE:
YALE WATERLINE EXTENSION
UNM NORTH CAMPUS

APPROVALS	ENGINEER	DATE	APPROVALS	ENGINEER	DATE
City Engineer		4/3/86	Liquid Waste	N/A BR	1-15-86
A.C.E.-Design		1/15/86	Traffic	N/A DOP	1-15-86
A.C.E.-Hydrology		1/15/86	Water	B Rich	1-15-86

DRAWING NO. 2744 | MAP NO. J15 & 16 | SHEET 1 OF 1

PHOTOGRAPHY & PHOTO REPRODUCTION BY KOOGLE & POULS ENGINEERING
EXTRA COMMERCIAL N.E. ALBUQUERQUE, N.M. 87112