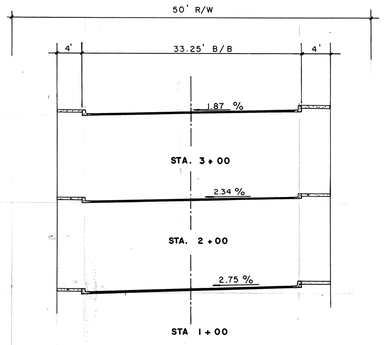

STREET X-SECTIONS

VICINITY MAP L-20-Z

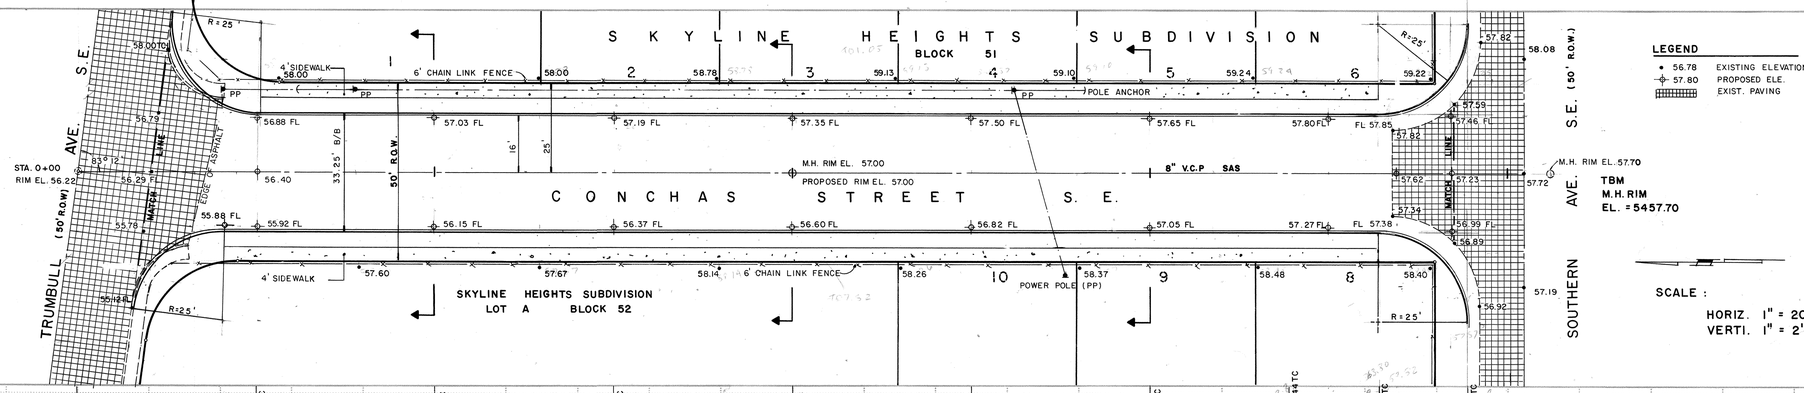

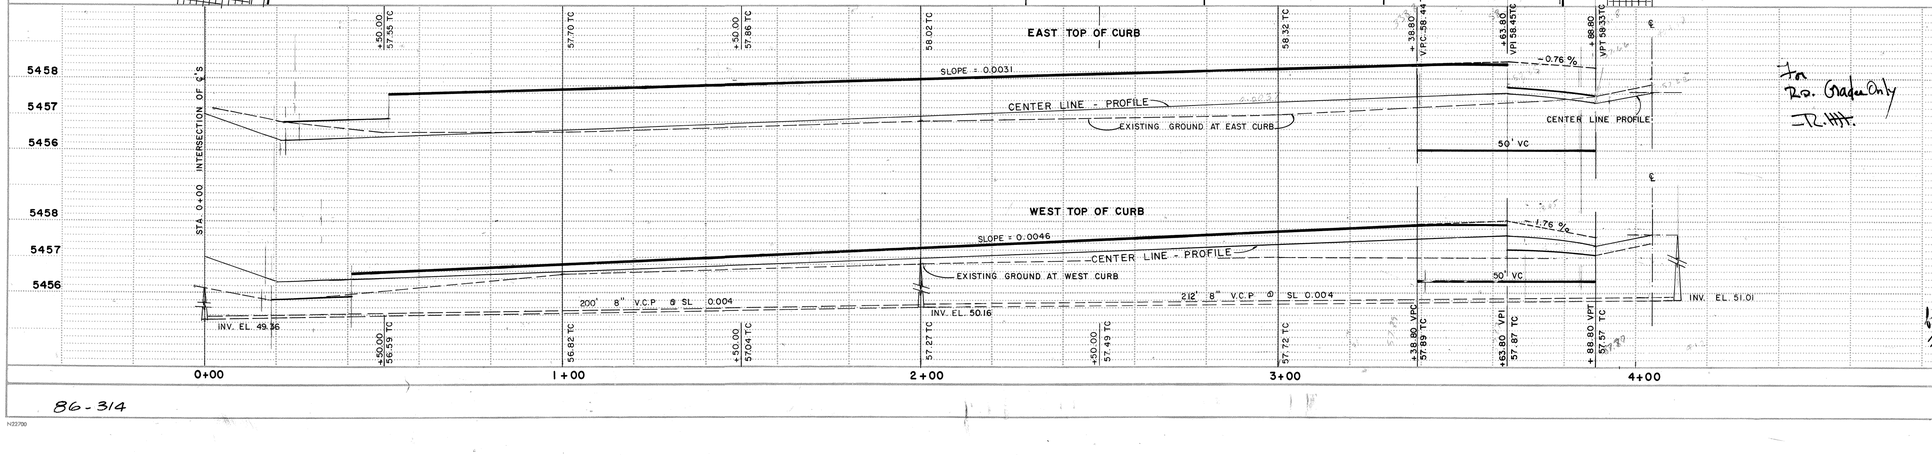

For Rd. Grade Only
-RHH.

NOTICE TO CONTRACTORS:

1) City of Albuquerque Interim Standards Specifications Public Works Construction 1985 Edition will be referred to herein as the standard specifications.

2) All work detailed on these plans to be performed under contract shall, except as otherwise stated or provided for hereon, be constructed in accordance with City of Albuquerque Interim Standard Specifications Public Works Construction 1985 Edition.

3) Two working days prior to any excavation the contractor must contact line location service, 765-1234, for location of existing utilities.

4) Prior to construction, the contractor shall excavate and verify the horizontal and vertical location of all obstructions. Should a conflict exist the contractor shall notify the engineer or surveyor so that the conflict can be resolved with a minimum of delay.

THE FOLLOWING NOTES APPLY IF CHECKED:

[✓] All utilities and utility service lines shall be installed prior to paving.
[ ] Backfill compaction shall be according to arterial street use.
[ ] Tack coat requirements shall be determined by the City Engineer.
[ ] Sidewalk and wheelchair ramps within the curb returns shall be constructed wherever a new curb return is constructed.
[ ] If a curb is depressed for a drivepad, the drivepad shall be constructed prior to acceptance of curb and gutter.

NOTE:
PROJECT BEING BUILT UNDER S.A.D. 217 (3142)

FOR INFORMATION ONLY

2/6 2/8 10/9/0/1/8/8

SURVEY INFORMATION
FIELD NOTES
NO. BY DATE

BENCH MARKS
U.S.C.E. BRASS CAP "SUSAN" LOCATED AT THE NORTHWEST CORNER OF THE INTERSECTION OF SOUTHERN AVE. AND GARCIA ST. SE. EL. 5444.49

AS BUILT INFORMATION
CONTRACTOR
WORK STARTED BY DATE
WORK COMPLETED BY DATE
ACCEPTANCE BY DATE
FIELD VERIFICATION BY DATE
AS-BUILTS DRAWINGS CORRECTED BY DATE
MICRO-FILM INFORMATION
RECORDED BY DATE
NO.

ENGINEER'S SEAL
DAVID V. HALL
NEW MEXICO
7918
REGISTERED PROFESSIONAL ENGINEER

REVISIONS
NO. DATE BY
DESIGN 7/11/86 PE
DESIGNED BY PE
DRAWN BY PE 7/11/86
CHECKED BY RH 7/11/86

CITY OF ALBUQUERQUE
MUNICIPAL DEVELOPMENT DEPARTMENT
ENGINEERING DIVISION

TITLE: PROPOSED STREET GRADE
CONCHAS ST. SE
FROM TRUMBULL AVE. SE TO SOUTHERN AVE. SE

APPROVALS	ENGINEER	DATE	APPROVALS	ENGINEER	DATE
City Engineer		7/31/86	Liquid Waste	N/A	7/23/86
C.E.-Design		7/31/86	Traffic		7/31/86
C.E.-Hydrology		7/31/86	Water	N/A	7/23/86

DRAWING NO. 2809
MAP NO. L-20-Z
SHEET 1 OF 1

86-314

SCANNED BY JASON

N22700