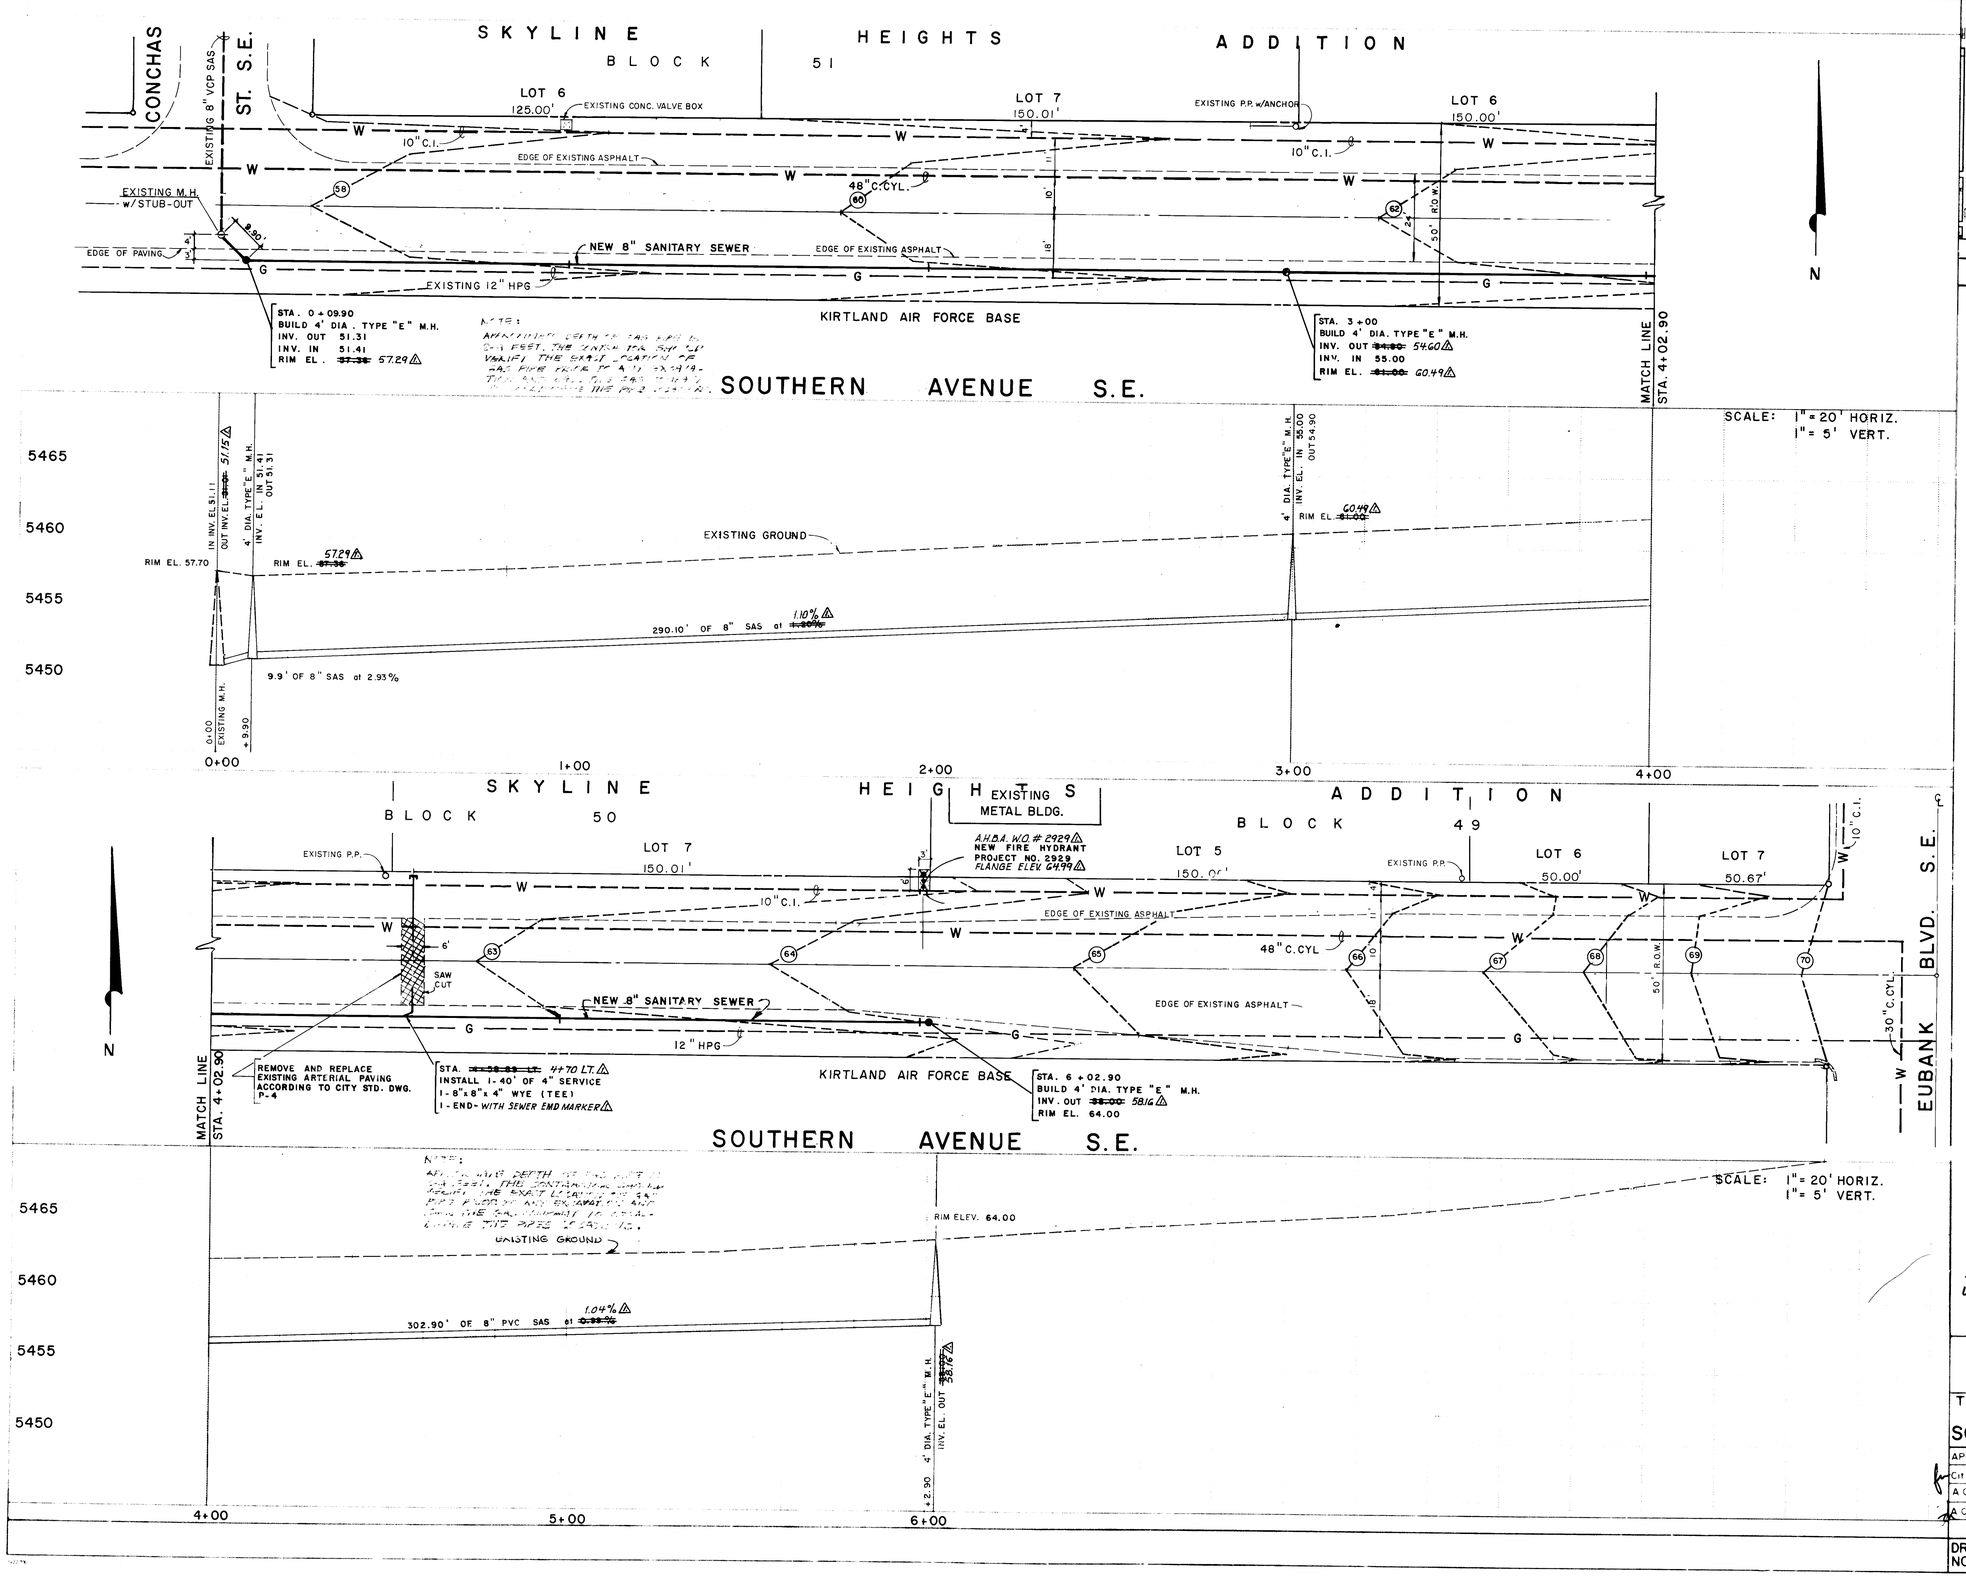

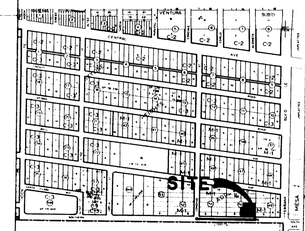

VICINITY MAP L-20-Z

NOTICE TO CONTRACTORS:

1) City of Albuquerque Interim Standards Specifications Public Works Construction 1985 Edition will be referred to herein as the standard specifications.

2) All work detailed on these plans to be performed under contract shall, except as otherwise stated or provided for hereon, be constructed in accordance with City of Albuquerque Interim Standard Specifications Public Works Construction 1985 Edition.

3) Two working days prior to any excavation the contractor must contact line location service, 765-1234, for location of existing utilities.

4) Prior to construction, the contractor shall excavate and verify the horizontal and vertical location of all obstructions. Should a conflict exist the contractor shall notify the engineer or surveyor so that the conflict can be resolved with a minimum of delay.

THE FOLLOWING NOTES APPLY IF CHECKED:

[✓] All utilities and utility service lines shall be installed prior to paving.
[✓] Backfill compaction shall be according to residential street use.
[✓] Tack coat requirements shall be determined by the City Engineer.
[ ] Sidewalk and wheelchair ramps within the curb returns shall be constructed wherever a new curb return is constructed.
[ ] If a curb is depressed for a drivepad, the drivepad shall be constructed prior to acceptance of curb and gutter.

TRAFFIC HANDLING NOTES

1) Contractor must submit a construction signing and barricading plan to Traffic Engineering Section and receive a barricading permit prior to construction.

2) All construction signing and barricading to comply with manual on Uniform Traffic Control Devices, 1978 Edition and subsequent revisions.

AS BUILT INFORMATION
Name of Pride Construction
As Built by City
Inspector's Check 6/18/87
As Built Range by S.E. MOYA 6/18/87
Certification of Completion by EN
Date 9/30/87
Corrected by MICRO-FILM INFORMATION
Recorded by
Date
No

BENCH MARKS
STA. NM ACS "S-L20", A SQUARE, , CHISELED ON TOP OF THE CONCRETE BASE OF A METALIC POWERLINE PYLON LOCATED, 55' WEST OF THE CENTERLINE OF EUBANK BLVD., 0.45 MILES SOUTH OF THE INTERSECTION OF CENTRAL AVE.

SURVEY INFORMATION
FIELD NOTES
NO. BY DATE

ENGINEER'S SEAL
REGISTERED PROFESSIONAL ENGINEER
RICHARD V. HALL
NEW MEXICO

NO.	DATE	REMARKS	BY
1	9-30-87	Revised from as-built information	EN

REVISIONS
DESIGN
DATE
DESIGNED BY
DRAWN BY
CHECKED BY

1	2	3	4	5	6	7	8	9	10	11	12
2	G	2	9	3	0	0	1	8	7		

REVISED AS BUILT DRAWINGS
CITY ENGINEER
Russell D. Stucker
DATE 10-8-87

Richard Hall FOR WALT NICKERSON 5/20/87
DATE

CITY OF ALBUQUERQUE
MUNICIPAL DEVELOPMENT DEPARTMENT
ENGINEERING DIVISION

TITLE: SEWER PLAN AND PROFILE
SOUTHERN AVE. & CONCHAS ST. INTERSECTION

APPROVALS	ENGINEER	DATE	APPROVALS	ENGINEER	DATE
City Engineer		10/9/86	Liquid Waste		8/3/86
A.C.E.-Design		8/27/86	Traffic		8/13/86
A.C.E.-Hydrology		8/27/86	Water		8/3/86

DRAWING NO.	MAP NO.	SHEET	OF
2930	L-20-Z	1	1

86-348