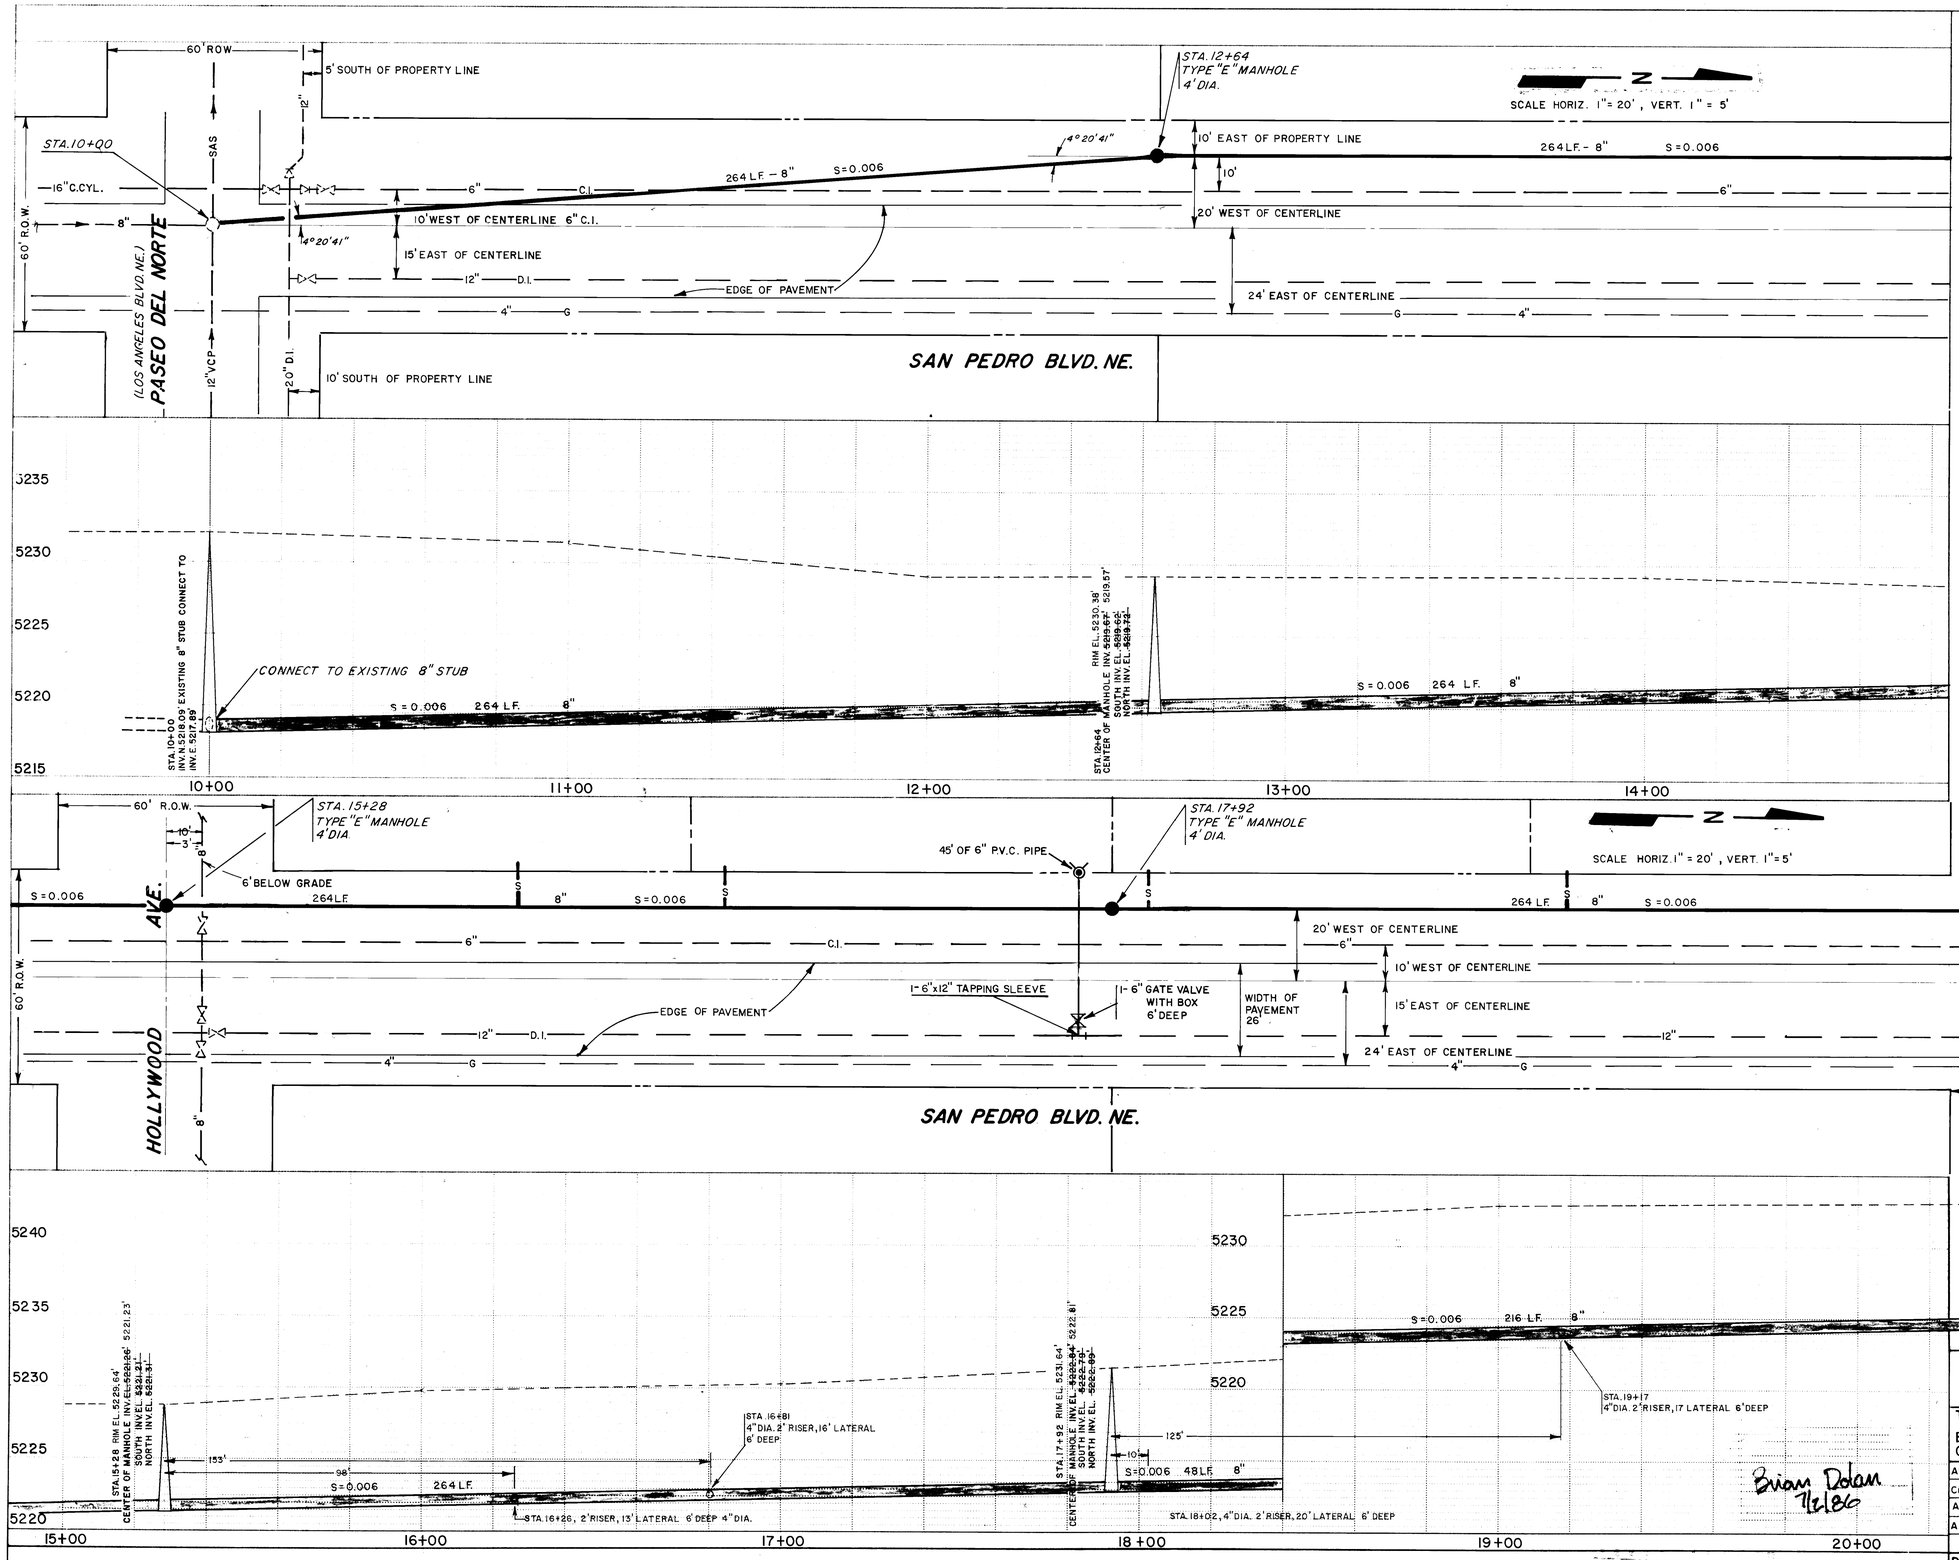

26 29910188

SURVEY INFORMATION		
FIELD NOTES		
NO	BY	DATE

BENCH MARKS

11-D18 BRASS CAP, 69.00 FEET SOUTH OF CENTERLINE OF PASEO DEL NORTE (LOS ANGELES BLVD.NE.) & 30.50 FEET EAST OF CENTERLINE OF SAN PEDRO BLVD.NE.

ELEVATION 5235.63'

AS BUILT INFORMATION

NOTHING TO SUNDANCE
AS-BUILT BY SUNDANCE DATE MAY 86
INSPECTED BY WATER DEPT. DATE MAY 86
ACCEPTED BY WATER DEPT. DATE
VERIFICATION BY DATE
DRAWINGS CORRECTED BY DATE
MICRO-FILM INFORMATION
RECORDED BY DATE
NO.

ENGINEER'S SEAL

WALTER W. NICKERSON
NEW MEXICO
PROFESSIONAL ENGINEER

NO	DATE	REMARKS	BY

REVISIONS

DESIGN

DESIGNED BY A.T. OSTAPACK DATE 13 MARCH 86
DRAWN BY A.T. OSTAPACK DATE 13 MARCH 86
CHECKED BY DATE

CITY OF ALBUQUERQUE
WATER UTILITIES DEPARTMENT
ENGINEERING DIVISION

TITLE: SANITARY SEWER EXTENSION WITHIN SAN PEDRO BLVD. NE. BTW PASEO DEL NORTE (LOS ANGELES BLVD) & CARMEL AVE NE.

APPROVALS	ENGINEER	DATE	APPROVALS	ENGINEER	DATE
City Engineer			Liquid Waste		
A C E - Design			Traffic		
A C E - Hydrology			Water		

Brian Dolan 7/2/86

DRAWING NO.	MAP NO.	SHEET	OF
2991	C-18	1	1