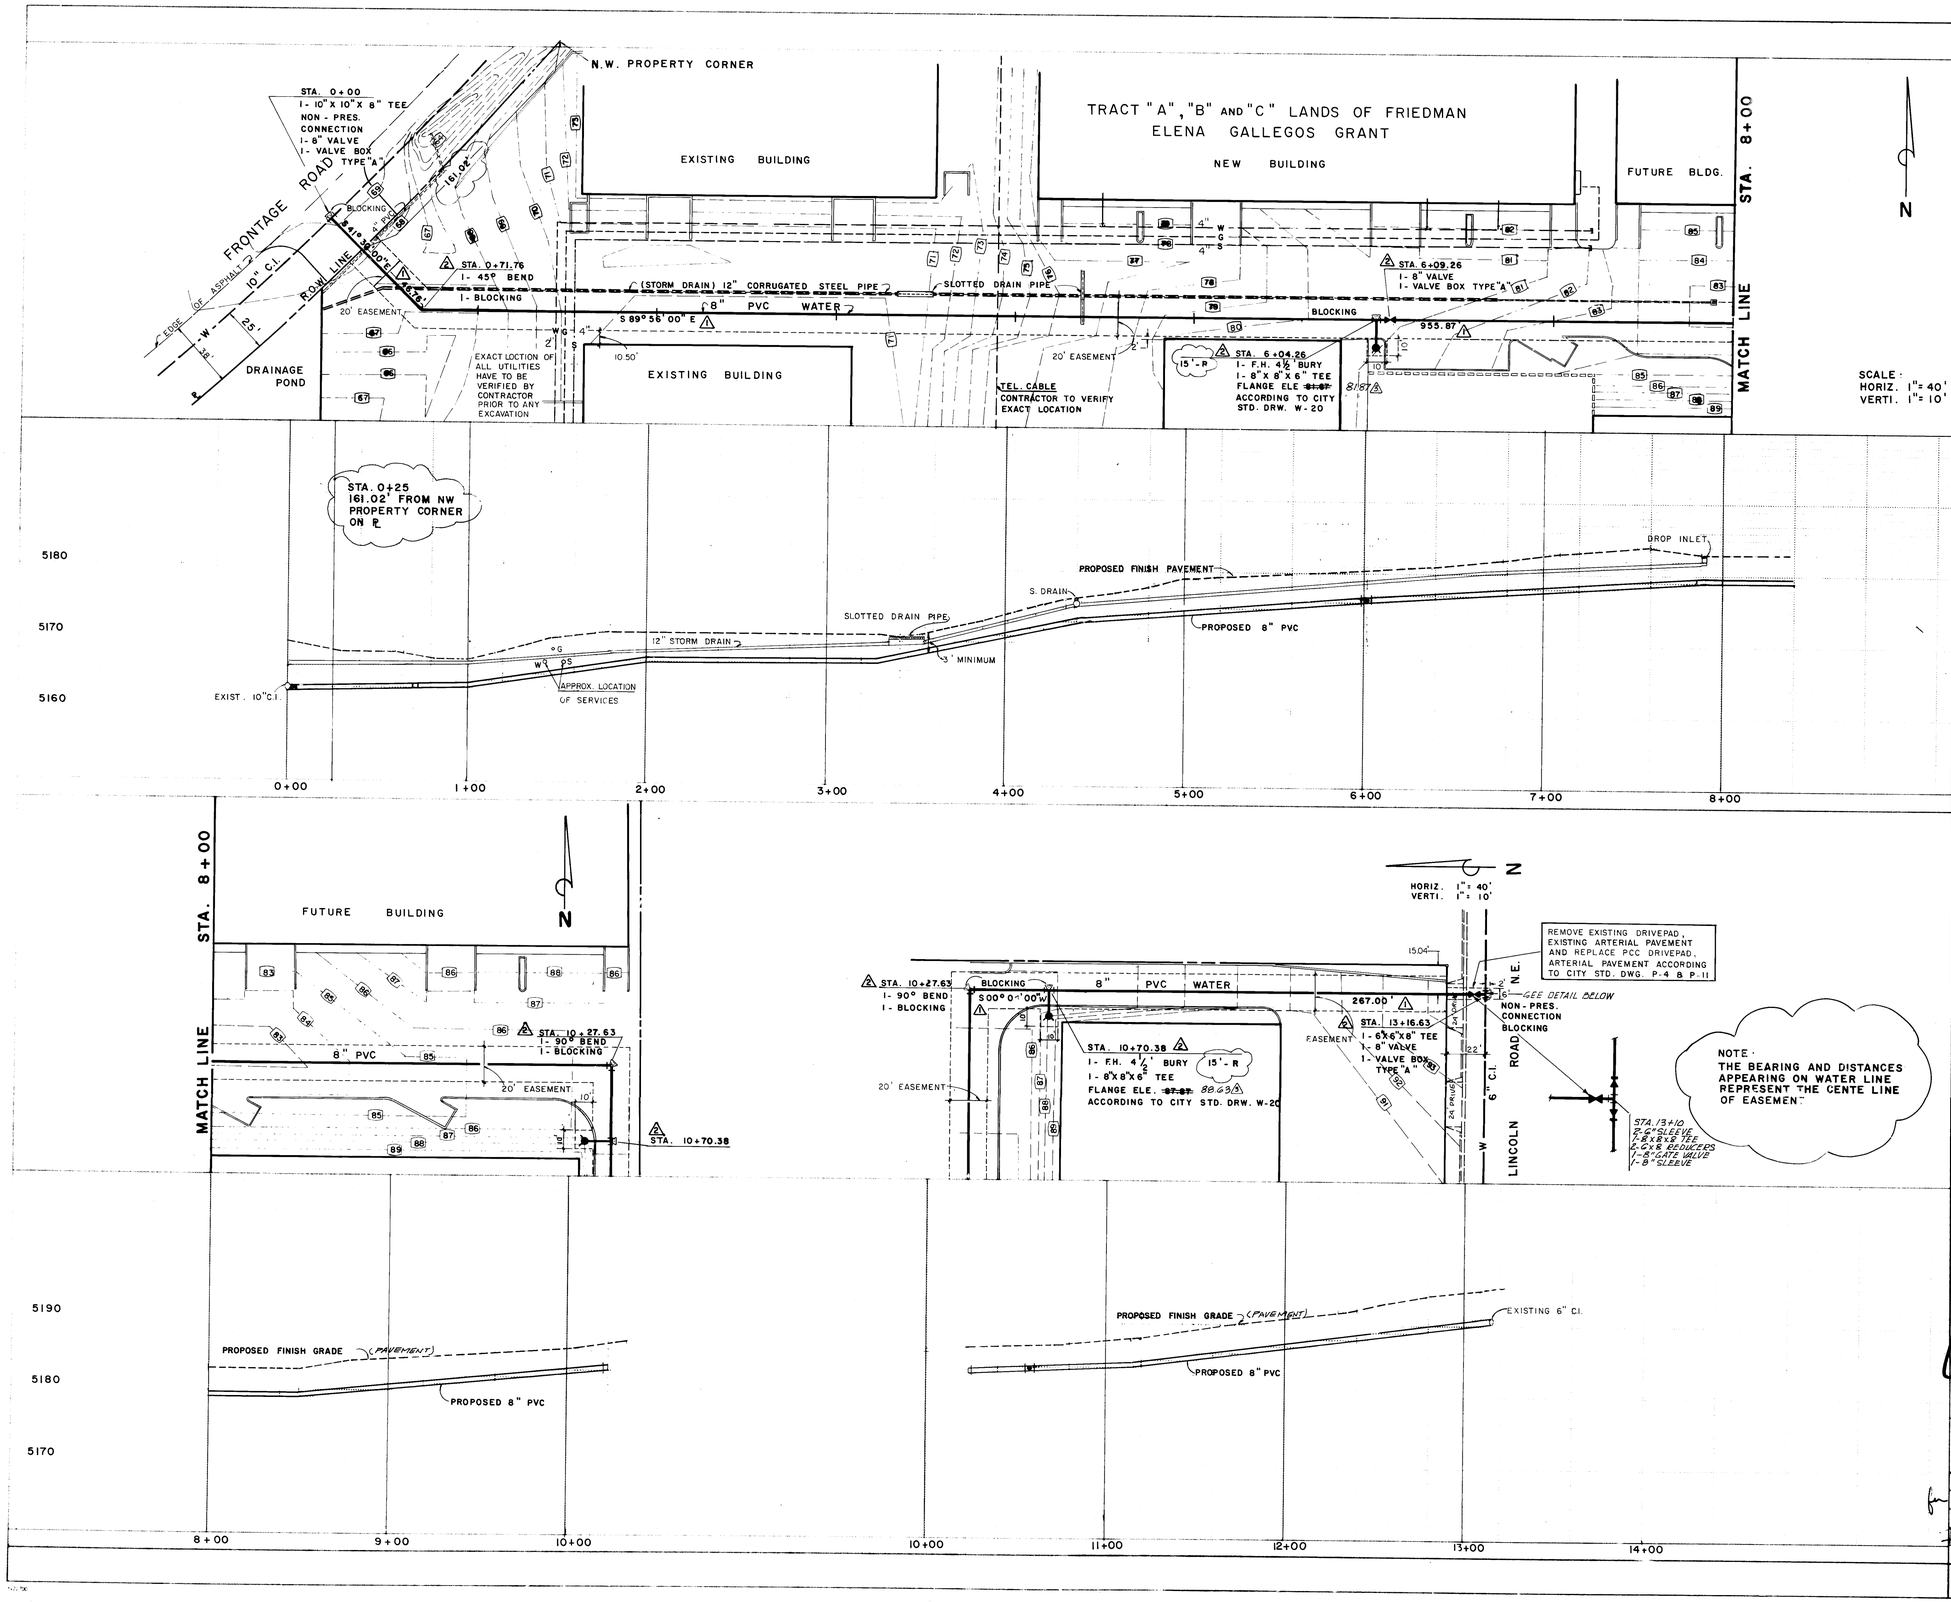

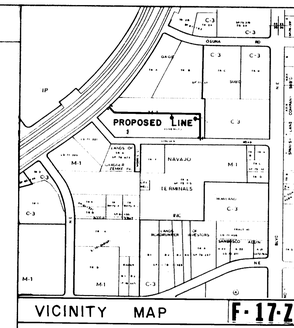

VICINITY MAP F-17-Z

NOTICE TO CONTRACTORS:

1) City of Albuquerque Interim Standards Specifications Public Works Construction 1985 Edition will be referred to herein as the standard specifications.

2) All work detailed on these plans to be performed under contract shall, except as otherwise stated or provided for hereon, be constructed in accordance with City of Albuquerque Interim Standard Specifications Public Works Construction 1985 Edition.

3) Two working days prior to any excavation the contractor must contact line location service, 765-1234, for location of existing utilities.

4) Prior to construction, the contractor shall excavate and verify the horizontal and vertical location of all obstructions. Should a conflict exist the contractor shall notify the engineer or surveyor so that the conflict can be resolved with a minimum of delay.

THE FOLLOWING NOTES APPLY IF CHECKED:

[✓] All utilities and utility service lines shall be installed prior to paving.
[ ] Backfill compaction shall be according to arterial street use.
[ ] Tack coat requirements shall be determined by the City Engineer.
[ ] Sidewalk and wheelchair ramps within the curb returns shall be constructed wherever a new curb return is constructed.
[ ] If a curb is depressed for a driveway, the drivepad shall be constructed prior to acceptance of curb and gutter.

TRAFFIC HANDLING NOTES

1) Contractor must submit a construction signing and barricading plan to Traffic Engineering Division and receive a barricading permit prior to construction.

2) All construction signing and barricading to comply with manual on Uniform Traffic Control Devices, 1978 Edition and subsequent revisions.

AS BUILT INFORMATION
CONTRACTOR SUNDANCE MECH.
WORK STAKED BY
INSPECTOR'S FIELD BOOK BY L. POMERO DATE 12-23-86
VERIFICATION BY FIELD CREW DATE
CORRECTED BY EN. DATE 1-5-87
MICRO-FILM INFORMATION
RECORDED BY DATE
NO

BENCH MARKS
CITY B.M. 1-25-17 EL. 5171.10
ON SITE TEMPORARY B.M. 5168.70
N.E. BONNET BOLT OF FIRE HYDRANT AT N.W. CORNER OF PROPERTY.

SURVEY INFORMATION
FIELD NOTES
NO | BY | DATE

ENGINEER'S SEAL
DAVID V. WELLS 7918 REGISTERED PROFESSIONAL ENGINEER

26 299940187

APPROVAL OF AS BUILT DRAWINGS
CITY ENGINEER
Russell B. Sales
DATE 1-9-87

NO	DATE	REMARKS	BY
3	9/19/86	ADDED BEARING AND DISTANCE FOR ℄	EN
2	9/19/86	STATIONING HAS BEEN CORRECTED	
1	1-5-86	REVISED FROM AS BUILT INFORMATION	

REVISIONS

DESIGN
DESIGNED BY DATE
DRAWN BY DATE
CHECKED BY DATE

9/10/86

CITY OF ALBUQUERQUE
MUNICIPAL DEVELOPMENT DEPARTMENT
ENGINEERING DIVISION

TITLE:
FRIEDMAN'S FIRE HYDRANTS

APPROVALS	ENGINEER	DATE	APPROVALS	ENGINEER	DATE
City Engineer		7/28/86	Liquid Waste		7/25/86
A.C.E. - Design		7/25/86	Traffic		7/25/86
A.C.E. - Hydrology		7/25/86	Water		7/25/86

DRAWING NO.	MAP NO.	SHEET	OF
2994	F-17	1	1