


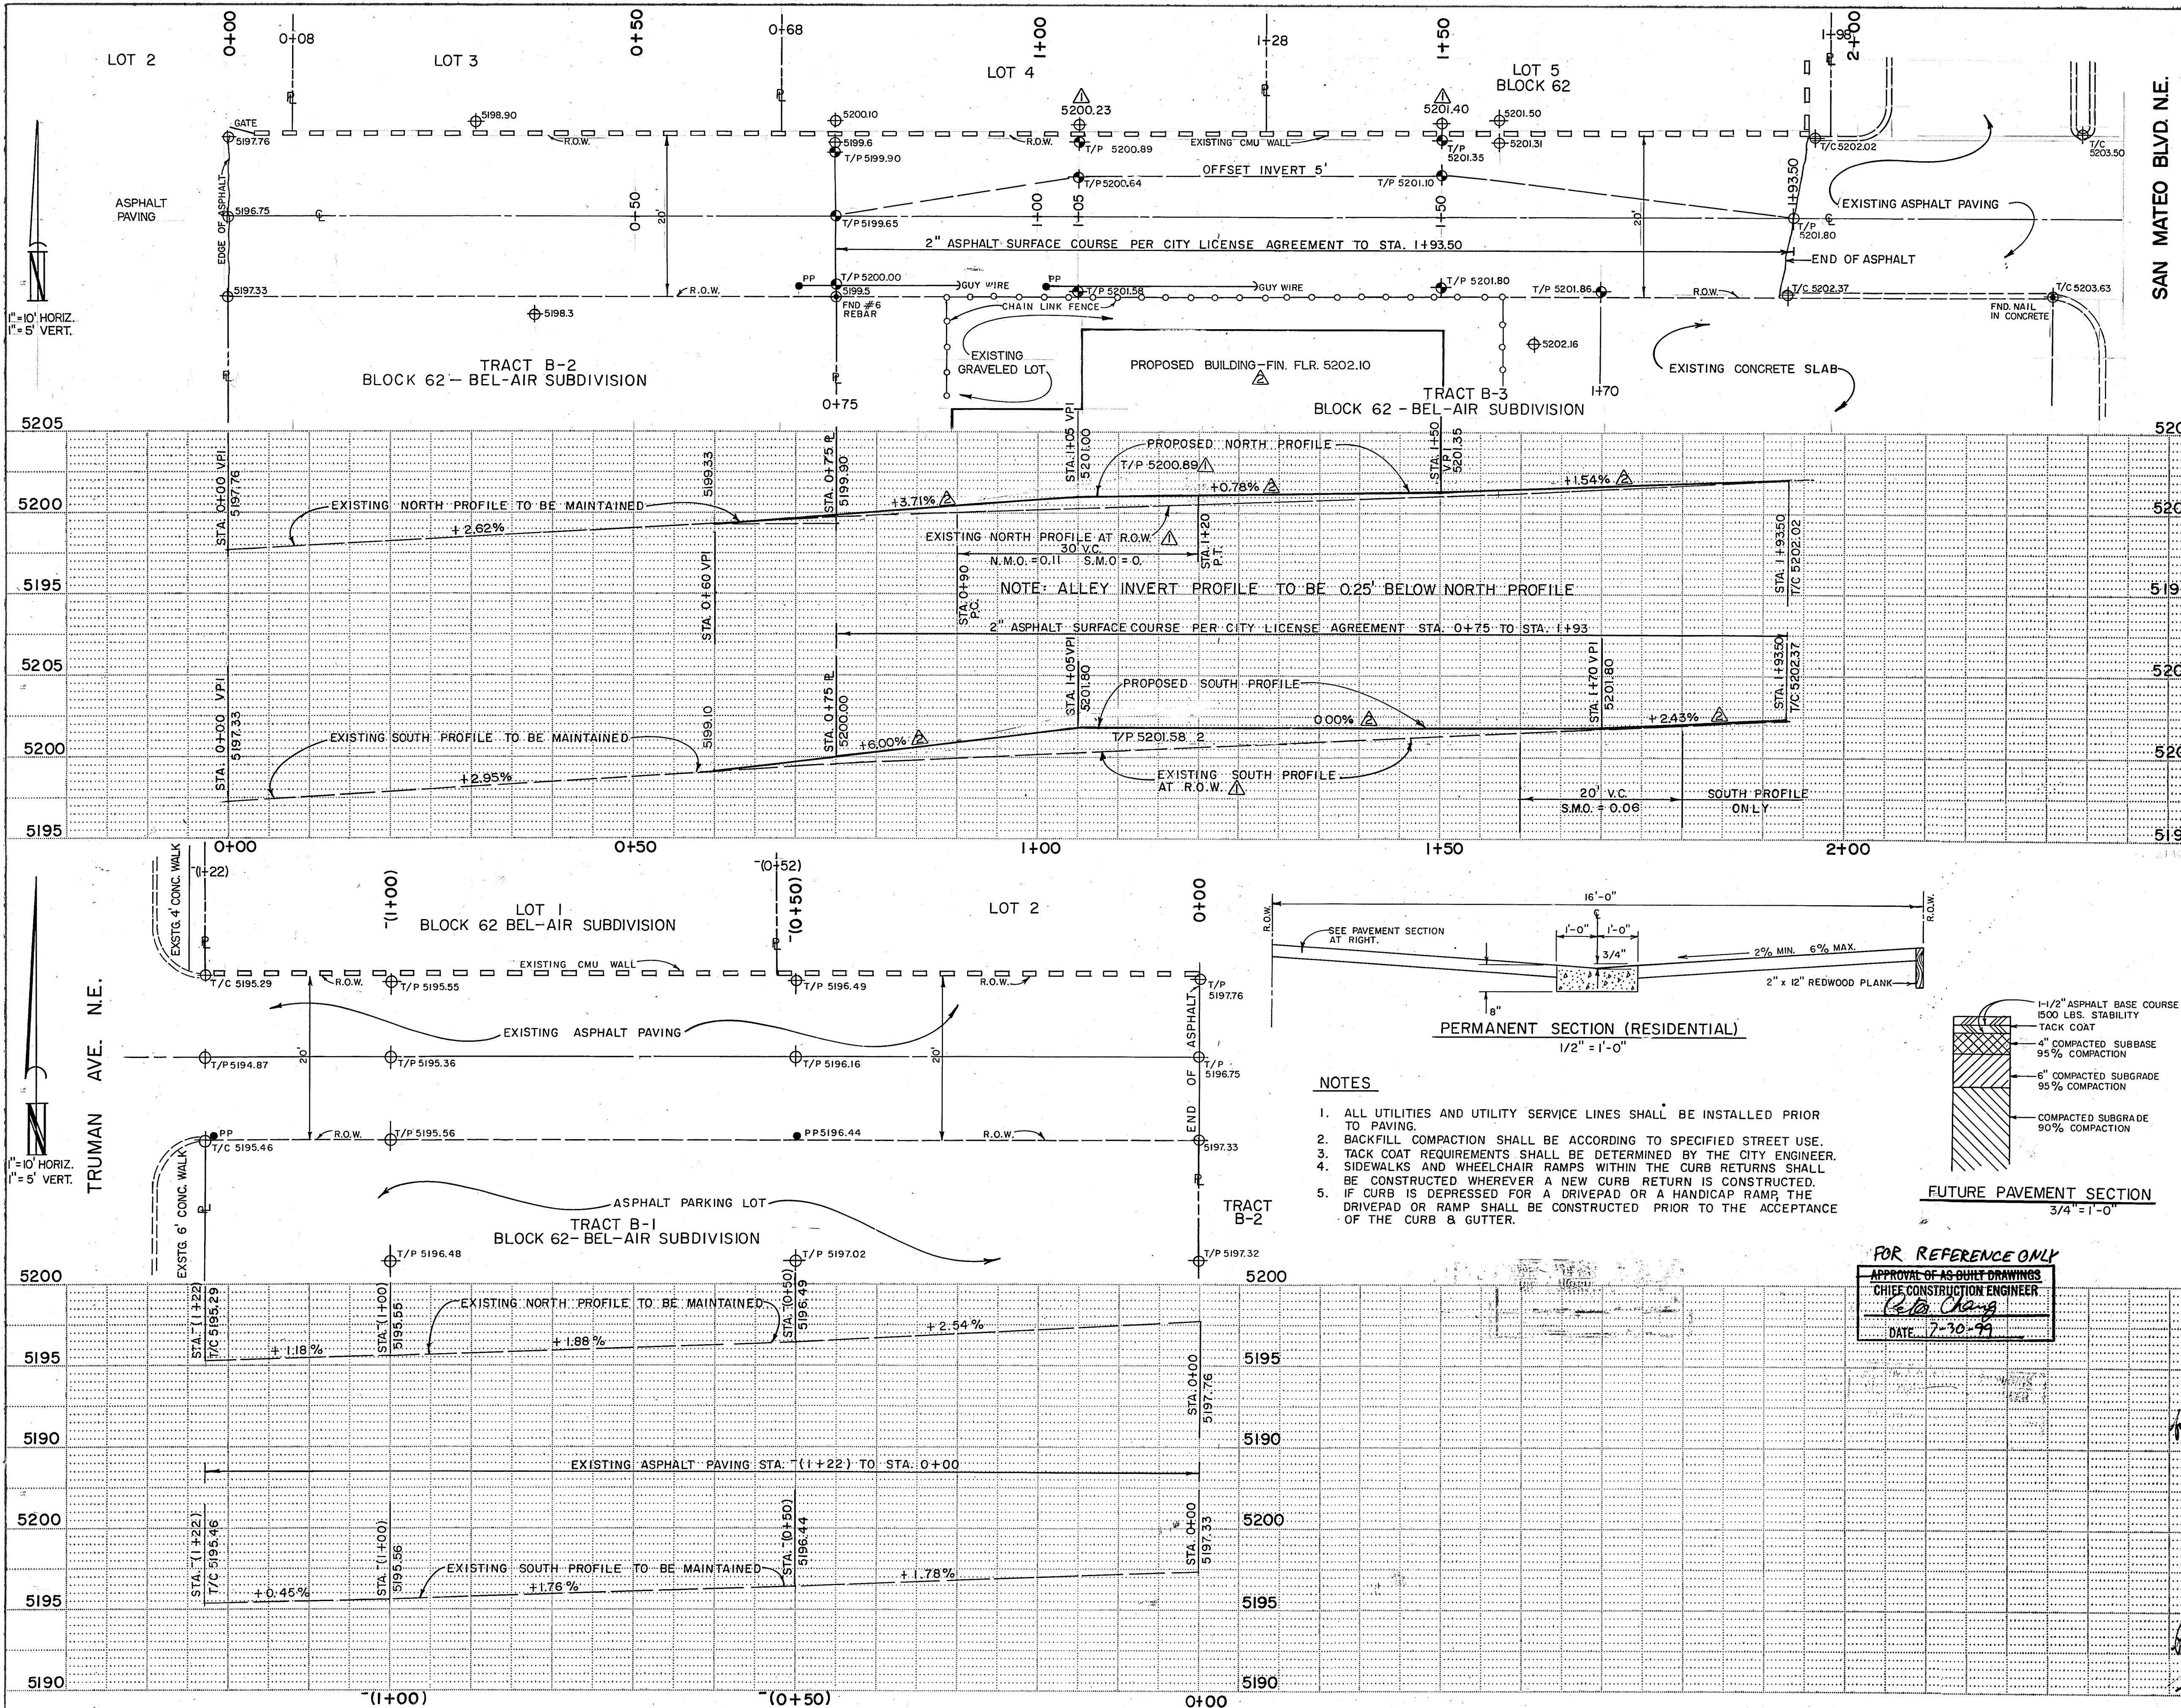

PROJECT LOCATION				VICINITY MAP			
COMANCHE ROAD N.E.				SAN MATEO BLVD. N.E.			
MESALERO RD.				CHEROKEE RD.			
HEADINGLY AVE.				AZTEC RD.			
QUINCY ST.				DANZARD ST.			
TRUMAN ST.				SAN MATEO BLVD. N.E.			
BENCH MARK				1"=500'			
LEGAL DESCRIPTION				NOTES			
BLOCK 62 OF BEL-AIR ADDITION, ALBUQUERQUE, NEW MEXICO.				1. 2" ASPHALT SURFACE COURSE TO BE CONSTRUCTED ACCORDING TO CITY LICENSE AGREEMENT, STA. 0+75 TO STA. 1+93.50 2. TWO (2) WORKING DAYS PRIOR TO ANY EXCAVATION, CONTRACTOR MUST NOTIFY LINE LOCATING SERVICE AT 765-1234. 3. NO UTILITY ADJUSTMENTS OR RELOCATIONS ARE REQUIRED.			
LEGEND				TYPICAL TEMPORARY SECTION			
EXISTING PROFILE PROPOSED PROFILE EXISTING SPOT ELEVATION PROPOSED SPOT ELEVATION EXISTING CURB EXISTING CHAIN LINK FENCE EXISTING CMU WALL POWER POLE W/ GUY				STA. 0+75 TO STA. 1+93.50 PER CITY LICENSE AGREEMENT. (2" OF ITEM P-33, 2" AC SF-1500-M SEC. 336, C.O.A. INTERIM STD. SPECS. 1985)			
APPROVALS				APPROVALS			
City Engineer		DATE 5/11/87		Liquid Waste		DATE 5-8-87	
A.C.E.-Design		DATE 5-11-87		Traffic		DATE 5-8-87	
A.C.E.-Hydrology		DATE 5-11-87		Water		DATE 5-8-87	
REVISIONS				REVISIONS			
NO.		DATE		NO.		DATE	
1		12/16/85		1		12/16/85	
2		12/16/85		2		12/16/85	
DESIGNED BY D.L.L.				CHECKED BY C.R.			
DRAWN BY C.L.L./C.L.B.				DATE 12/16/85			
PROJECT NO. 3187				MAP NO. G-17			
SHEET 1 OF 1				SHEET 1 OF 1			