LA BOCA NEGRA MODEL AIRPLANE AIRFIELD RENOVATION

Index

Page	Description
1	Title Sheet
2	Grading Plan
3	Location Plan

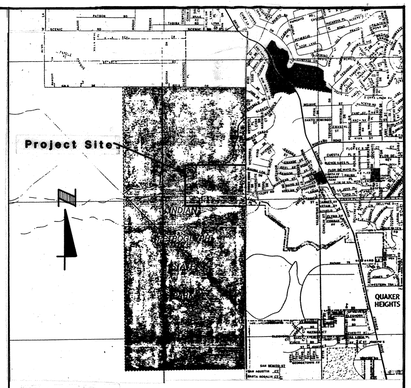

Vicinity Map

E-9-Z

NOTICE TO CONTRACTOR

1. All work detailed on these plans to be performed under contract shall, except as otherwise stated or provided for hereon, be constructed in accordance with City of Albuquerque Standard Specifications, Public Works Construction, 1986.

2. Two (2) working Days prior to any excavation, contractor must contact Line Locating Service, 765-1234, for location of existing utilities.

3. Prior to construction, the contractor shall excavate and verify the horizontal and vertical locations of all obstructions. Should a conflict exist, the contractor shall notify the engineer or surveyor so that the conflict can be resolved with a minimum amount of delay.

THE FOLLOWING NOTES ALSO APPLY WHEN CHECKED

- ☐ All utilities and utility service lines shall be installed prior to paving.
- ☐ Backfill compaction shall be according to specified street use.
- ☐ Tack coat requirements shall be determined by the City Engineer.
- ☐ Sidewalks and wheelchair ramps within the curb returns shall be constructed wherever a new curb return is constructed.
- ☐ If curb is depressed for a drivepad or ramp shall be constructed prior to acceptance of the curb and gutter.
- ☐ All storm drainage facilities shall be completed prior to final acceptance.

SUPERINTENDENT
ASST. SUPERINTENDENT
AREA SUPERVISOR
UTILITY REPAIRMAN

1 2 3 4 5 6 7 8 9 10 11 12
2 6 3 2 7 9 0 1 8 7

APPROVAL OF AS BUILT DRAWINGS
CHIEF CONSTRUCTION ENGINEER
Russell B. Dahl
DATE 11-19-87

SCANNED

SCANNED BY

REV	SHEETS	CITY ENG.	DATE	USER DEPT.	DATE	USER DEPT.	DATE

APPROVED FOR CONSTRUCTION
CITY ENGR. 8/5/87 DATE

PROJECT NUMBER 3279

SHEET 1 OF 3

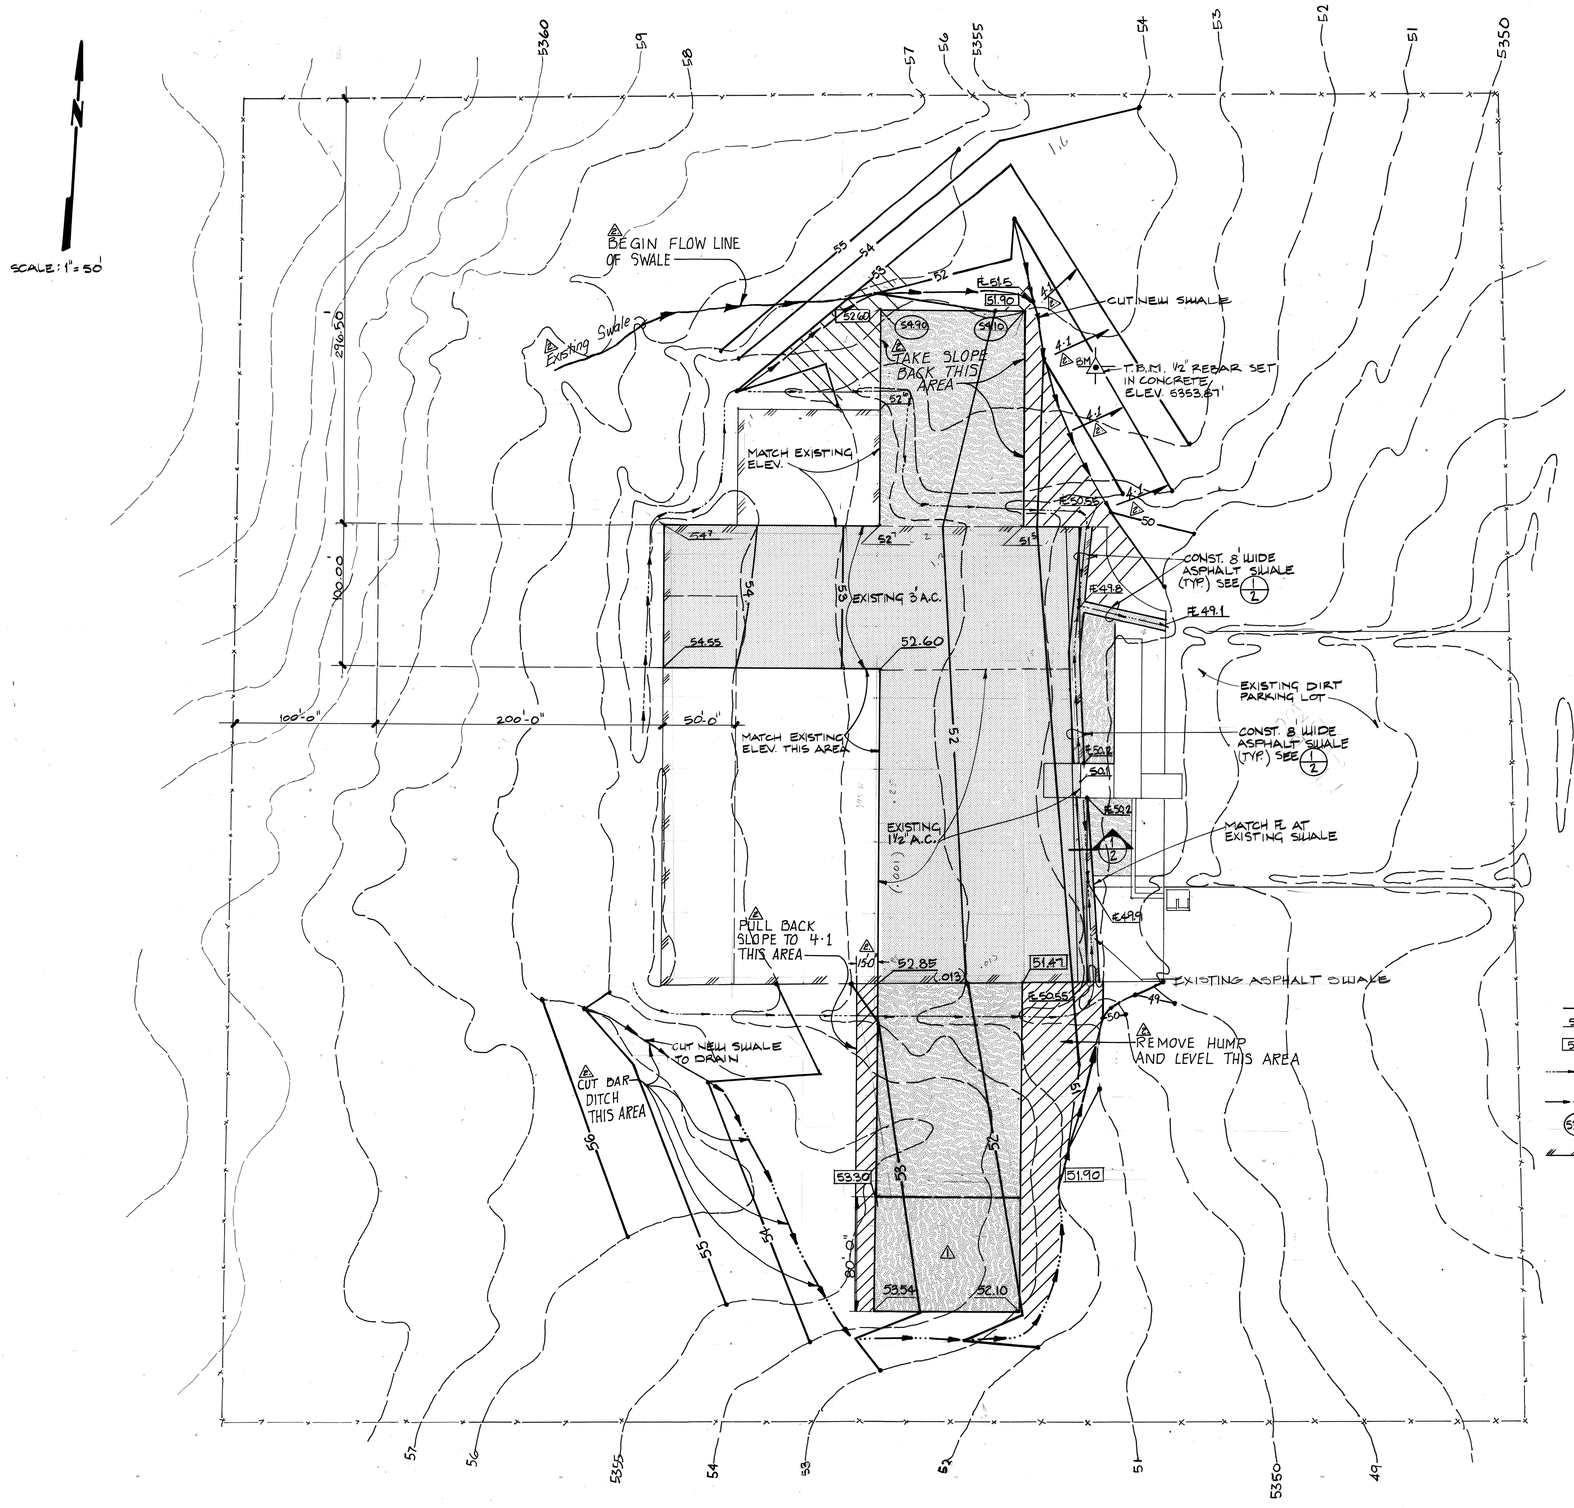

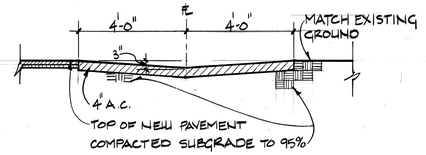

1/2 ASPHALT SWALE SECTION
SCALE: 3/8":1'-0" (TYP.)

SCANNED

SCANNED BY

1 2 3 4 5 6 7 8 9 10 11 12
2 6 3 2 7 9 0 2 8 7

AS BUILT INFORMATION
CONTRACTOR J.R. Hale
WORK STAKED BY — DATE
WORK INSPECTED BY — DATE
ACCEPTANCE BY Ray Baca DATE 11.23.87
FIELD LOCATION BY — DATE
DRAWINGS CORRECTED BY E.N. DATE 11.28.87
MICRO-FILM INFORMATION
RECORDED BY — DATE
NO.

BENCH MARKS
"256 28/27" THE STATION MARK IS A G.L.O. BRASS TABLET STAMPED "1/4 S 28 S 27" SET IN CONCRETE LOCATED 190' SOUTH OF THE INTERSECTION OF MONTE CARLO DR. & 81ST ST.

SURVEY INFORMATION
FIELD NOTES

NO.	BY	DATE

ENGINEER'S SEAL

NO.	DATE	REMARKS	BY
1	8-19-87	ADD ADDITIONAL NEW PAVING	R.P.
2	11.12.87	REVISED FROM AS-BUILT INFORMATION	E.N.

REVISIONS
DESIGN
DESIGNED BY R.P. DATE 7/87
DRAWN BY D.V. DATE 7/87
CHECKED BY R.P. DATE 7/87

CITY OF ALBUQUERQUE
PARKS & RECREATION
DESIGN & DEVELOPMENT

TITLE:
La Boca Negra Model Airplane Field
Grading Plan

APPROVALS	ENGINEER	DATE	APPROVALS	ENGINEER	DATE
City Engineer		11/2/87	Liquid Waste	N/A RJ1	6.23.87
A.C.E. Design		6/23/87	Traffic	N/A	
A.C. E.-Hydrology	CAM	6-30-87	Water	N/A RJ1	6.23.87

DRAWING NO. 3279 | MAP NO. E-9-Z | SHEET 2 OF 3

89302

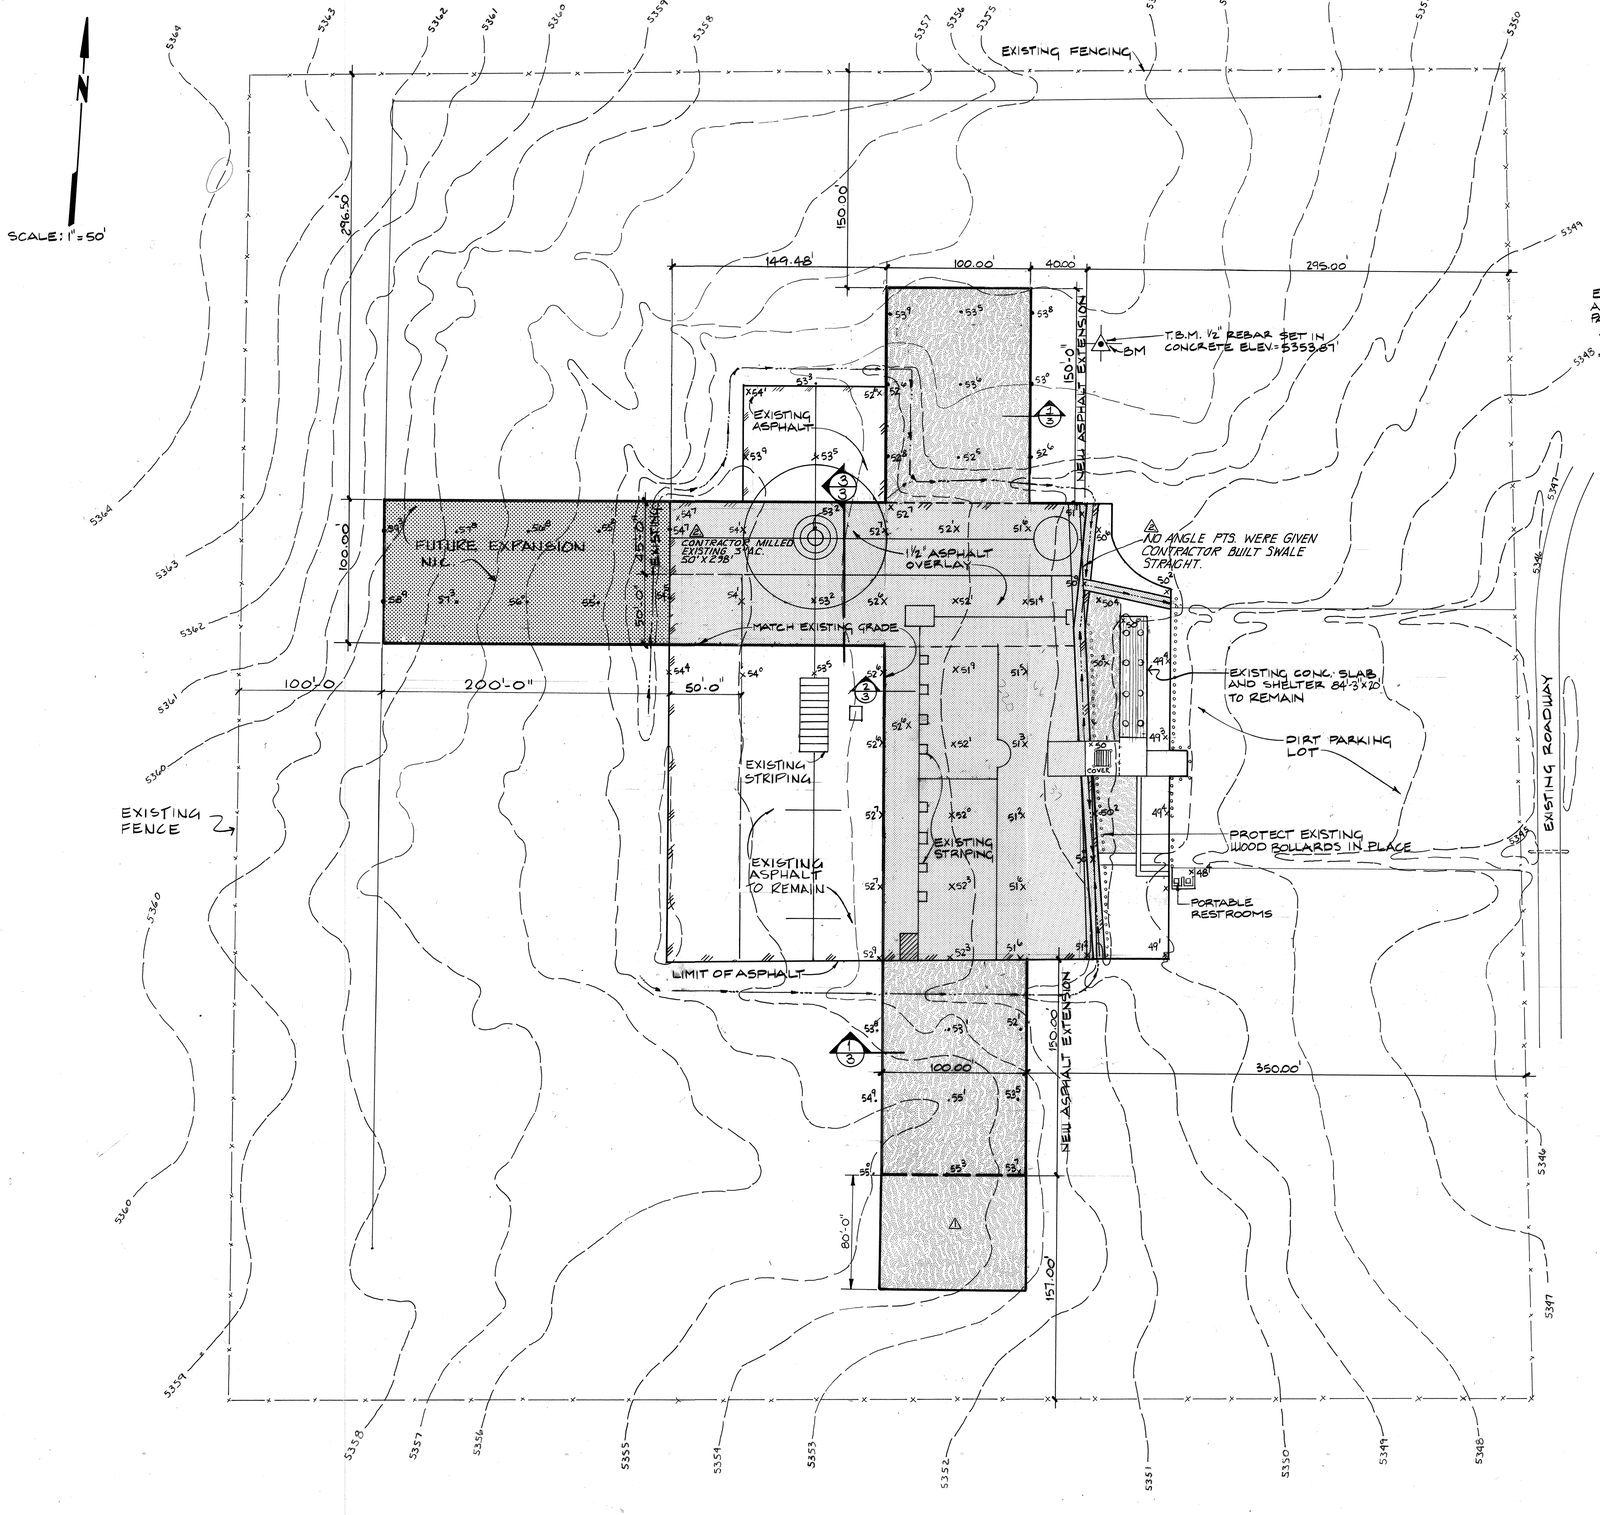

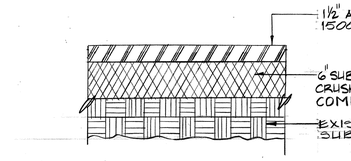

1/3 NEW ASPHALT CONCRETE PAVEMENT SECTION
NTS

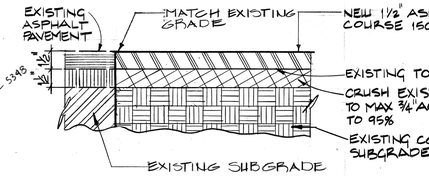

2/3 1½" ASPHALT CONCRETE OVERLAY PAVEMENT SECTION
NTS

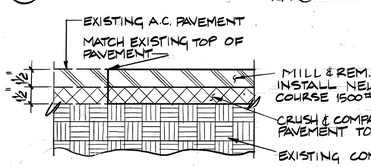

3/3 1½" A.C. OVERLAY SECTION
N.T.S.

LEGEND	
TO BE COLD MILLED LEVELED COMPACTED W/ NEW 1½" A.C. OVERLAY 1500# STABILITY	
SPOT ELEVATION ON EXISTING ASPHALT	52x
EXISTING ASPHALT TO REMAIN	
NEW 1½" A.C. 1500# STABILITY	
FUTURE EXPANSION N.I.C.	
SPOT ELEVATION NATURAL GROUND	52•

NOTES:

PAVING AT ENTRANCE DELETED

~~1. TO BE INCLUDED IN THIS CONTRACT IS 2" OVERLAY 300 FT. x 20 FT. WIDE PORTION OF EXISTING DIRT ROADWAY 150' ± EITHER SIDE OF CATTLE GUARD. COMPACT SUBGRADE TO 95%~~

2. STRIPING TO BE DONE BY OTHERS (N.I.C.)

SCANNED BY

1 2 3 4 5 6 7 8 9 10 11 12
2 6 3 2 7 9 0 3 8 7

AS BUILT INFORMATION
CONTRACTOR J.R. HALE
WORK STAKED BY — DATE
INSPECTIONS ACCEPTANCE BY Ray Baca DATE 6-23-87
FIELD VERIFICATION BY — DATE
DRAWINGS CORRECTED BY E.N. DATE 11-12-87
MICRO-FILM INFORMATION
RECORDED BY — DATE
NO.

BENCH MARKS
"GSC 28/27" THE STATION MARK IS A G.L.O. BRASS TABLET STAMPED "1/4 S28 S27" SET IN CONCRETE LOCATED 190' SOUTH OF THE INTERSECTION OF MONTE CARLO DR. & 8TH ST.

SURVEY INFORMATION
FIELD NOTES

NO.	BY	DATE

ENGINEER'S SEAL

NO.	DATE	REMARKS / REVISIONS / DESIGN	BY
1	8-19-87	ADD ADDITIONAL NEW PAVING	R.P.
2	11-12-87	REVISED FROM AS BUILT INFORMATION	E.N.

DESIGNED BY R.P. DATE 7/87
DRAWN BY D.V. DATE 7/87
CHECKED BY R.P. DATE 7/87

CITY OF ALBUQUERQUE
PARK & RECREATION
DESIGN & DEVELOPMENT

TITLE: La Boca Negra Airplane Field
Location Plan

APPROVALS	ENGINEER	DATE	APPROVALS	ENGINEER	DATE
City Engineer	[signature]	7/2/87	Liquid Waste	N/A RJJ	6-23-87
A.C.E. Design	[signature]	6/23/87	Traffic	N/A	
A.C.E.-Hydrology	[signature]	6-30-87	Water	N/A RJJ	6-23-87

DRAWING NO. 3279 | MAP NO. E-9-Z | SHEET 3 OF 3

89302