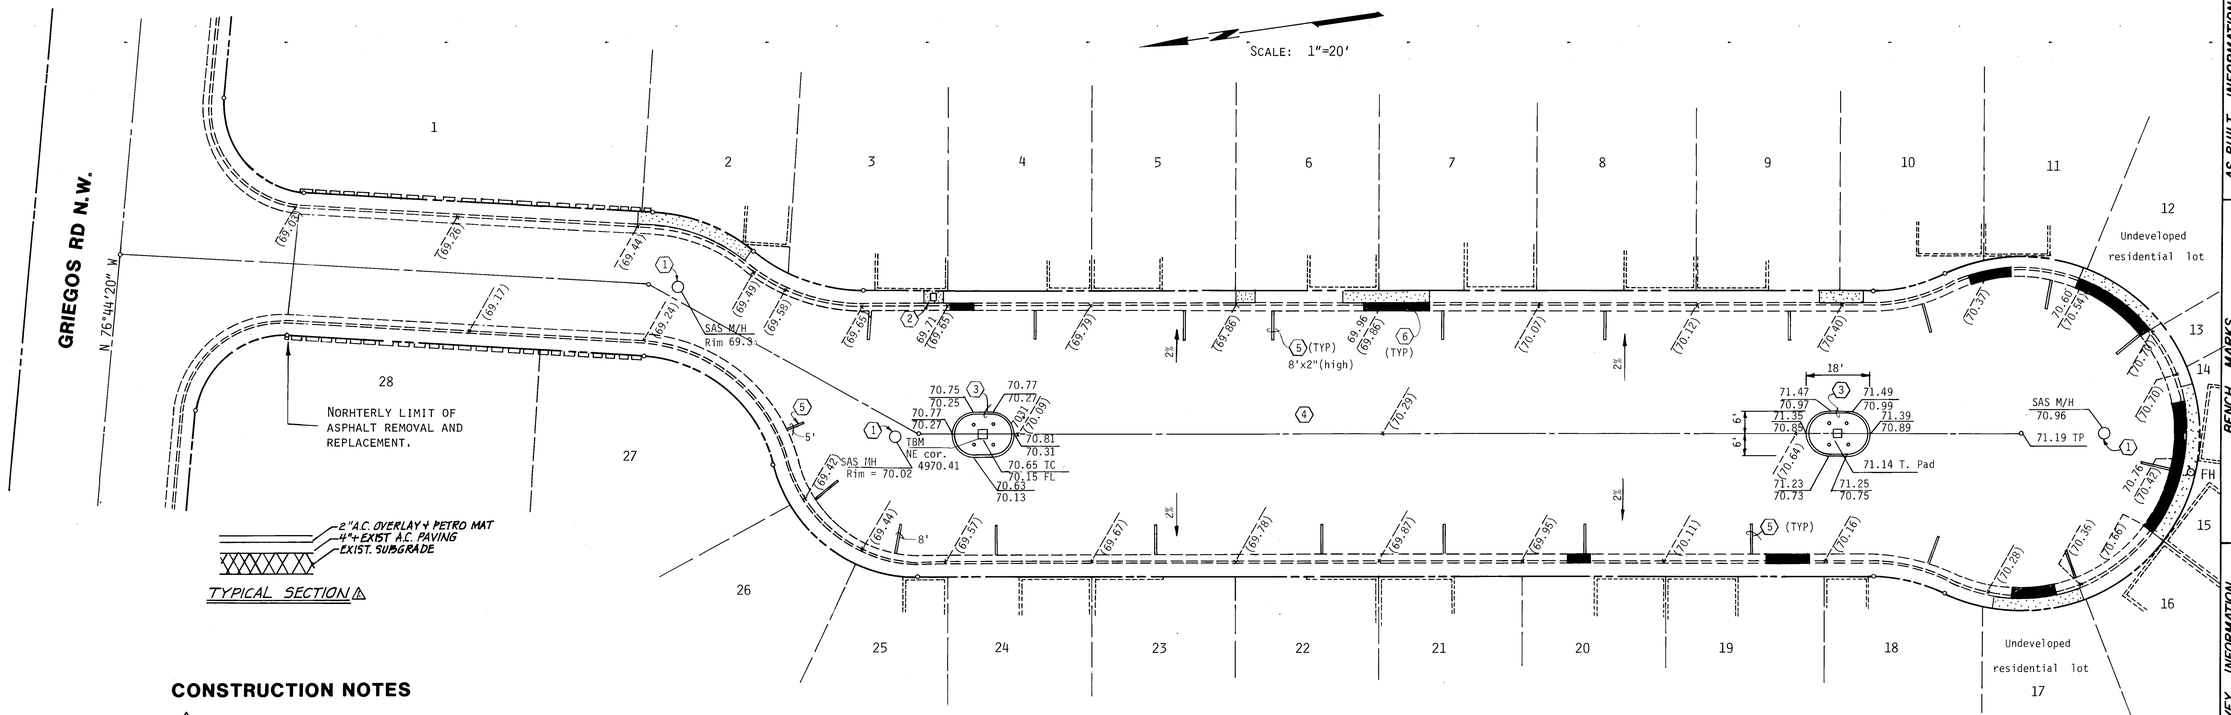

2"A.C. OVERLAY + PETRO MAT
4"+ EXIST A.C. PAVING
EXIST. SUBGRADE

TYPICAL SECTION ⚠

COMPOUND NORTH COURT N.W.

CONSTRUCTION NOTES

1. ⚠ ~~ALL EXISTING ASPHALT PAVING SHALL BE REMOVED AND REPLACED WITH A CITY OF ALBUQUERQUE STANDARD RESIDENTIAL ASPHALT SECTION AS PER STD. DWG. 2405.~~
2. REMOVE AND REPLACE CURB AND GUTTER AS INDICATED ON THE PLAN. NO PARTIAL STONE REMOVAL IS ACCEPTABLE, C & G SHALL BE REPLACED TO MATCH WITH THE FLOWLINE GRADES OF THE ADJACENT STONES WHERE NO ELEVATIONS ARE SHOWN
3. REMOVE AND REPLACE CONCRETE SIDEWALK AS INDICATED ON PLAN. SIDEWALK SHALL BE CONSTRUCTED AS PER C.O.A. DWG. 2430, SECTION A-A.

⬡ KEYED CONSTRUCTION

1. EXISTING SAS MANHOLE. ASPHALT PAVING TO MATCH ADJUSTED RIM ELEVATIONS.
2. REMOVE AND REPLACE WATER METER BOX AS SHOWN.
3. CITY STD. MEDIAN CURB & GUTTER AROUND EXISTING PNM TRANSFORMERS AND BARRIER POSTS.
4. CONTRACTOR TO PROVIDE A CURVED TRANSITION AT FINAL ASPHALT GRADE AT CROWN OF STREET.
5. ASPHALTIC SPEED BUMPS SHALL BE PLACED AS SHOWN ON PLAN. SPEED BUMP SHALL BE 8' FEET IN LENGTH MEASURED FROM TOE OF GUTTER, EXCEPT WHERE OTHERWISE DIMENSIONED. SPEED BUMPS SHALL BE ONE FOOT WIDE AT TOP OF PAVEMENT GRADE AND 2" IN HEIGHT. ALL SPEED BUMPS SHALL BE PAINTED YELLOW.
6. MOUNTABLE CURB & GUTTER REMOVAL AND REPLACEMENT. C&G CROSS SECTION TO MATCH EXISTING CURB & GUTTER.

GENERAL NOTES

1. ALL WORK DETAILED ON THESE PLANS TO BE PERFORMED UNDER CONTRACT SHALL, EXCEPT AS OTHERWISE STATED OR PROVIDED FOR HEREON, BE CONSTRUCTED IN ACCORDANCE WITH THE CITY OF ALBUQUERQUE STANDARD SPECIFICATIONS FOR PUBLIC WORKS CONSTRUCTION, 1986.
2. TWO (2) WORKING DAYS PRIOR TO ANY EXCAVATION, CONTRACTOR MUST CONTACT LINE LOCATING SERVICE, 765-1234, FOR LOCATION OF EXISTING UTILITIES.
3. PRIOR TO CONSTRUCTION, THE CONTRACTOR SHALL EXCAVATE AND VERIFY THE HORIZONTAL AND VERTICAL LOCATIONS OF ALL OBSTRUCTIONS. SHOULD A CONFLICT EXIST, THE CONTRACTOR SHALL NOTIFY THE ENGINEER OR SURVEYOR SO THAT THE CONFLICT CAN BE RESOLVED WITH A MINIMUM AMOUNT OF DELAY.
4. TACK COAT REQUIREMENTS SHALL BE DETERMINED BY THE CITY ENGINEER.
5. ALL UTILITIES AND UTILITY SERVICE LINES SHALL BE INSTALLED PRIOR TO PAVING.
6. BACKFILL COMPACTION SHALL BE ACCORDING TO SPECIFIED STREET USE.

LEGEND

95.53 / 95.03	PROPOSED TOP OF CURB / FLOWLINE ELEVATION
94.50* / (94.43)	PROPOSED FLOWLINE ELEV. (*WHERE APPLICABLE) / EXISTING FLOWLINE ELEVATION
	REMOVE AND REPLACE EXT. SIDEWALK
	REMOVE AND REPLACE FULL EXT. CURBSTONE
	EXISTING MOUNTABLE CURB & GUTTER TO REMAIN (NEW CURB TO MATCH EXISTING IN CROSS SECTION)
FH	EXISTING FIRE HYDRANT

CONSTRUCTION QUANTITIES

⚠ 1.	~~RESIDENTIAL ASPHALT REMOVAL AND REPLACEMENT (DWG. 2405)~~	~~3,340 SY~~
2.	MEDIAN CURB & GUTTER	102 LF
3.	MOUNTABLE C&G REMOVAL AND REPLACEMENT	130 LF
4.	P.C.C. SIDEWALK REMOVAL & REPLACEMENT	652 SF

APPROVAL OF AS BUILT DRAWINGS
CHIEF CONSTRUCTION ENGINEER
DATE 4-14-89

1 2 3 4 5 6 7 8 9 10 11 12
2 6 3 2 9 9 0 1 8 9

VICINITY MAP (F-13)

AS BUILT INFORMATION
CONTRACTOR J.R. HALE
WORK STAKED BY
INSPECTED BY
ACCEPTANCE BY [illegible] DATE 4/13/89
FIELD VERIFICATION BY EN DATE 4/89
DRAWINGS CORRECTED BY MICRO-FILM INFORMATION DATE 4/89

BENCH MARKS
T.B.M.
TOP OF NORTHERLY TRANSFORMER PAD WITHIN THE PAVED AREA OF COMPOUND NORTH COURT. EDGE OF CONC. ON WEST SIDE, □ CHISELED ON TOP OF CURB
CONTROL ELEVATION: 4970.41
BENCHMARK: ACS "5-F13" @ GRIEGOS ROAD AND GUADALUPE TRAIL NW
ELEVATION: 4970.59

RECORDED BY
NO. -
DATE

SURVEY INFORMATION
FIELD NOTES

NO.	BY	DATE

REFERENCES
MAP NO.
EST. NO.
W.O. NO.

NO.	DATE	BY	REVISIONS	DESIGN
⚠	4-13-89	EN	Revised from As built Info.	DESIGNED BY FCA DATE 8/87
			REMARKS	DRAWN BY NAA DATE 8/87
				CHECKED BY FCA DATE 8/88

PLANS PREPARED UNDER THE DIRECTION OF
TODD C. ABRAM NEW MEXICO 7322 REGISTERED PROFESSIONAL ENGINEER
APPROVED FOR CONSTRUCTION
CITY ENGINEER DATE 10/12/88

CITY OF ALBUQUERQUE
PUBLIC WORKS DEPARTMENT
ENGINEERING DIVISION

TITLE: COMPOUND NORTH COURT N.W
PAVEMENT RESTORATION

APPROVALS	ENGINEER	DATE	APPROVALS	ENGINEER	DATE
City Engineer		10/12/88	Liquid Waste	PEGO	10/12/88
A.C.E.-Design		10/12/88	Traffic		10.12.88
A.C.E.-Hydrology			Water	PEGO	10/12/88

DRAWING NO. 3299 | Map No. F-13 | SHEET 1 OF 1