

A1-1 TITLE & INDEX
 A1-2 SAN ANTONIO ARROYO - GENERAL INFORMATION
 A1-3 PLAT
 A1-4 SAN ANTONIO ARROYO - CHANNEL PLAN & PROFILE
 A1-5 SAN ANTONIO ARROYO - WINGWALL DETAILS
 A1-6 SAN ANTONIO ARROYO - WINGWALL DETAILS
 A1-7 SAN ANTONIO ARROYO - SECTIONS & DETAILS
 A1-8 GRADING & DRAINAGE PLAN
 A1-9 LIBRARY SITE PLAN
 A1-10 SITE DETAILS
 A1-11 LIBRARY IRRIGATION PLAN
 A1-12 LIBRARY PLANTING PLAN
 A1-13 SANTA FE VILLAGE PARK - IRRIGATION PLAN
 A1-14 SANTA FE VILLAGE PARK - PLANTING PLAN
 A1-15 LANDSCAPE DETAILS
 A1-16 WATER LINE EXTENSION

A2-1 FOUNDATION PLAN
 A2-2 ROOF FRAMING PLAN
 A2-3 STRUCTURAL DETAILS
 A2-4 WALL SECTIONS
 A2-5 WALL SECTIONS

A3-1 EXTERIOR ELEVATIONS & SECTION
 A3-2 ROOF PLAN


A4-1 FLOOR PLAN
 A4-2 CEILING PLAN
 A4-3 SCHEDULES & ELEVATIONS
 A4-4 DOOR & WINDOW DETAILS
 A4-5 PARTIAL PLANS & ELEVATIONS
 A4-6 CABINETS

M-1 PLUMBING FLOOR PLAN
 M-2 MECHANICAL FLOOR PLAN
 M-3 MECHANICAL DETAILS
 M-4 MECHANICAL SCHEDULES

E-1 POWER PLAN
 E-2 LIGHTING PLAN
 E-3 SPECIAL SYSTEMS
 E-4 SCHEDULES & DETAILS

TAYLOR RANCH BRANCH LIBRARY **SANTA FE VILLAGE PARK** **SAN ANTONIO ARROYO IMPROVEMENTS**

CITY OF ALBUQUERQUE

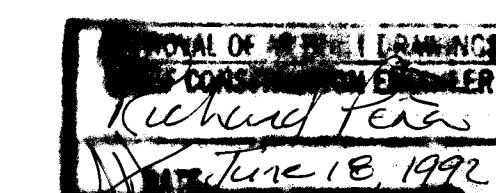

RECORD DRAWINGS CONSISTING OF DOCUMENTS LISTED ABOVE, HAVE BEEN PREPARED IN PART, BY INFORMATION FURNISHED BY THE CONTRACTOR. WHILE THIS INFORMATION IS BELIEVED TO BE RELIABLE, THE ARCHITECT CANNOT ASSUME ITS ACCURACY, AND THIS IS NOT RESPONSIBLE FOR THE ACCURACY OF THE RECORD DRAWINGS OR ANY ERROR OR OMISSIONS WHICH MAY HAVE BEEN INCORPORATED INTO THEM AS A RESULT. THOSE RELYING ON THESE RECORD DRAWINGS ARE ADVISED TO OBTAIN INDEPENDENT VERIFICATION OF THEIR ACCURACY BEFORE APPLYING THEM FOR ANY PURPOSE.
 FEBRUARY 17, 1991

HOSHOUR & PEARSON/ARCHITECTS

AUGUST 17, 1988

A1-1

26 3/17/1988

