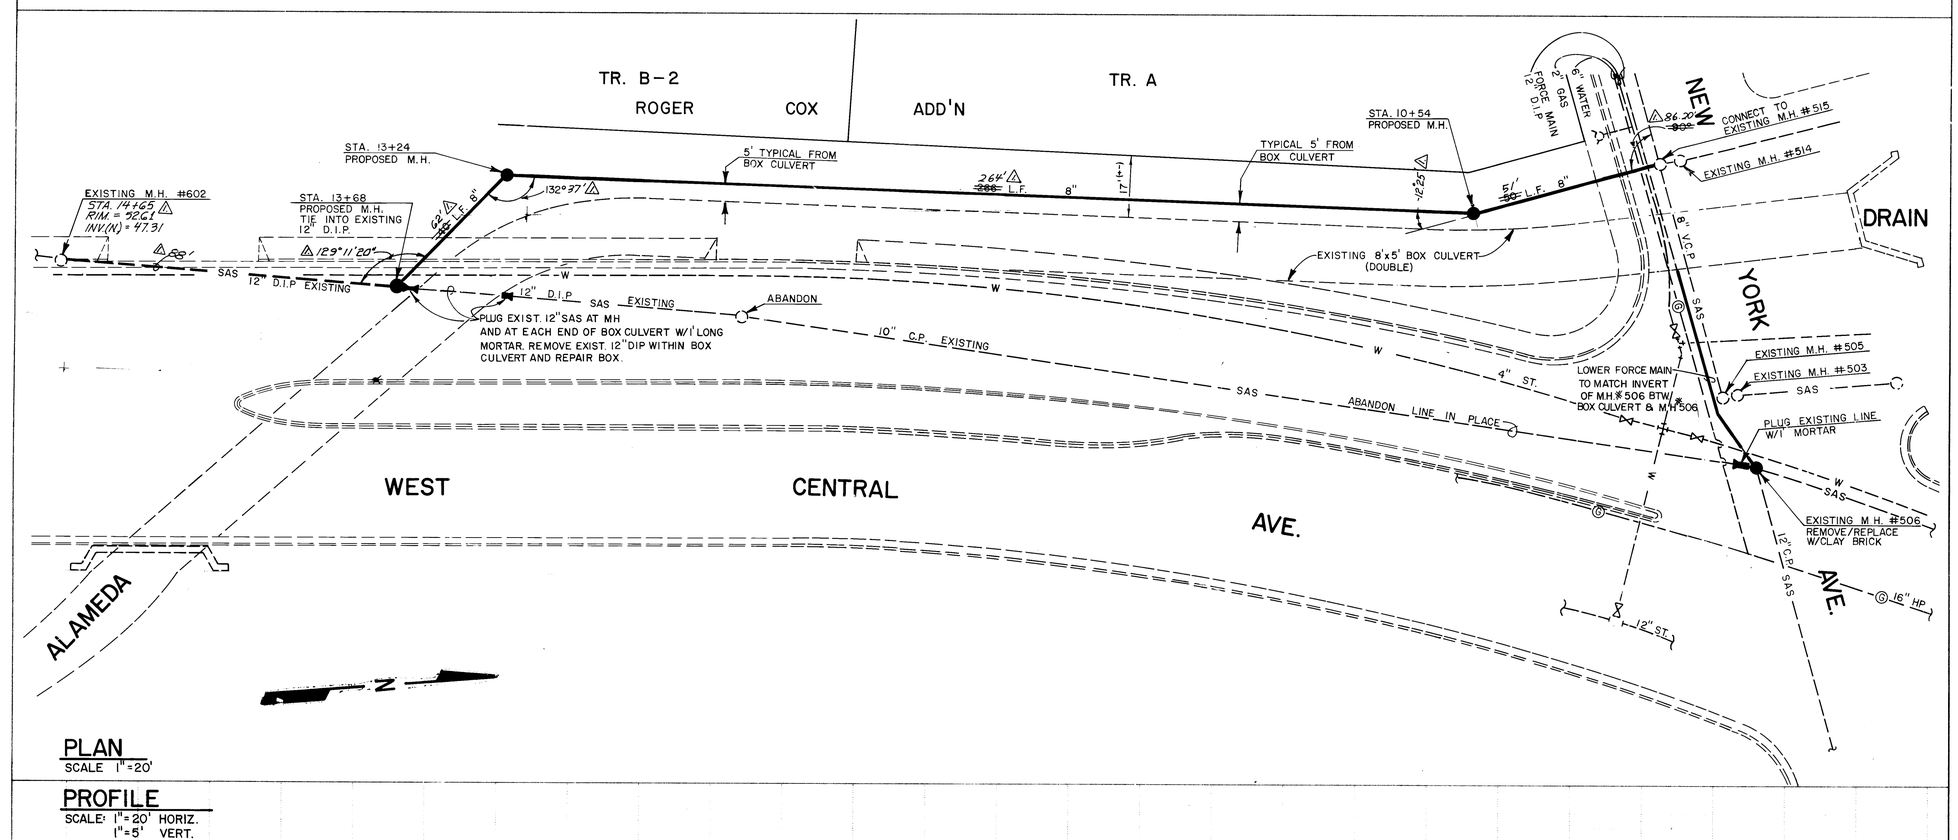

PLAN
SCALE 1"=20'

PROFILE
SCALE: 1"=20' HORIZ.
1"=5' VERT.

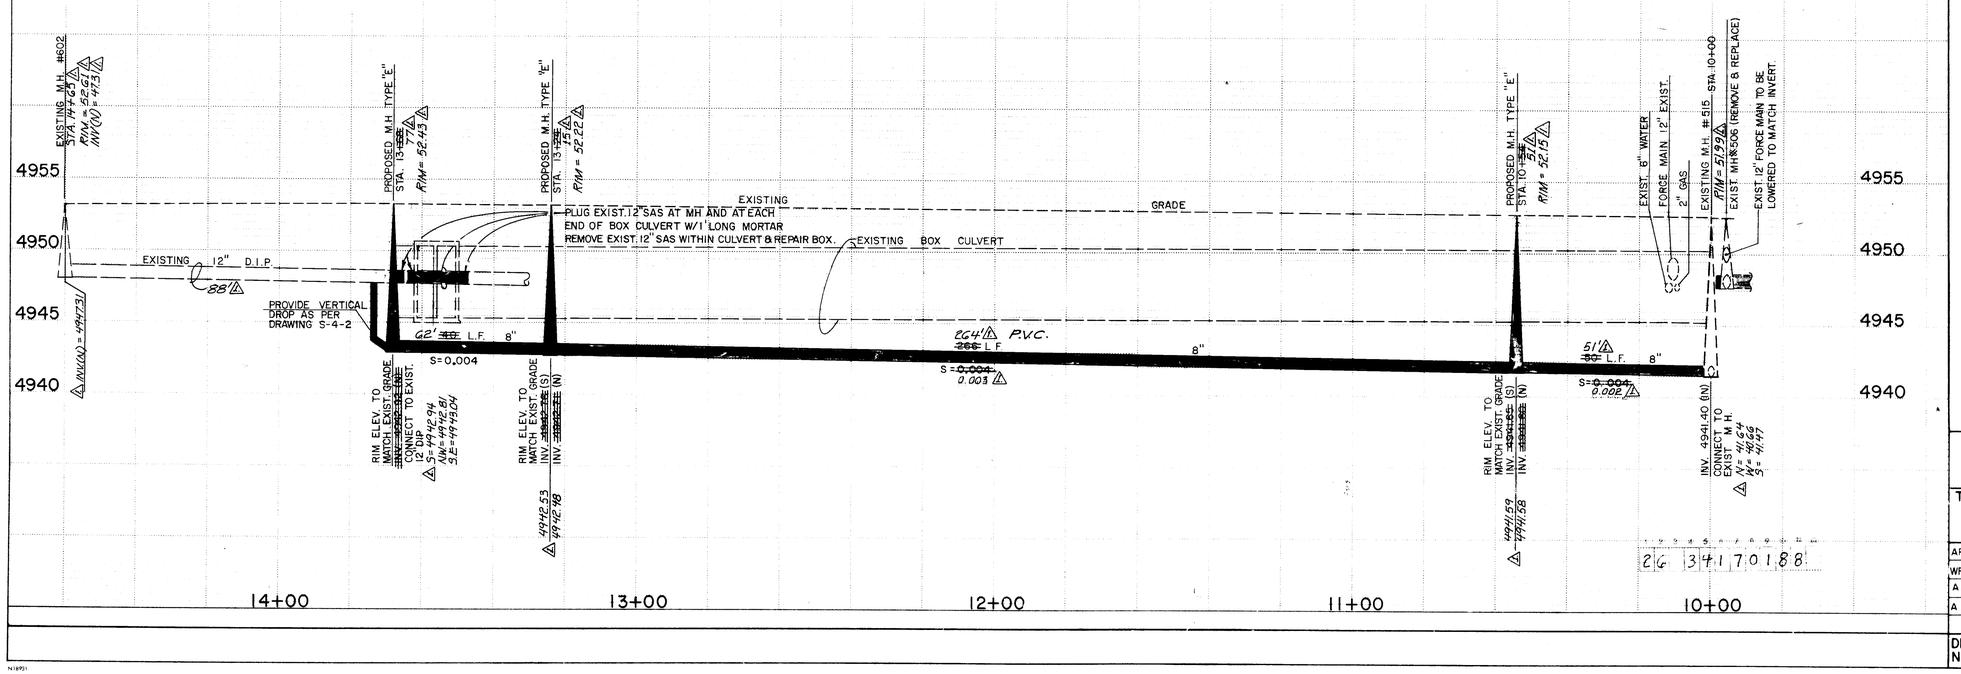

26 3417 0188

AS BUILT INFORMATION	
CONTRACTOR	
WORK STAKED BY	DATE
INSPECTOR	
AS-BUILT TAKEN BY	DATE
VERIFICATION BY	
DRAWINGS CORRECTED BY	DATE
MICRO-FILM INFORMATION	
RECORDED BY	DATE
NO.	

BENCH MARKS
LOCATED ON THE WEST SIDE OF CENTRAL AVE. IN THE 2600 BLOCK, IN FRONT OF THE 'CASA GRANDE MOTEL'
AN 'X' CHISELED ON A BONNET BOLT OF A FIRE HYDRANT
ELEV. 4956.30

SURVEY INFORMATION
FIELD NOTES

NO.	BY	DATE

ENGINEER'S SEAL

NO.	DATE	REMARKS	BY
1	11-15-87	REVISED FROM AS BUILT INFO (CURVE)	EN

REVISIONS

DESIGN
DESIGNED BY M.T. DATE
DRAWN BY G.L. DATE
CHECKED BY DATE

CITY OF ALBUQUERQUE
MUNICIPAL DEVELOPMENT DEPARTMENT
ENGINEERING DIVISION

TITLE: ALAMEDA DRAIN SAS EXTENSION BTW. NEW YORK AVE./CENTRAL AVE. WEST

APPROVALS	ENGINEER	DATE	APPROVALS	ENGINEER	DATE
WRD Engineer	[illegible]	2/18/93	Liquid Waste	[illegible]	2-17-93
A.C.E. - Design			Traffic		
A.C.E. - Hydrology			Water	[illegible]	2-17-93

DRAWING NO. 3417 | MAP NO. J-12 | SHEET 1 OF 1