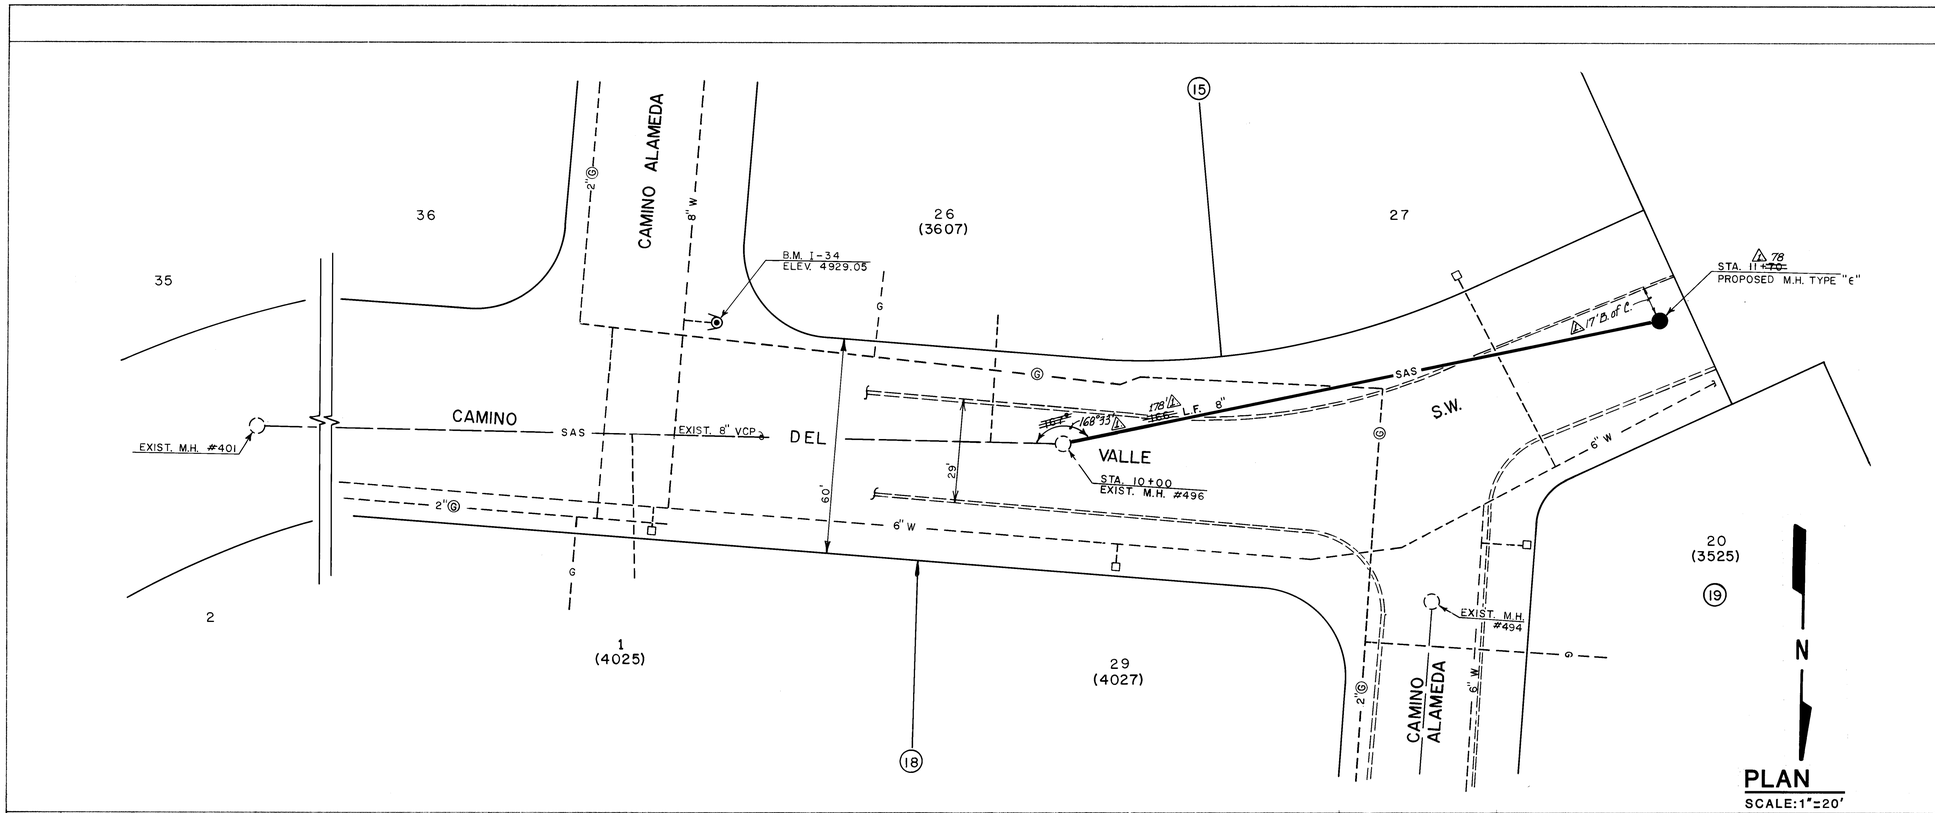

PLAN

SCALE: 1" = 20'

PROFILE

SCALE: 1" = 20' HORIZ.
1" = 5' VERT.

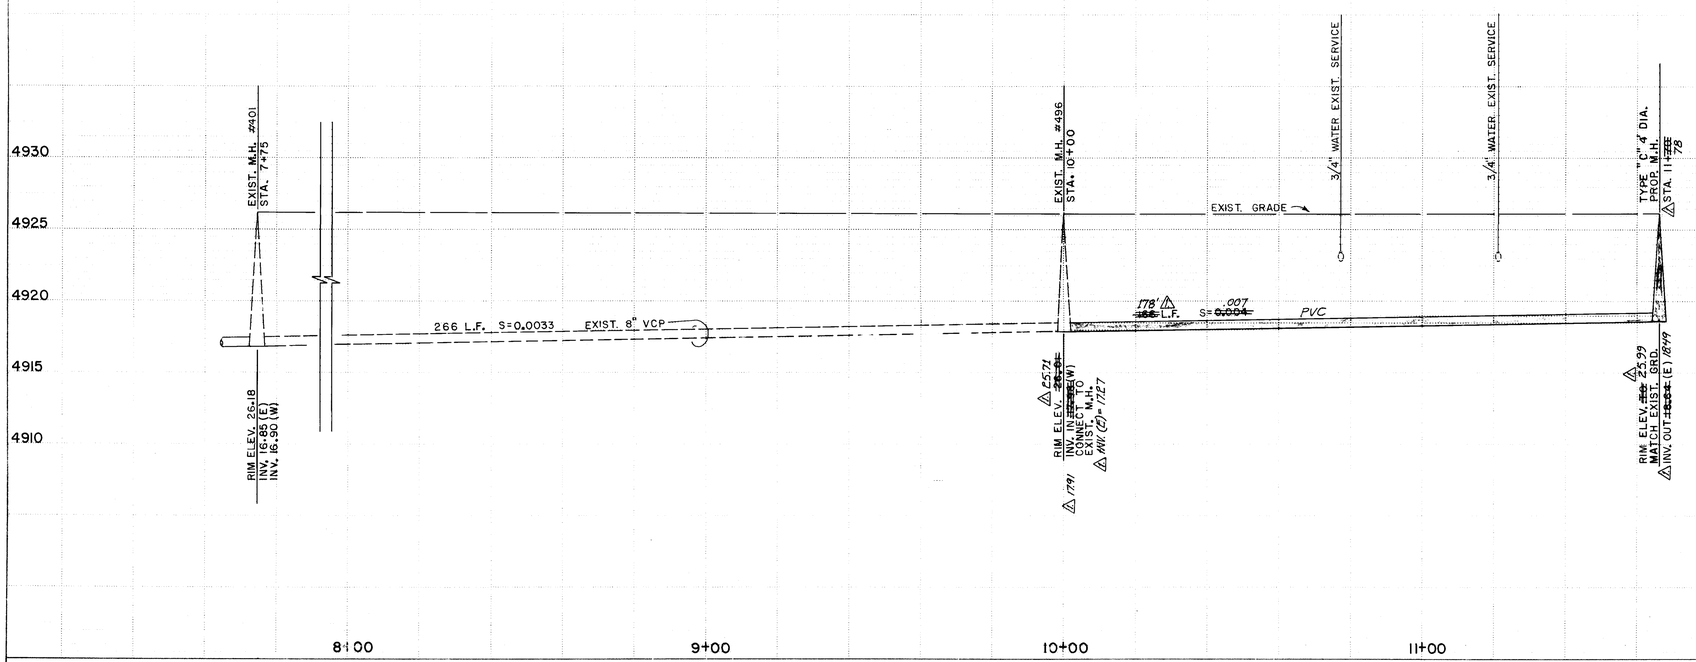

AS BUILT INFORMATION	
CONTRACTOR	
W.O. NO.	
CHANGES BY	DATE
INSPECTOR	
A.E.E. TO ENGINEER BY	DATE
A.E.E. TO	
VERIFICATION BY	DATE
CORRECTED BY	DATE
MICRO FILM INFORMATION	
RECORDED BY	DATE
NO.	

BENCH MARKS
BM I 34
NORTH B. B. ON HYDRANT AT S.W.
CORNER CAMINO DEL VALLE AT
CAMINO ALAMEDA ELEV. 4929.05

SURVEY INFORMATION		
FIELD NOTES		
NO	BY	DATE

ENGINEER'S SEAL

REVISIONS		
NO.	DATE	REMARKS	BY
1	11/10/87	REVISED FROM AS-BUILT INFO (SURVEY)	E.N.

DESIGN		
DESIGNED BY	A.E.E.	DATE 2/83
DRAWN BY	A.E.E.	DATE 2/83
CHECKED BY		DATE

1 2 3 4 5 6 7 8 9 10 11 12
2 6 3 4 1 8 0 1 8 8

APPROVAL OF AS BUILT DRAWINGS
CHIEF CONSTRUCTION ENGINEER
DATE

CITY OF ALBUQUERQUE
MUNICIPAL DEVELOPMENT DEPARTMENT
ENGINEERING DIVISION

TITLE: SAS EXTENSION
CAMINO DEL VALLE
SVSP CONTRACT 6

APPROVALS	ENGINEER	DATE	APPROVALS	ENGINEER	DATE
WRD Engineer	Nita H Mickman	2/18/83	Liquid Waste		2-17-83
A C E - Design			Traffic		
A C E - Hydrology			Water		2-17-83

DRAWING NO.	MAP NO.	SHEET	OF
3418	P-11	1	1