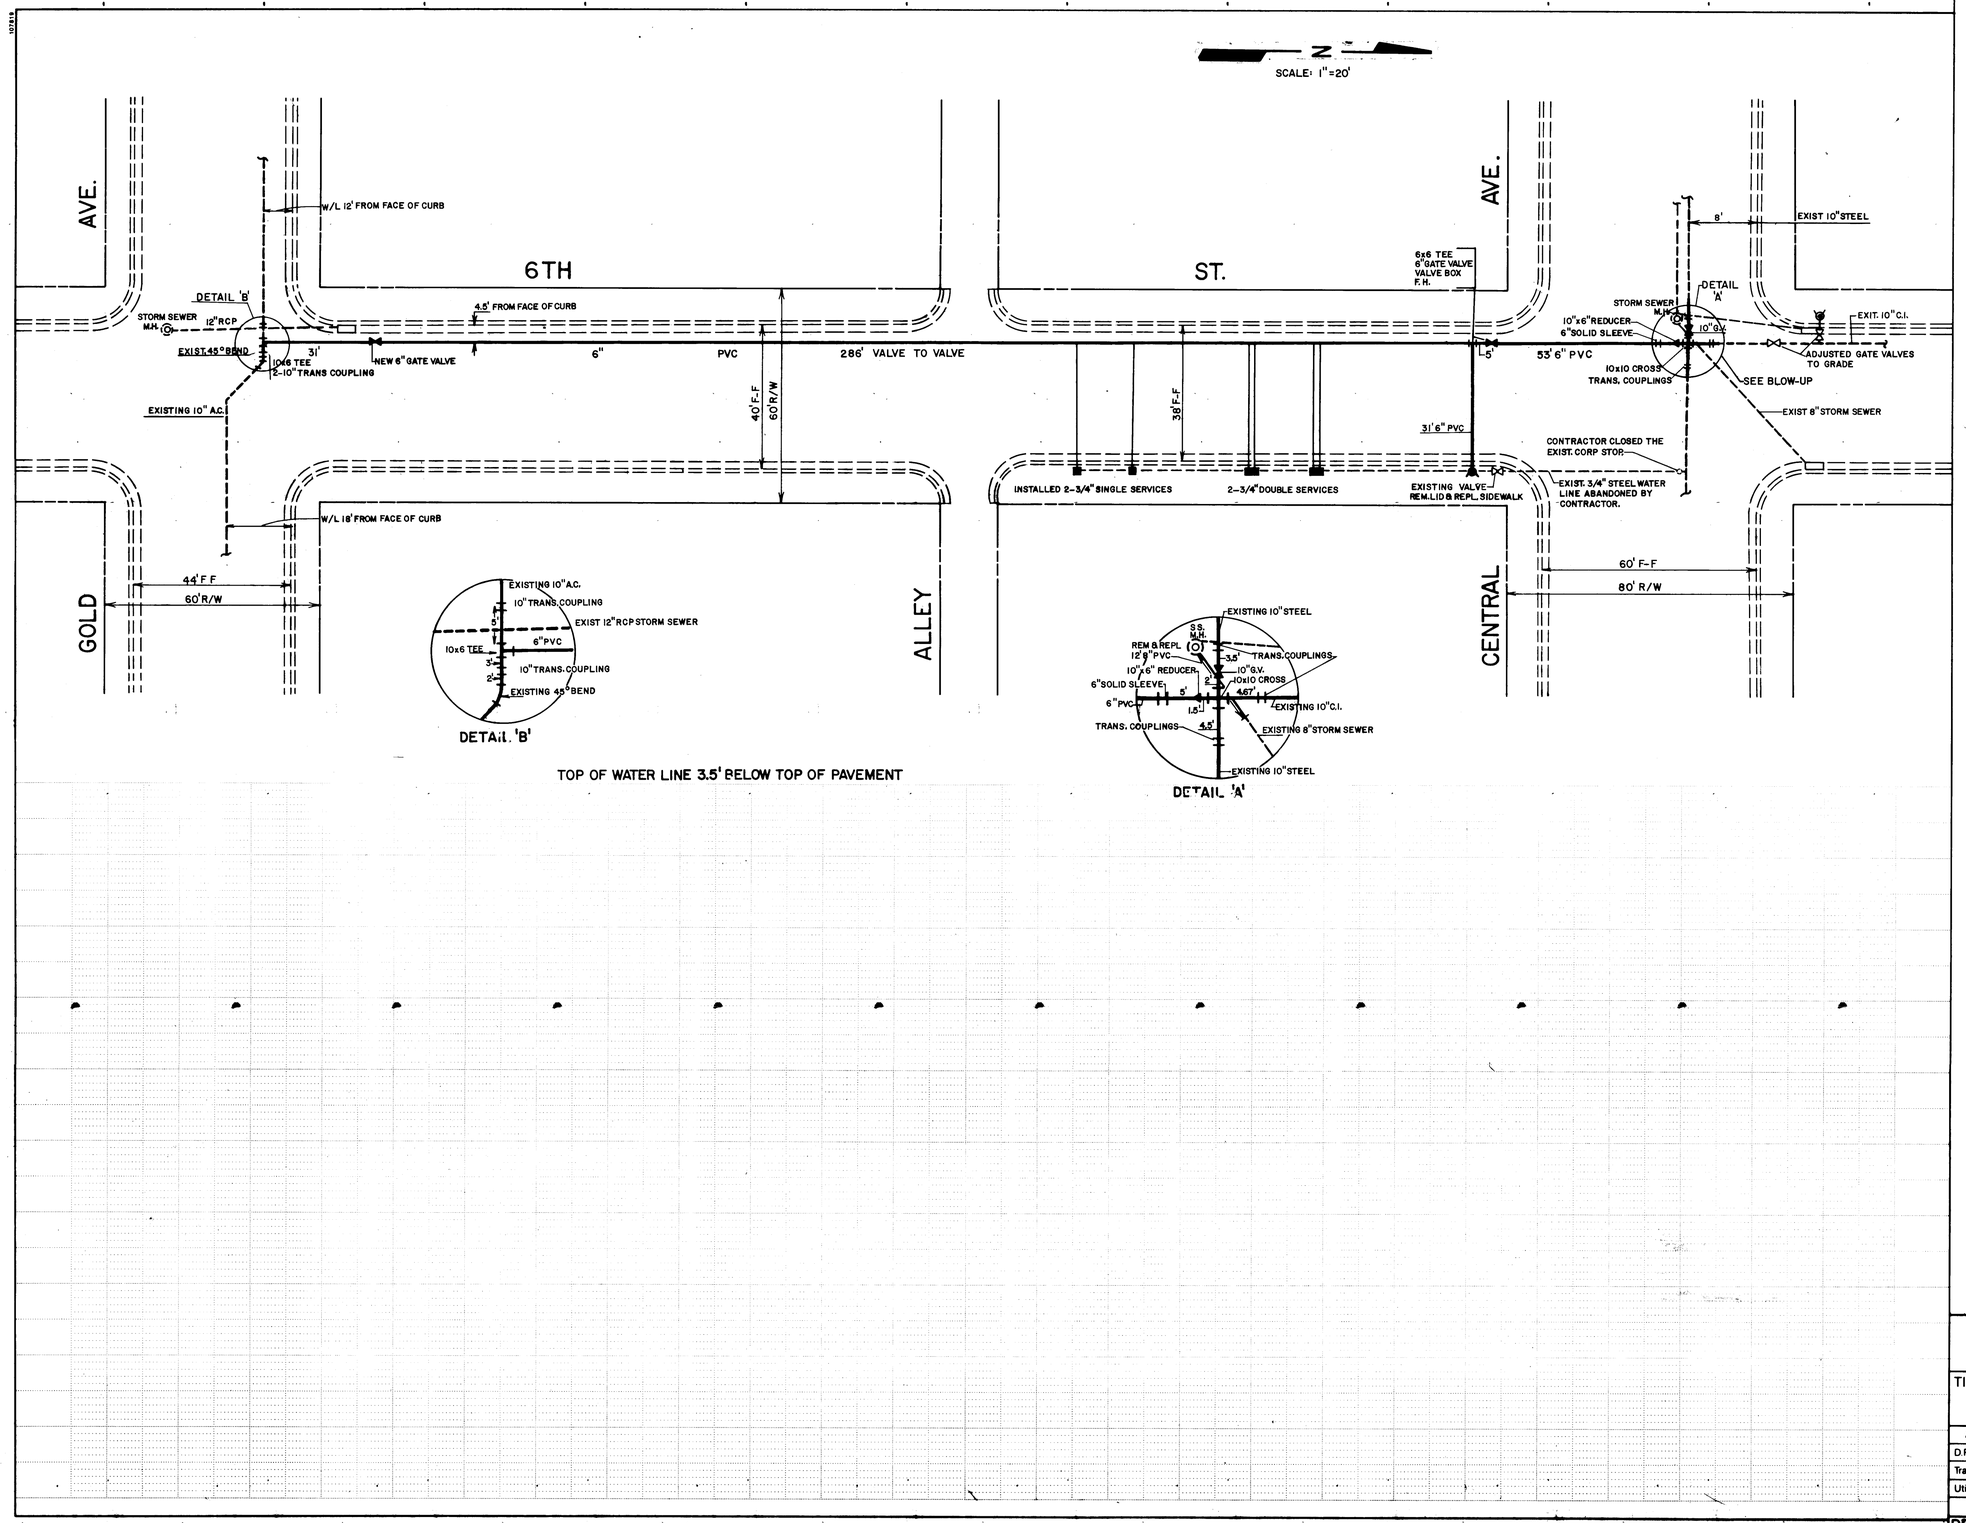

AS BUILT INFORMATION

CONTRACTOR MCC CONSTRUCTION
WORK STAKED BY
INSPECTORS INITIALS BY RAY BACA
FIELD VERIFICATION BY
DRAWINGS CORRECTED BY
MICRO-FILM INFORMATION
RECORDED BY
NO.

BENCH MARKS

SURVEY INFORMATION

FIELD NOTES

NO.	BY	DATE

ENGINEER'S SEAL

NO.	DATE	REMARKS	BY

REVISIONS

DESIGN

		DATE
DESIGNED BY		
DRAWN BY	GEORGE R. KING	DATE 8-17-88
CHECKED BY	FRED GOMEZ	DATE 8-17-88

1 2 3 4 5 6 7 8 9 10 11 12
2G 3565018 8

APPROVAL OF AS BUILT DRAWINGS
CHIEF CONSTRUCTION ENGINEER
DATE 9-9-88

CITY OF ALBUQUERQUE
PUBLIC WORKS DEPARTMENT
ENGINEERING GROUP

TITLE: NEW WATER LINE ON 6TH ST. S.W. BETWEEN GOLD AVE. & CENTRAL AVE.

APPROVALS	ENGINEER	DATE	APPROVALS	ENGINEER	DATE
D.R.C. Chair			Parks & Rec. Dept.		
Trans. Dev.			User Department		
Utility Dev.			Design Review Sec.		

DRAWING NO. 3565 | MAP NO. K 14 | SHEET 1 OF 1