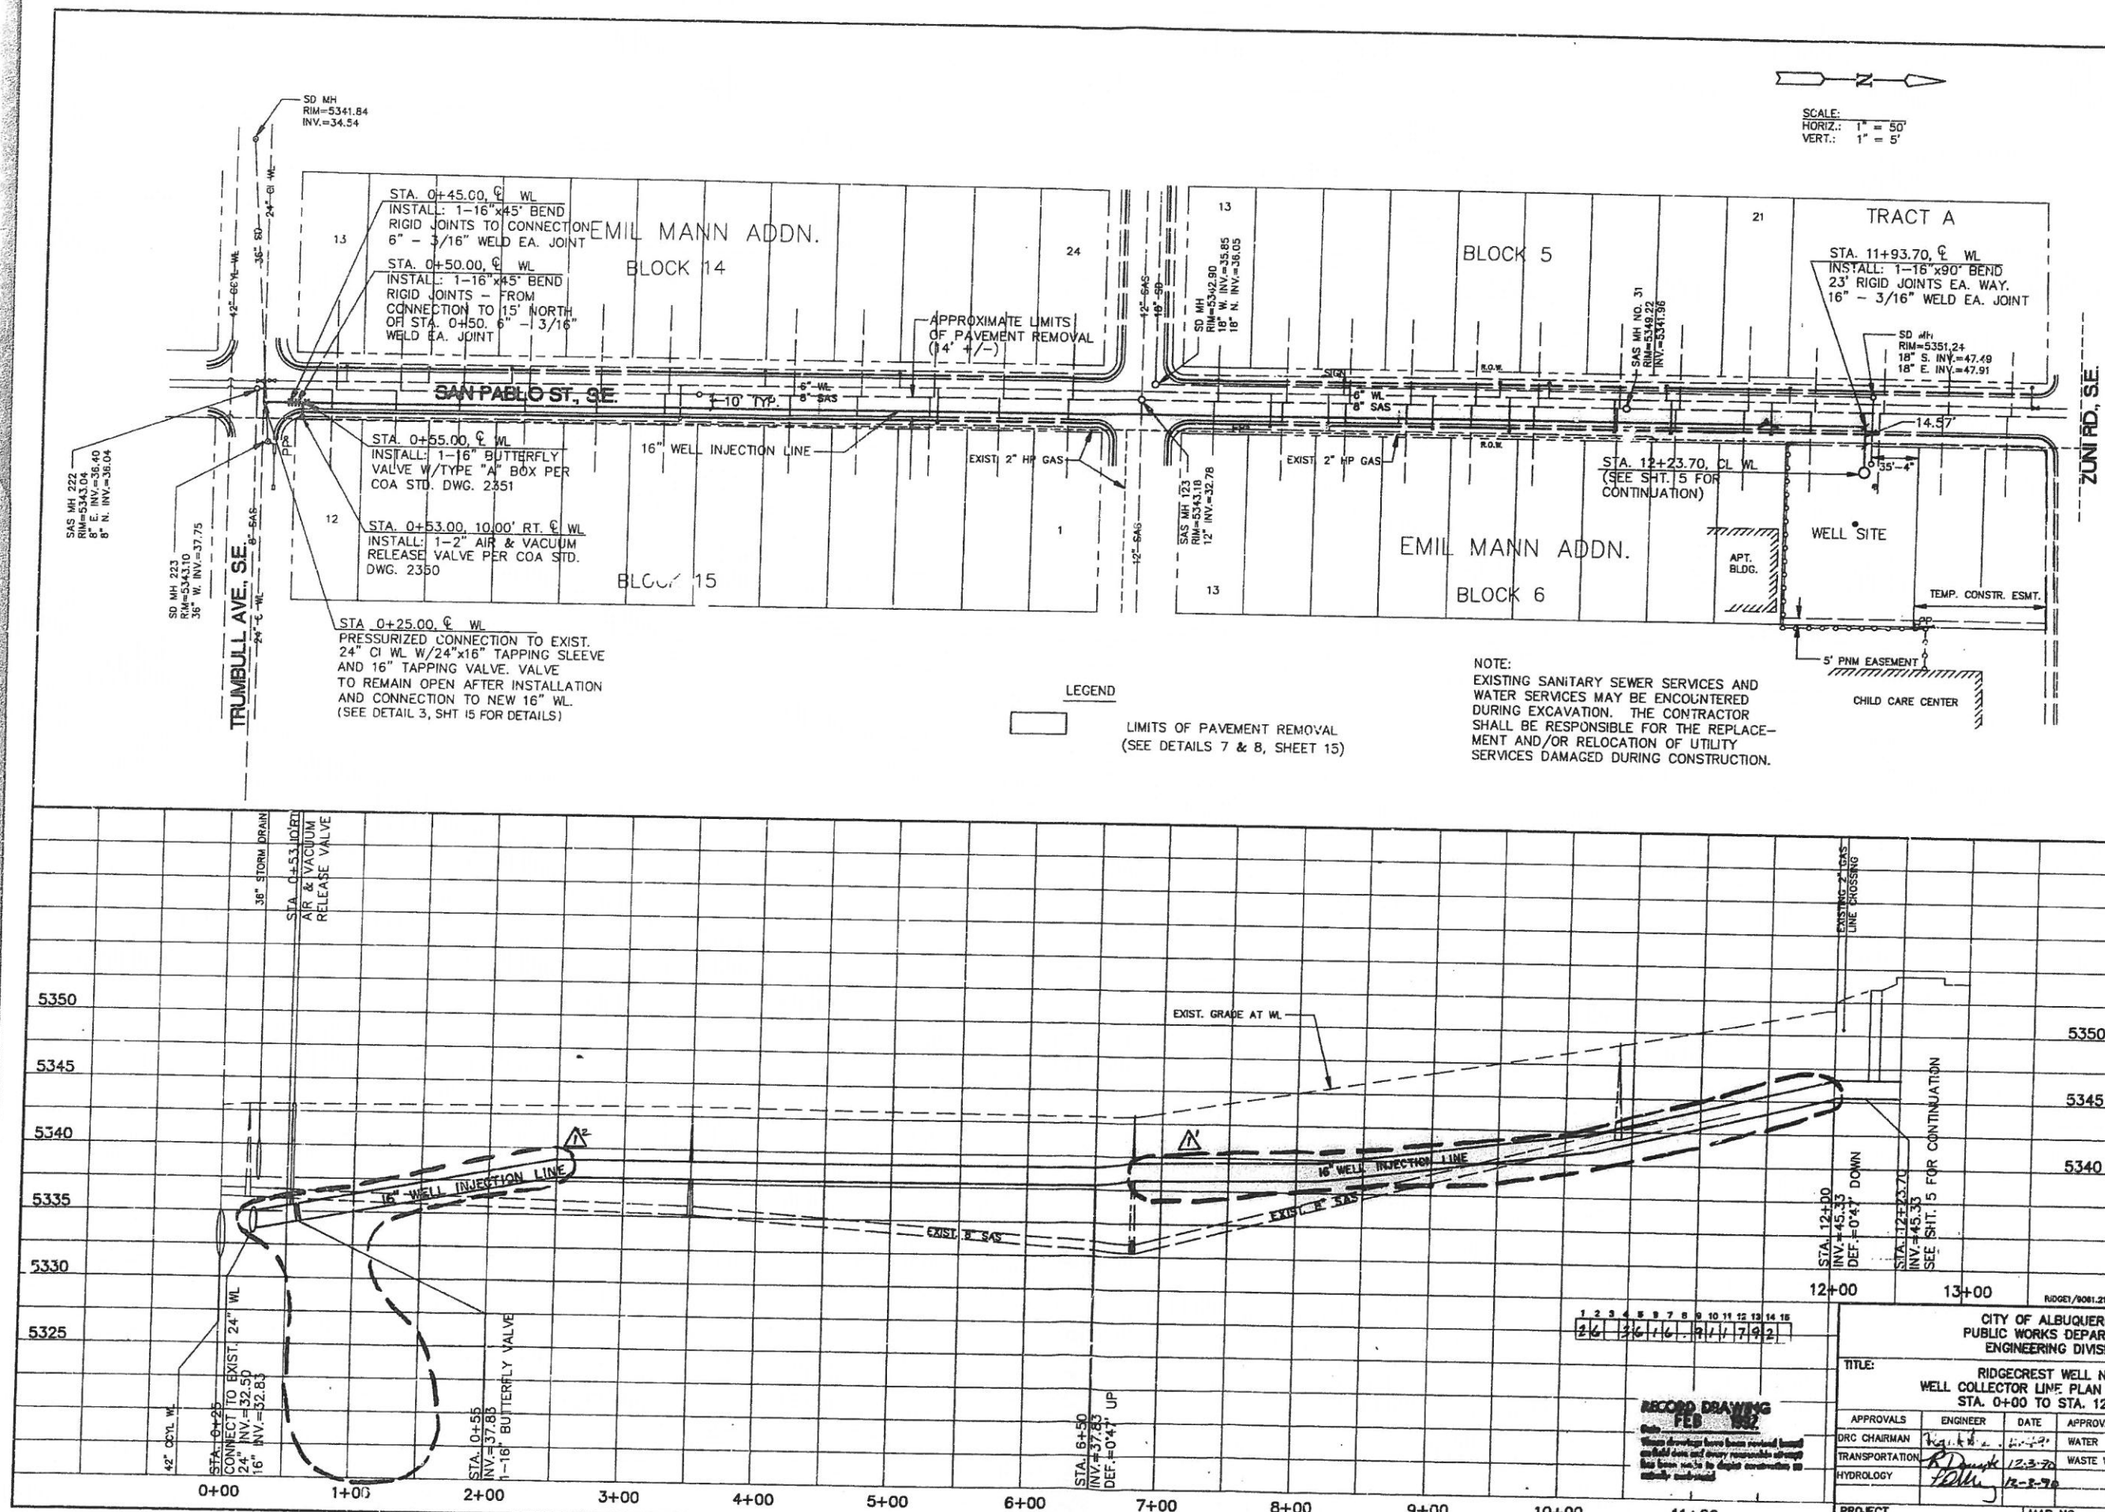

SURVEY INFORMATION
FIELD NOTES

NO.	BY	DATE

BENCH MARKS
THE STATION IS A STANDARD ACS BRASS DISK SET IN A CONCRETE CYLINDER ON THE WEST MEDIAN NOSE AT THE INTERSECTION OF CENTRAL AVENUE AND PENNSYLVANIA BLVD. THE STATION IS STAMPED "6-K19, 1974 ACS". ELEV.=5358.44 (1ST ORDER)

AS BUILT INFORMATION
CONTRACTOR ALBUQUERQUE ASPHALT, INC. DATE 1/91
STAKED BY SOUTHWEST SURVEYS CORP. DATE 1/91
FIELD VERIFIED BY L-H INC DATE 09/16/92
FIELD INSPECTION BY L-H INC DATE 7/91
DRAWINGS COMPILED BY L-H INC DATE 2/92
MICRO-FILM INFORMATION
RECORDED BY DATE
NO.

ENGINEER'S SEAL

NO.	DATE	REMARKS	BY
2	2-92	Modified Profile	L-H

REVISIONS

DESIGN		
DESIGNED BY	T.M	DATE NOV. 90
DRAWN BY	T.M	DATE NOV. 90
CHECKED BY	DKD	DATE NOV. 90

CITY OF ALBUQUERQUE
PUBLIC WORKS DEPARTMENT
ENGINEERING DIVISION

TITLE:
RIDGECREST WELL NO. 5
WELL COLLECTOR LINE PLAN AND PROFILE
STA. 0+00 TO STA. 12+23.70

APPROVALS	ENGINEER	DATE	APPROVALS	ENGINEER	DATE
DRC CHAIRMAN			WATER		12-8-90
TRANSPORTATION		12-3-90	WASTE WATER		12-8-90
HYDROLOGY		12-3-90			

PROJECT NO.	MAP NO.	SHEET	OF
3616.91	L-19	17	17