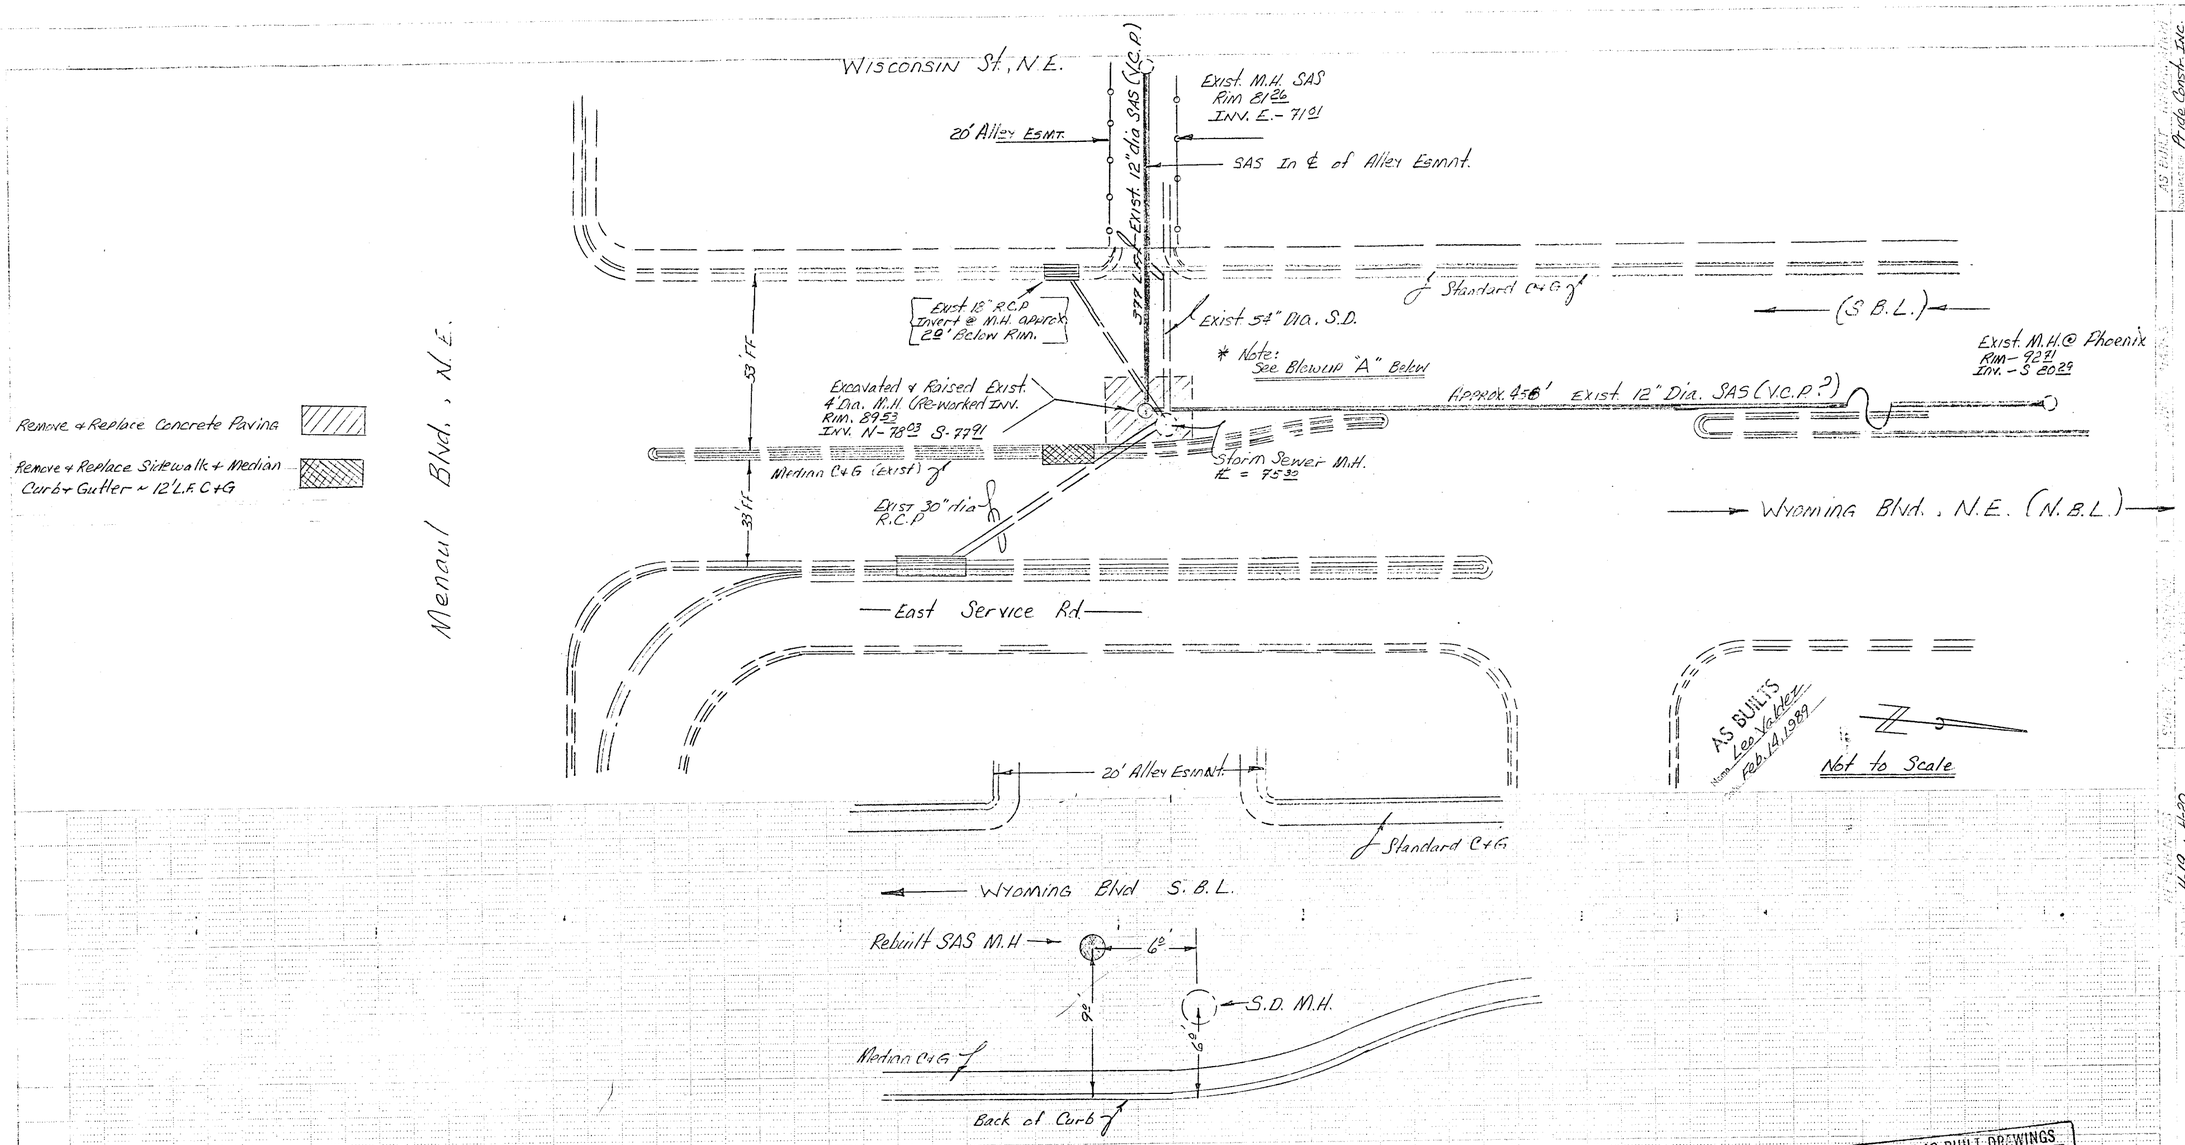

AS BUILTS
Leo Valdez
Feb. 14, 1989

APPROVAL OF AS BUILT DRAWINGS
CHIEF CONSTRUCTION ENGINEER
DATE

1	2	3	4	5	6	7	8	9	10	11	12
2	6		3	7	0	0	0	1	8	9	

APPROVED FOR CONSTRUCTION
CITY ENGINEER DATE

CITY OF ALBUQUERQUE
PUBLIC WORKS DEPARTMENT
ENGINEERING DIVISION

TITLE:

DRAWING	ENGINEER	DATE	APPROVALS	ENGINEER	DATE
City Engineer			Liquid Waste		
A.C.E. Design			Traffic		
A.C.E. Inspection			Water		

DRAWING NO. Bid Lot 3700 ~ P/W 88-2 SHEET 1 OF 1

Pride Const. Inc.
Office of Mins.
Leo Valdez
Leo Valdez

H-19 - H-20

DESIGNED BY
DRAWN BY
CHECKED BY