WATERLINE EXTENSION FOR LANDS OF MARY BACA

LEGEND

MATERIALS

- CONCRETE
- RIP-RAP

LINES

- RIGHT-OF-WAY
- PROPERTY LINE (PLAN)
- RIGHT-OF-WAY (SECTION)
- CENTERLINE
- EASEMENT LINE
- MATCHLINE (A — A)
- SECTION CUT LINE

EARTHWORK

	EXISTING	NEW
CONTOUR LINE	25	
SPOT ELEVATION	⊕	●
PROJECT/PHASE BOUNDARY		
SWALE/DIRECT. OF FLOW		

MISCELLANEOUS UTILITIES

- GAS LINE
- UNDERGROUND TELEPHONE
- UNDERGROUND ELECTRICAL
- STORM DRAIN (SD)
- STORM DRAIN MANHOLE
- STORM DRAIN INLET

SANITARY SEWER (SAS)

- SANITARY LINE (SAS)
- SANITARY MANHOLE
- SERVICE CONNECTIONS
- CAP OR PLUG
- ENCASEMENT

WATER

- CAPS AND PLUGS (W)
- SERVICE CONNECTIONS
- GATE VALVE
- FIRE HYDRANT
- BUTTERFLY VALVE
- REDUCER
- PRESSURE ZONE BOUNDARY
- ELBOW
- CROSS
- TEE

MISCELLANEOUS

- EDGE OF ASPHALT
- FIELD FENCE
- CHAINLINK FENCE
- YARD/BLOCK WALL
- RETAINING WALL
- POWER OR TELE. POLE
- TREE
- TRAFFIC SIGN

INDEX OF DRAWINGS

SHEET NO.	TITLE
1	TITLE, LEGEND, VICINITY MAP, GENERAL NOTES, INDEX OF DRAWINGS
2	PLAN AND PROFILE STA.9+93 TO STA.15+09.98

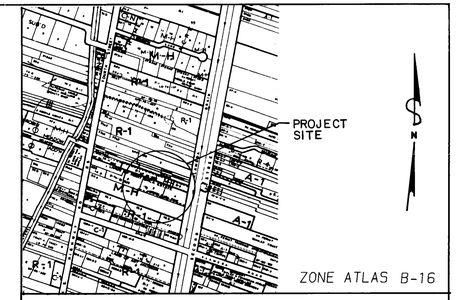

ZONE ATLAS B-16

NOTICE TO CONTRACTORS

1. ALL WORK DETAILED ON THESE PLANS TO BE PERFORMED UNDER CONTRACT SHALL, EXCEPT AS OTHERWISE STATED OR PROVIDED FOR HEREON, BE CONSTRUCTED IN ACCORDANCE WITH THE CITY OF ALBUQUERQUE STANDARD SPECIFICATIONS FOR PUBLIC WORKS CONSTRUCTION 1986.
2. TWO (2) WORKING DAYS PRIOR TO ANY EXCAVATION. THE CONTRACTOR MUST CONTACT LINE LOCATING SERVICE 765-1234, FOR LOCATION EXISTING UTILITIES.
3. PRIOR TO CONSTRUCTION, THE CONTRACTOR SHALL EXCAVATE AND VERIFY THE HORIZONTAL AND VERTICAL LOCATIONS OF ALL OBSTRUCTIONS. SHOULD A CONFLICT EXIST, THE CONTRACTOR SHALL NOTIFY THE ENGINEER OR SURVEYOR SO THAT THE CONFLICT CAN BE RESOLVED WITH MINIMUM AMOUNT OF DELAY.

THE FOLLOWING NOTES ALSO APPLY WHEN CHECKED

- ☐ ALL UTILITIES AND UTILITY SERVICE LINES SHALL BE INSTALLED PRIOR TO PAVING.
- ☐ BACKFILL COMPACTION SHALL BE ACCORDING TO SPECIFIED STREET USE.
- ☐ TACK COAT REQUIREMENTS SHALL BE DETERMINED BY THE CITY ENGINEER.
- ☐ SIDEWALKS AND WHEELCHAIR RAMPS WITHIN THE CURB RETURNS SHALL BE CONSTRUCTED WHEREVER A NEW CURB RETURN IS CONSTRUCTED.
- ☐ IF CURB IS DEPRESSED FOR A DRIVEPAD OR A HANDICAP RAMP, THE DRIVEPAD OR RAMP SHALL BE CONSTRUCTED PRIOR TO ACCEPTANCE OF THE CURB AND GUTTER.
- ☐ ALL STORM DRAINAGE FACILITIES SHALL BE COMPLETED PRIOR TO FINAL ACCEPTANCE.

4. CONTRACTOR SHALL NOTIFY THE ENGINEER NOT LESS THAN SEVEN (7) DAYS PRIOR TO STARTING WORK IN ORDER THAT THE ENGINEER MAY TAKE NECESSARY MEASURES TO INSURE THE PRESERVATION OF SURVEY MONUMENTS. CONTRACTOR SHALL NOT DISTURB PERMANENT SURVEY MONUMENTS WITHOUT THE CONSENT OF THE ENGINEER AND SHALL NOTIFY THE ENGINEER AND BEAR THE EXPENSE OF REPLACING ANY THAT MAY BE DISTURBED WITHOUT PERMISSION. REPLACEMENT SHALL BE DONE ONLY BY THE ENGINEER. WHEN A CHANGE IS MADE IN THE FINISHED ELEVATION OF THE PAVEMENT OF ANY ROADWAY IN WHICH A PERMANENT SURVEY MONUMENT IS LOCATED, CONTRACTOR SHALL, AT HIS OWN EXPENSE, ADJUST THE MONUMENT COVER TO THE NEW GRADE UNLESS OTHERWISE SPECIFIED.
5. TRAFFIC CONTROL
   THREE (3) WORKING DAYS PRIOR TO BEGINNING CONSTRUCTION THE CONTRACTOR SHALL SUBMIT TO TRAFFIC ENGINEERING DIVISION A DETAILED CONSTRUCTION SCHEDULE. TWO (2) WORKING DAYS PRIOR TO CONSTRUCTION THE CONTRACTOR SHALL OBTAIN A BARRICADING PERMIT FROM THE TRAFFIC ENGINEERING DIVISION. CONTRACTOR SHALL NOTIFY BARRICADE ENGINEER (768-2551) PRIOR TO OCCUPYING AN INTERSECTION.

APPROVED
CITY TRAFFIC ENGINEER
BY _____
DATE _____

1 2 3 4 5 6 7 8 9 10 11 12
2G 3747 0190

12-3-89	CITY OF ALBUQUERQUE	APPROVED FOR CONSTRUCTION CITY ENGINEER 12-21-89
	DRAWING NO. 3747 / MAP NO. B-16	SHEET 1 OF 2

LANDS OF MARY BACA ESTATE

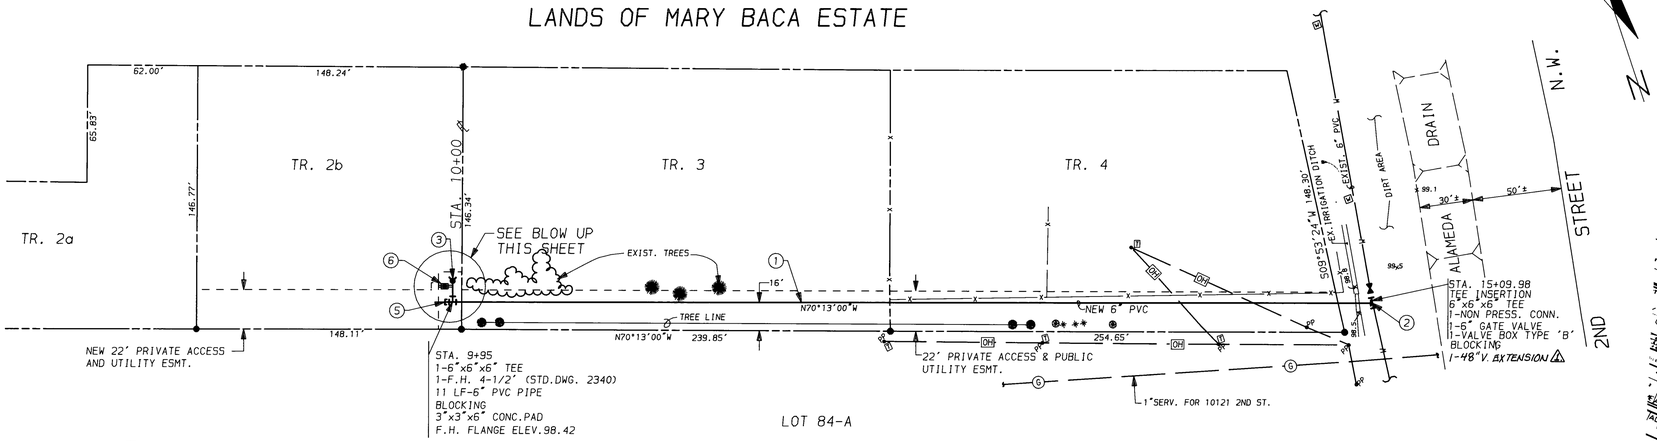

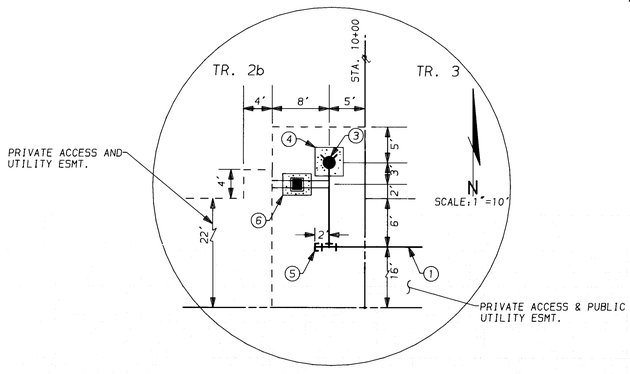

SCALE: 1"=40' HORIZ.
1"=5' VERT.

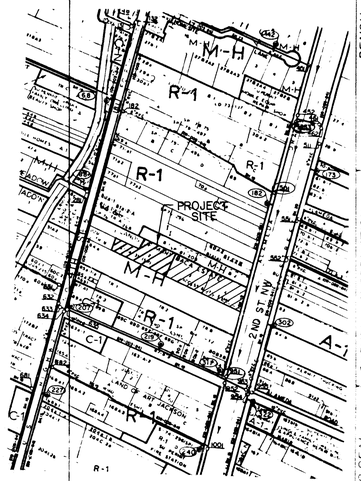

WATER SHUTOFF REQUIREMENTS

NOTE: THE CONTRACTOR SHALL BE RESPONSIBLE FOR THE COORDINATION WITH THE WATER SYSTEM DIVISION FOR THE EXECUTION OF THE VALVE SHUT-OFF PLAN. THIS COORDINATION MUST BE DONE NOT LESS THAN THREE (3) WORKING DAYS IN ADVANCE OF ANY WORK THAT MAY AFFECT THE EXISTING WATER UTILITIES.

WATER SHUTOFF NOTES:

VALVES B-16 NO 951, 501 AND 453 SHALL BE CLOSED TO EFFECT THIS INSTALLATION

CONSTRUCTION NOTES

1. INSTALL NEW 6" PVC PIPE
2. EXACT LOCATION OF EXISTING LINE SHALL BE VERIFIED BY THE CONTRACTOR IN THE FIELD.
3. BUILD FIRE HYDRANT 4-1/2' BURY AS PER CITY OF ALBUQUERQUE STD. DETAIL DWG. 2340.
4. BUILD CONCRETE PAD 3'x3'x6" AROUND FIRE HYDRANT.
5. INSTALL 6" PLUG AT WEST END OF LINE WITH BLOCKING.
6. CONSTRUCT DOUBLE 3/4" WATER SERVICE PER CITY OF ALBUQUERQUE STD. DETAIL DWG. 2362.

LEGEND

- NEW 6" WATERLINE
- EXIST. WATERLINE
- EXIST. WATER METER
- EXIST. TREES

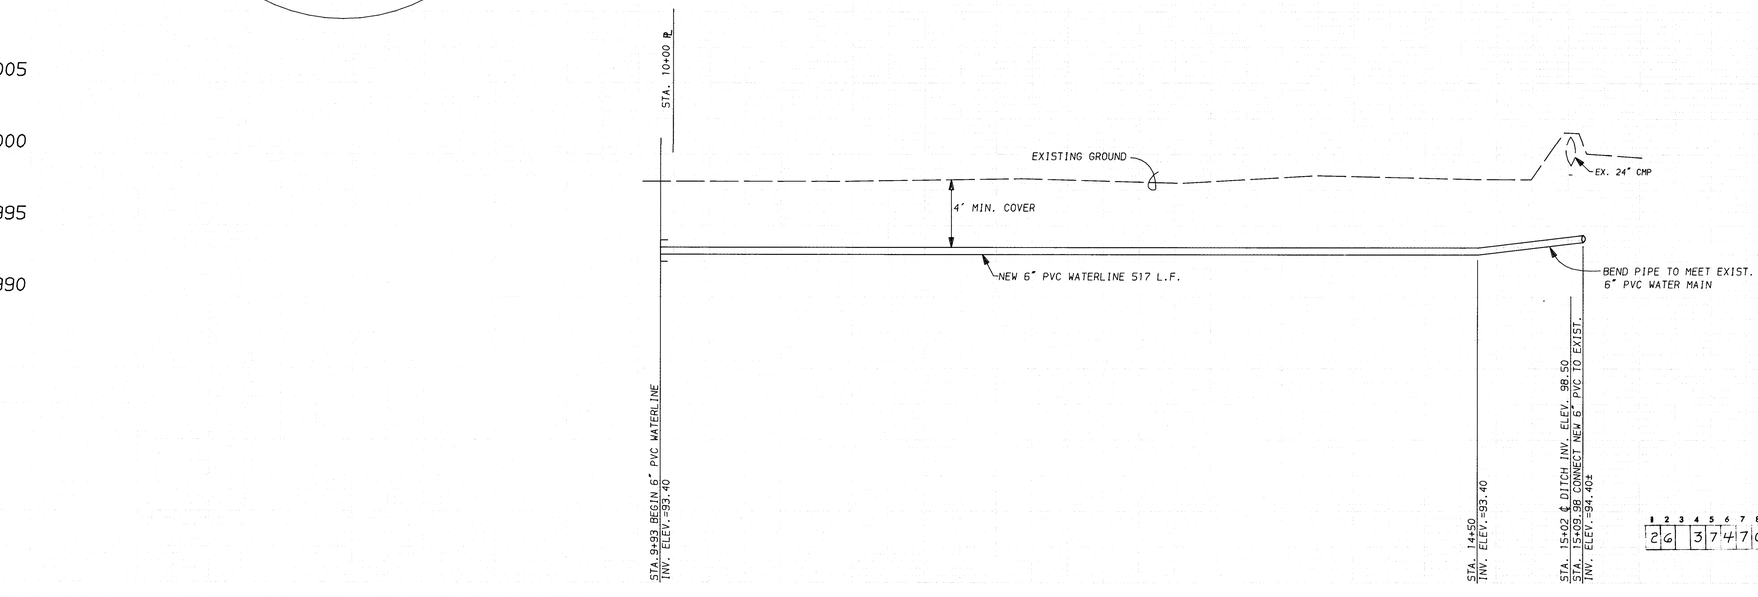

AS BUILT INFORMATION
Rodgers Plumbing
MAEPHEW JAN 3/90
LATL
CORRECTED BY E.N.
DATE 3/90
MICRO-FILM INFORMATION

BENCH MARKS

SURVEY INFORMATION

NO | BY | DATE

ACS-5-B16 LOCATED ON THE EAST SIDE OF FOURTH STREET AT THE SOUTHWEST CORNER OF ALAMEDA COMMUNITY CENTER, APPROXIMATELY 245' NORTH OF GOLDEN MEADOW DRIVE. A "+" CUT ON TOP OF THE NORTHEAST CORNER OF THE CONCRETE HEADWALL.
ELEV. = 5001.74

ENGINEER'S SEAL

Rec. Dec. 12-3-89

NO	BY	DATE	REMARKS
	E.N.	8/89	
4/90			Revised from As-Built Markup

REVISIONS
DESIGN — DATE 8/89
DESIGNED BY J.CURTIN
DRAWN BY D.ZAMORA — DATE 8/89
CHECKED BY J. CURTIN — DATE 8/89

CITY OF ALBUQUERQUE
PUBLIC WORKS DEPARTMENT
ENGINEERING GROUP

TITLE: WATERLINE EXTENSION FOR LANDS OF MARY BACA WEST OF 2ND ST. NORTH OF ALAMEDA RD. TO SERVE TR. 2A & 2B

APPROVALS	ENGINEER	DATE	ENGINEER	DATE
D.R.C. Chair	Roger D. Green	9-26-89		
Trans. Dev.	R Bank	9-25-89		
Utility Dev.	R.W. Kane	9-25-89		

DRAWING NO. 3747 | MAP NO B-16 | SHEET 2 OF 2

1 2 3 4 5 6 7 8 9 10 11 12
2 6 3 7 4 7 0 2 9 10