




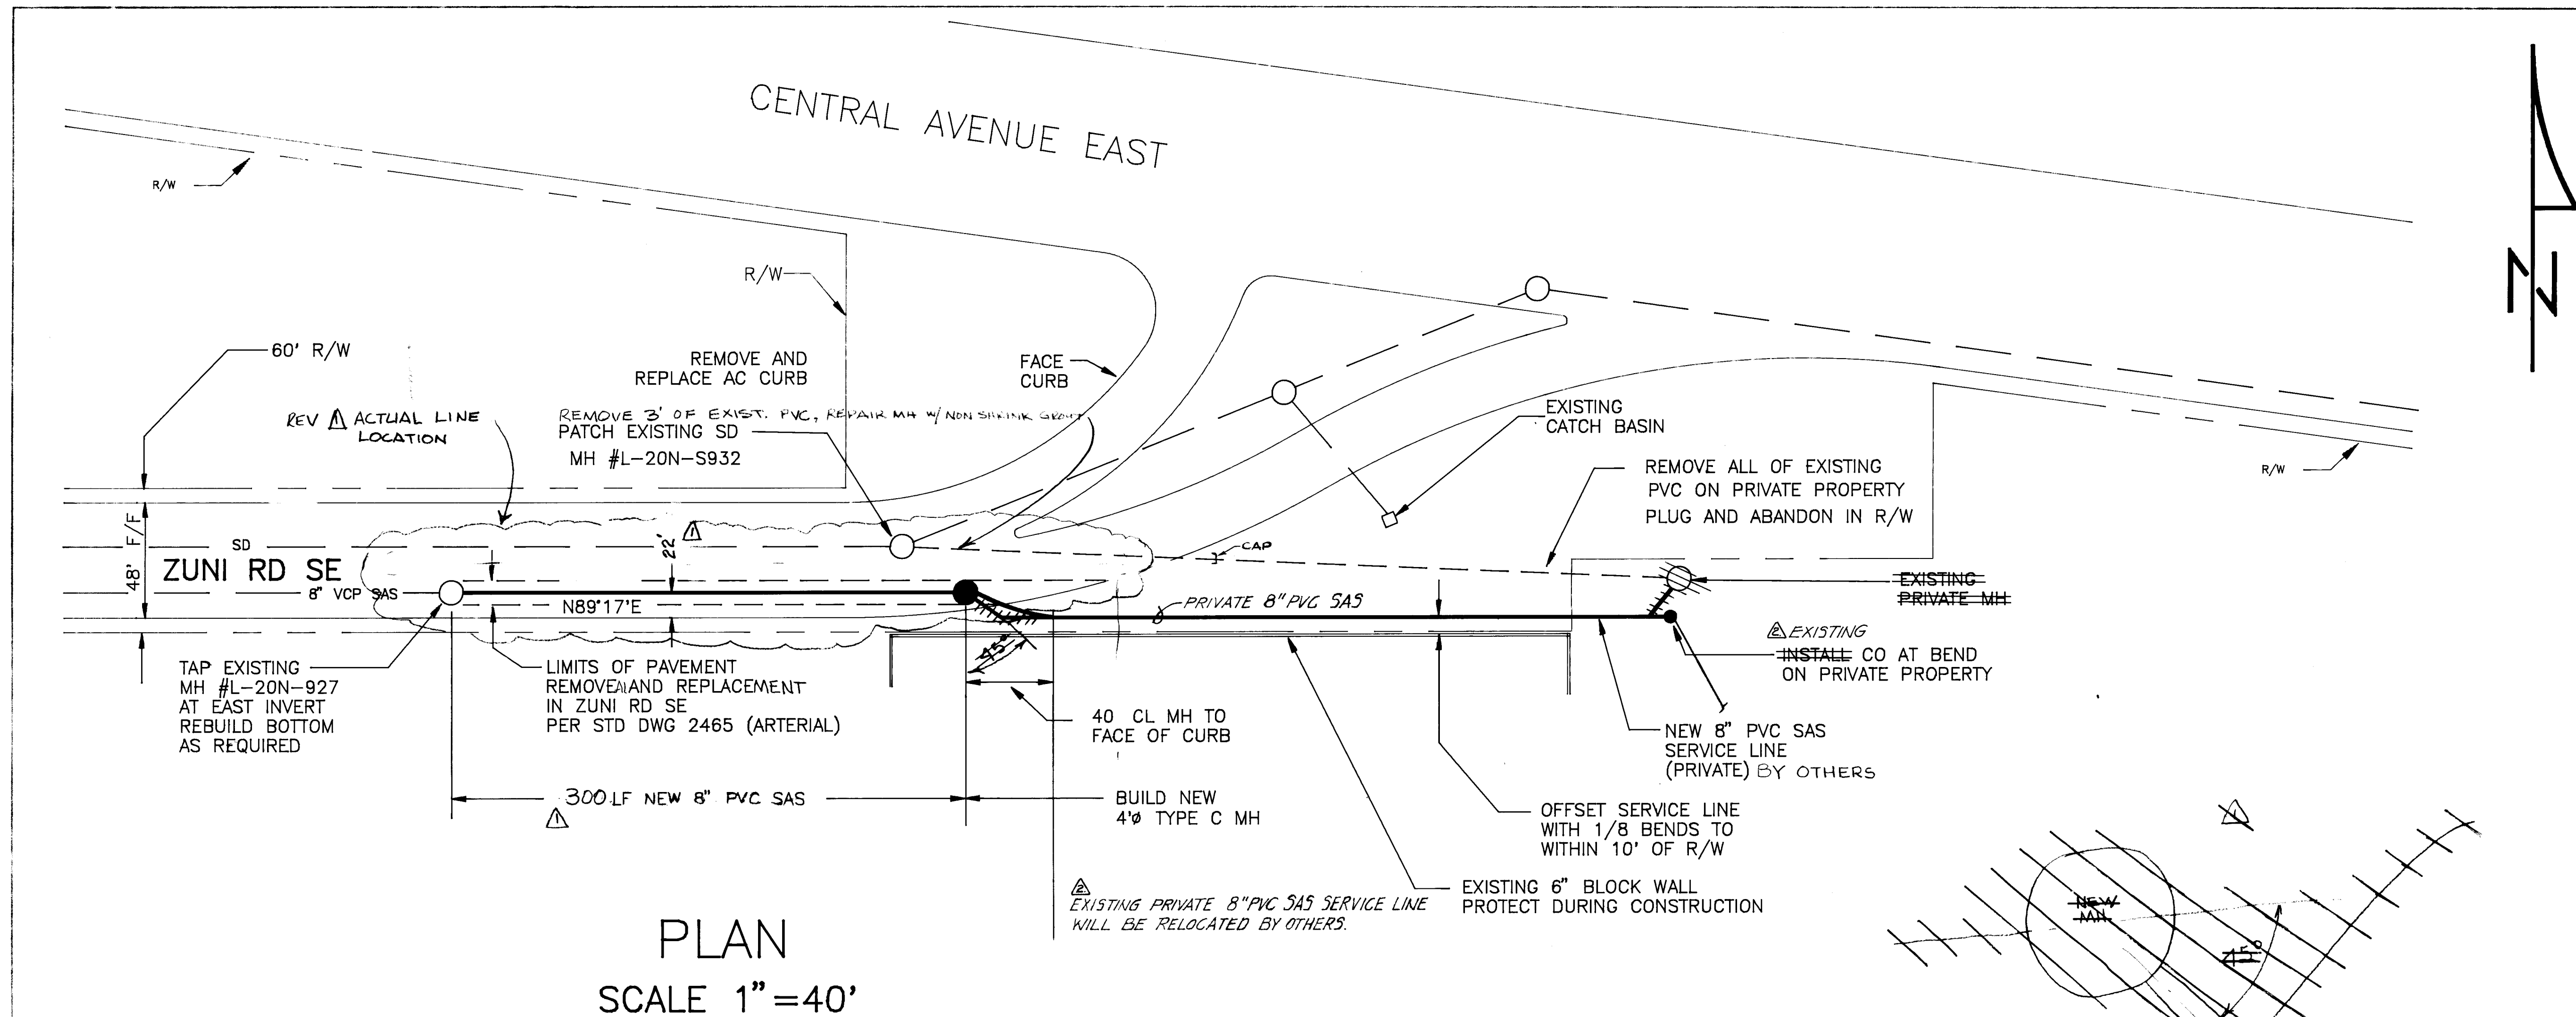

PLAN
SCALE 1"=40'

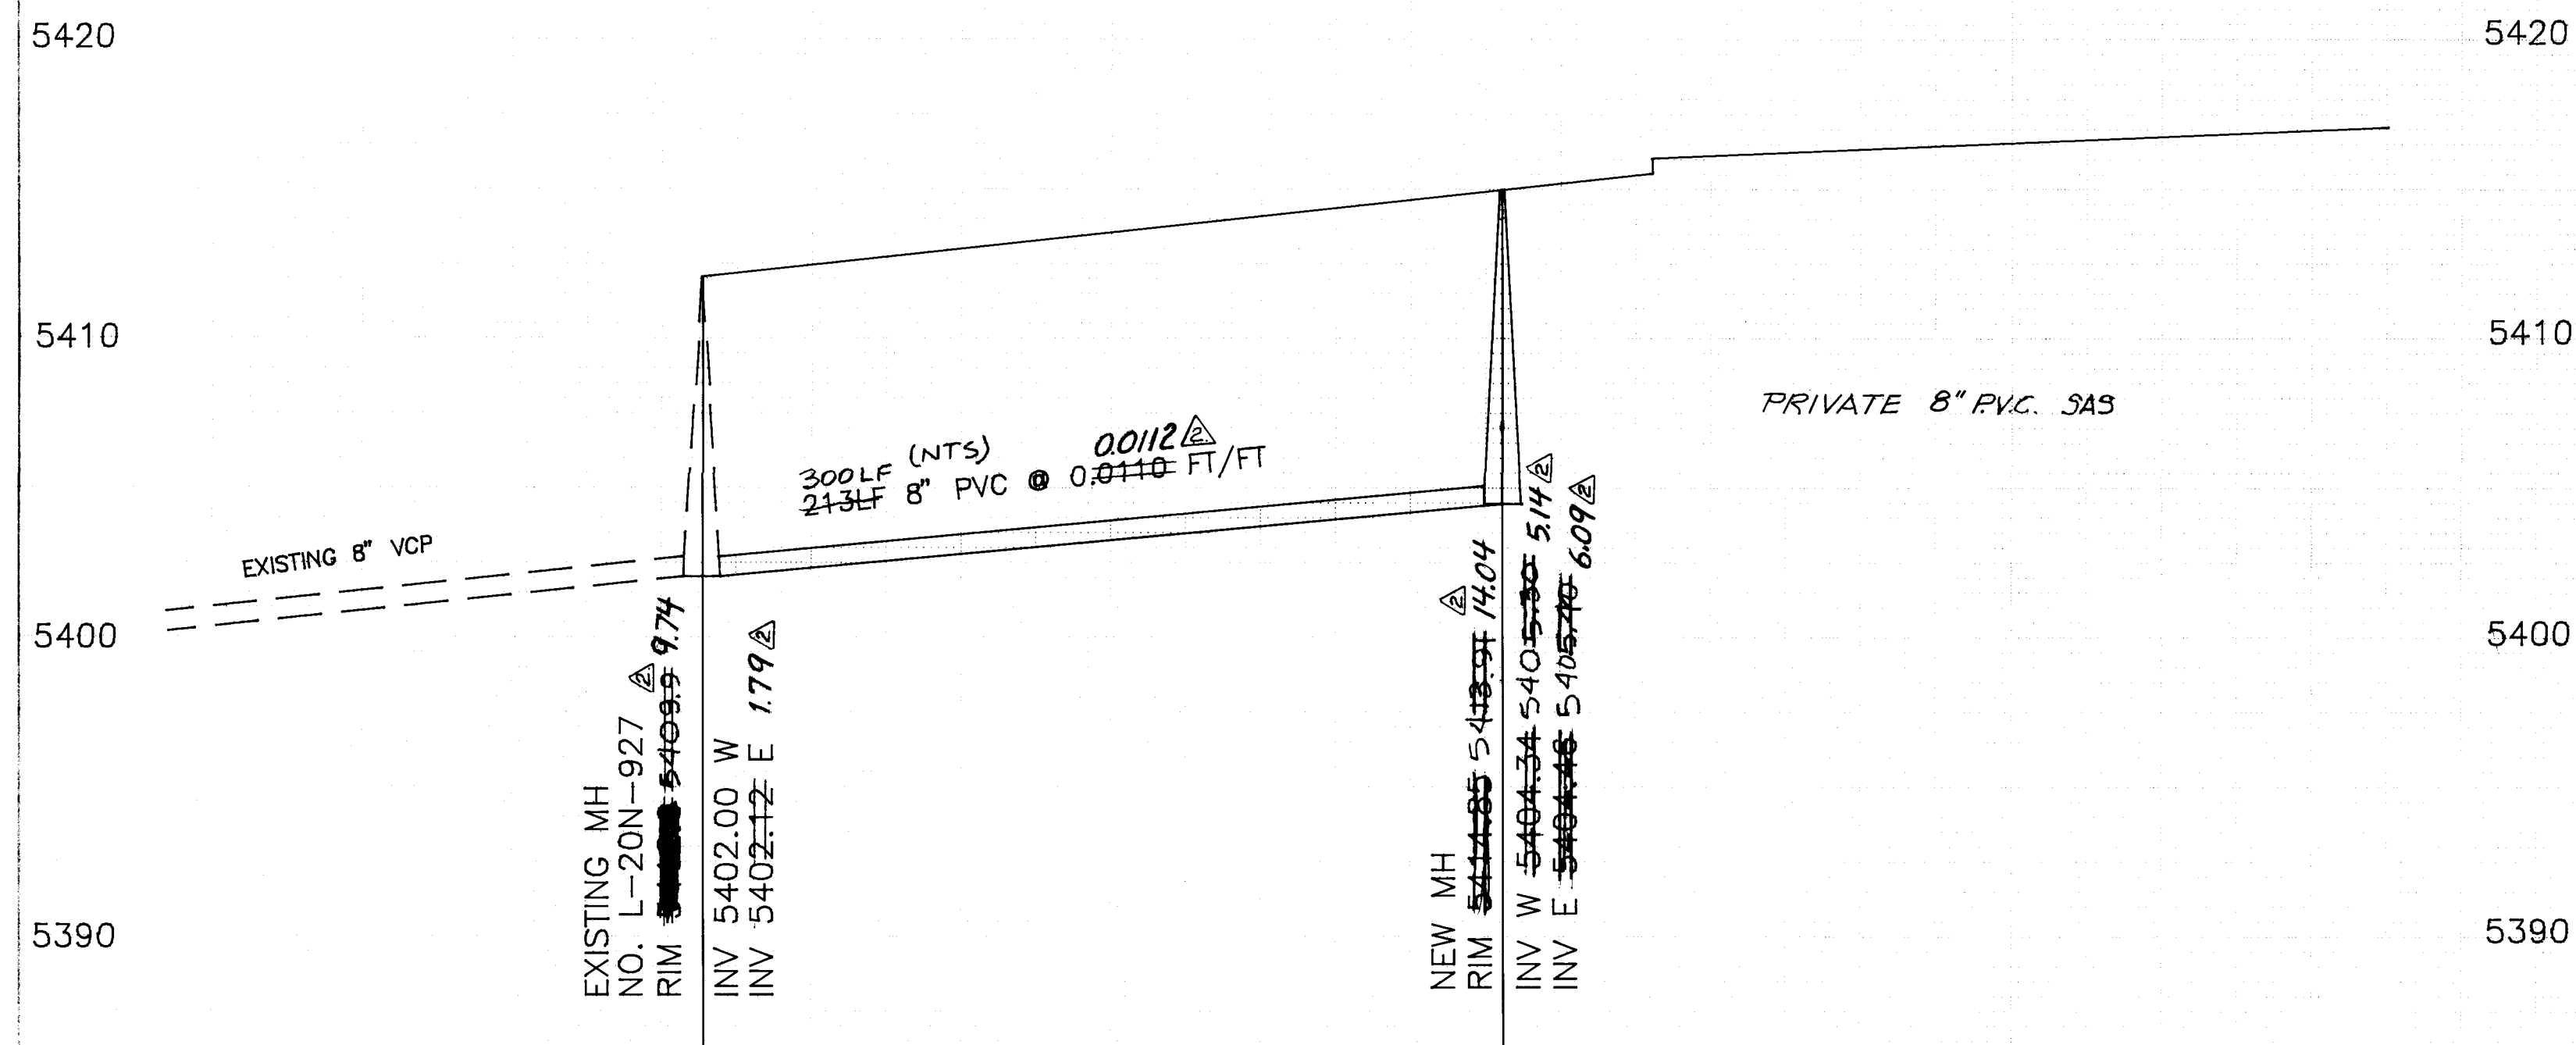

PROFILE
SCALE H 1"=40'
V 1"=5'

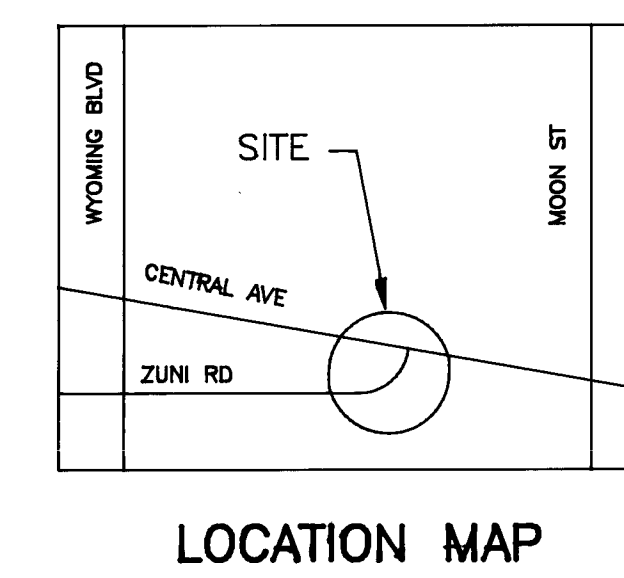

NOTES:

ALL WORK DETAILED ON THESE PLANS TO BE PERFORMED UNDER CONTRACT SHALL BE CONSTRUCTED IN ACCORDANCE WITH THE CITY OF ALBUQUERQUE STANDARD SPECIFICATIONS CONTRACT, 1986.

TWO (2) WORKING DAYS PRIOR TO ANY EXCAVATION, CONTRACTOR MUST CONTACT LINE LOCATING SERVICE, 765-1234, FOR LOCATION OF EXISTING UTILITIES.

PRIOR TO CONSTRUCTION, THE CONTRACTOR SHALL EXCAVATE AND VERIFY THE HORIZONTAL AND VERTICAL LOCATIONS OF ALL OBSTRUCTIONS SHOULD A CONFLICT EXIST, THE CONTRACTOR SHALL NOTIFY THE ENGINEER OR SURVEYOR SO THAT THE CONFLICT CAN BE RESOLVED WITH A MINIMUM AMOUNT OF DELAY.

ALL UTILITIES AND UTILITY SERVICE LINES SHALL BE INSTALLED PRIOR TO PAVING.

BACKFILL AND COMPACTION SHALL BE ACCORDING TO ARTERIAL STREET USE

THREE (3) DAYS PRIOR TO BEGINNING CONSTRUCTION, THE CONTRACTOR SHALL SUBMIT TO TRAFFIC ENGINEERING A DETAILED CONSTRUCTION SCHEDULE.

TWO (2) DAYS PRIOR TO CONSTRUCTION, THE CONTRACTOR SHALL OBTAIN A BARRICADE PERMIT FROM TRAFFIC ENGINEERING.

CONTRACTOR SHALL NOTIFY BARRICADE ENGINEER, 765-2551, PRIOR TO OCCUPYING AN INTERSECTION.

REV	1/1	DATE	6/1/89	USER DEPT.	N/A	DATE	
APPROVAL OF REVISIONS							

DAN ARMSTRONG, PE PO BOX 25722 ALBUQUERQUE, NM 87125 842-5992		APPROVED FOR CONSTRUCTION 5-25-89	
3784		SHEET 1 OF 1	

DAN ARMSTRONG, PE
PO BOX 25722
ALBUQUERQUE, NM 87125
842-5992

CITY OF ALBUQUERQUE PUBLIC WORKS DEPARTMENT ENGINEERING GROUP			
TITLE: 1989 SANITARY SEWER EXTENSION ZUNI ROAD SE @ CENTRAL			
APPROVALS	ENGINEER	DATE	APPROVALS
D.R.C. Chair	6/1/89	6/1/89	
Trans. Dev.			
Utility Dev.			
DRAWING NO.	3784	MAP NO.	L-20N
SHEET 1 OF 1			