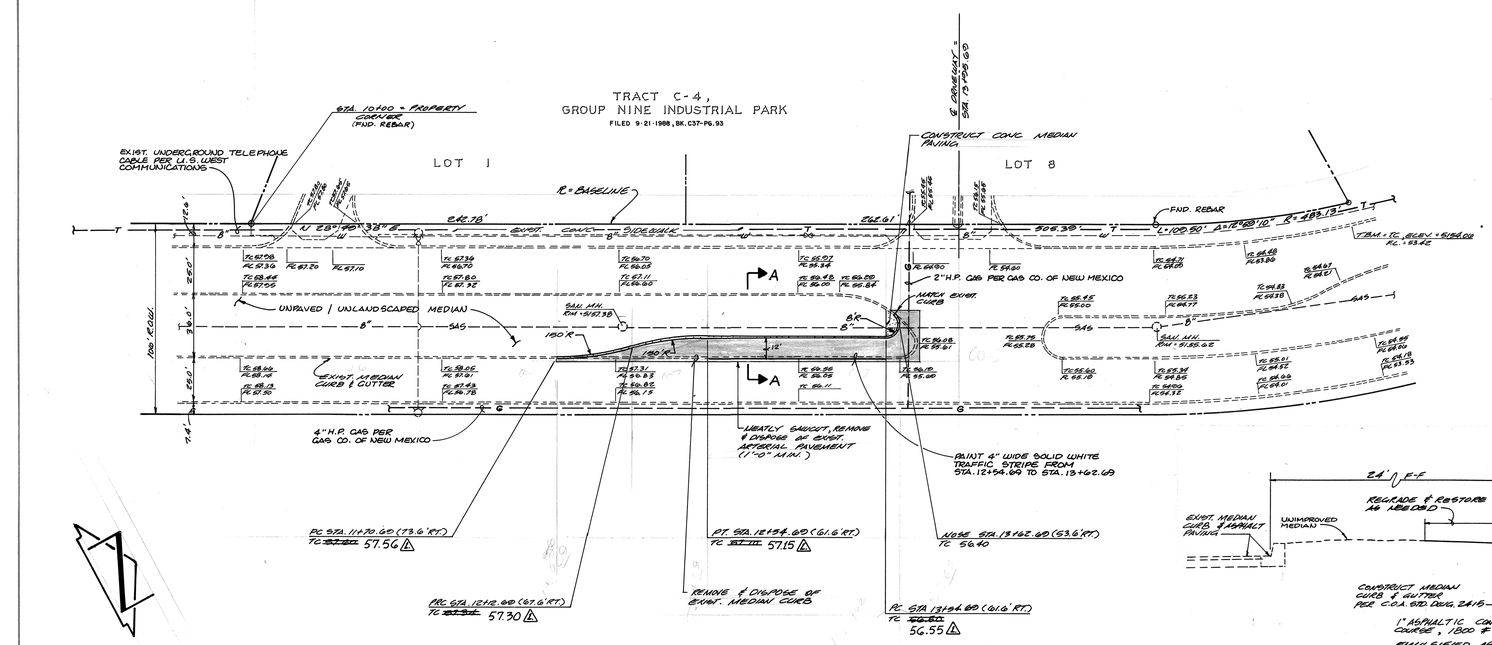

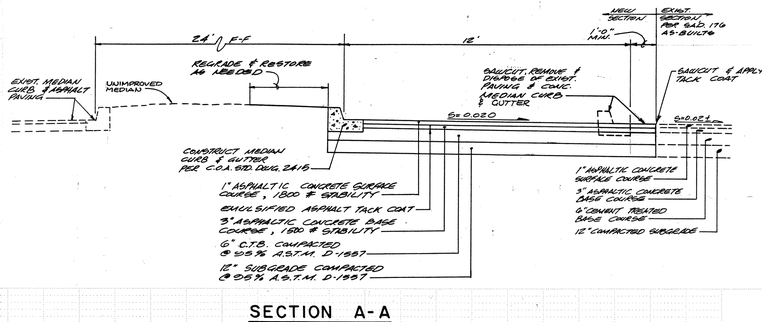

SECTION A-A

SCALE : 1"= 3'

HORIZONTAL SCALE : 1"= 40'
VERTICAL SCALE : 1"= 10'

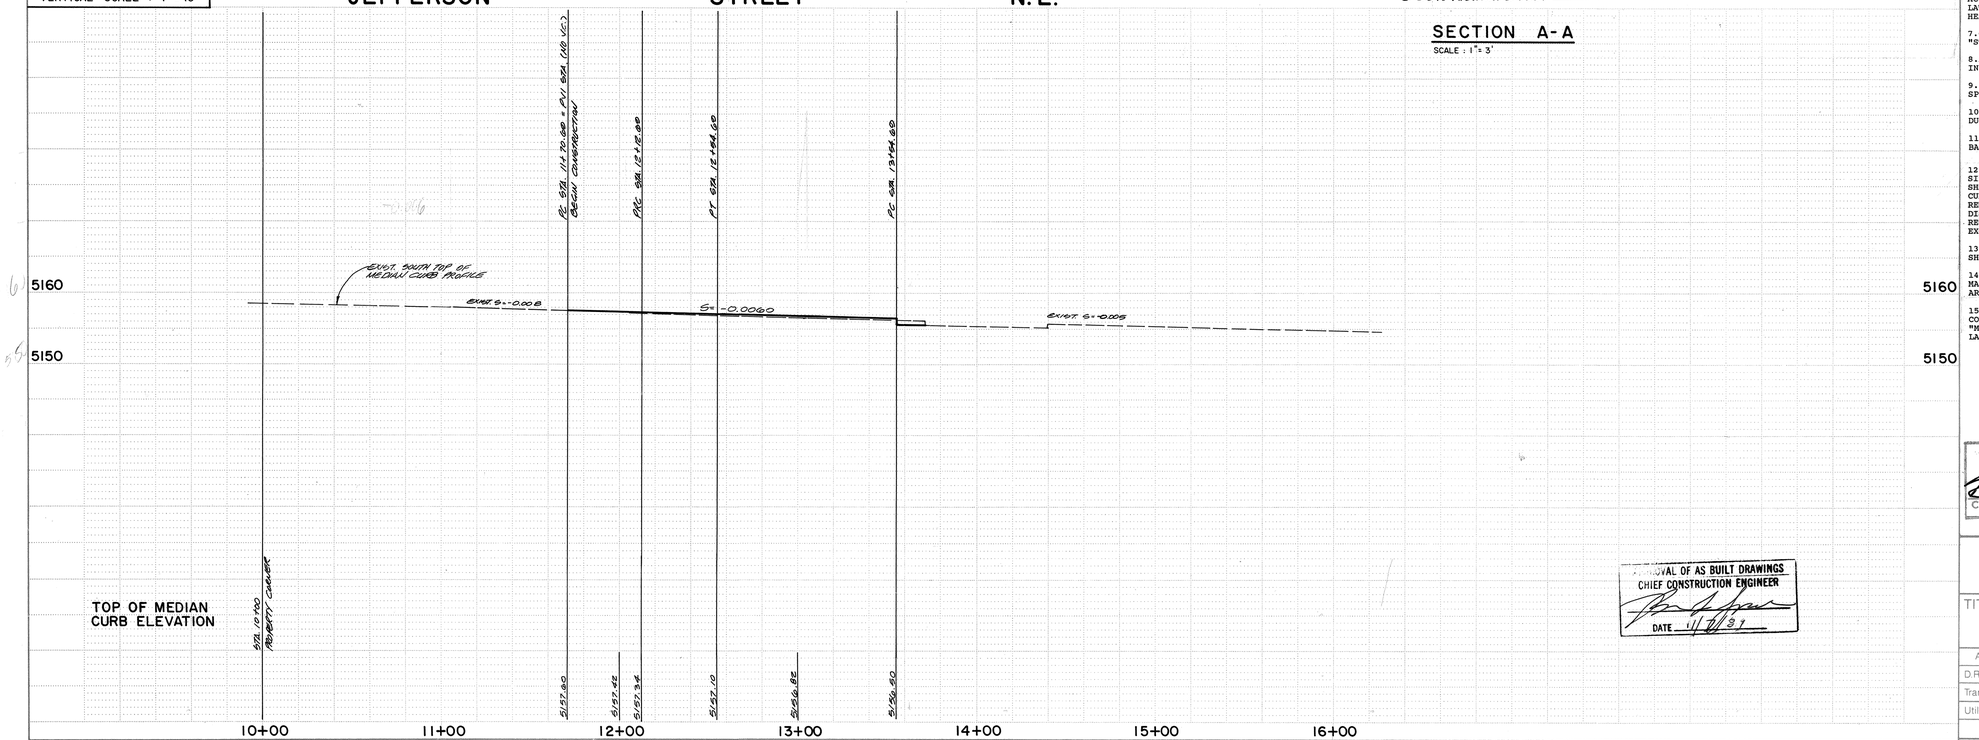

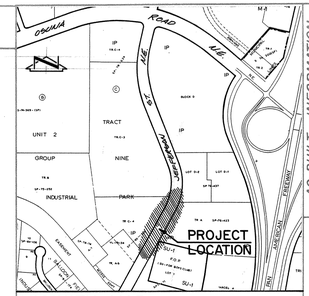

VICINITY MAP

SCALE : 1"= 800'

E-17

GENERAL NOTES:

1. ALL WORK DETAILED ON THESE PLANS TO BE PERFORMED UNDER CONTRACT SHALL, EXCEPT AS OTHERWISE STATED OR PROVIDED FOR HEREON, BE CONSTRUCTED IN ACCORDANCE WITH THE CITY OF ALBUQUERQUE STANDARD SPECIFICATIONS - PUBLIC WORKS CONSTRUCTION - 1986.

2. TWO (2) WORKING DAYS PRIOR TO ANY EXCAVATION, CONTRACTOR MUST CONTACT LINE LOCATING SERVICE, 765-1234, FOR LOCATION OF EXISTING UTILITIES.

3. IF ANY UTILITY LINES, PIPELINES, OR UNDERGROUND UTILITY LINES ARE SHOWN ON THESE DRAWINGS, THEY ARE SHOWN IN AN APPROXIMATE MANNER ONLY, AND SUCH LINES MAY EXIST WHERE NONE ARE SHOWN. IF ANY SUCH EXISTING LINES ARE SHOWN, THE LOCATION IS BASED UPON INFORMATION PROVIDED BY THE OWNER OF SAID UTILITY, AND THE INFORMATION MAY BE INCOMPLETE, OR MAY BE OBSOLETE BY THE TIME CONSTRUCTION COMMENCES. THE ENGINEER HAS CONDUCTED ONLY PRELIMINARY INVESTIGATION OF THE LOCATION, DEPTH, SIZE, OR TYPE OF EXISTING UTILITY LINES, PIPELINES, OR UNDERGROUND UTILITY LINES. THIS INVESTIGATION IS NOT CONCLUSIVE, AND MAY NOT BE COMPLETE, THEREFORE, MAKES NO REPRESENTATION PERTAINING THERETO, AND ASSUMES NO RESPONSIBILITY OR LIABILITY THEREFOR. THE CONTRACTOR SHALL INFORM ITSELF OF THE LOCATION OF ANY UTILITY LINE, PIPELINE, OR UNDERGROUND UTILITY LINE IN OR NEAR THE AREA OF THE WORK IN ADVANCE OF AND DURING EXCAVATION WORK. THE CONTRACTOR IS FULLY RESPONSIBLE FOR ANY AND ALL DAMAGE CAUSED BY ITS FAILURE TO LOCATE, IDENTIFY AND PRESERVE ANY AND ALL EXISTING UTILITIES, PIPELINES, AND UNDERGROUND UTILITY LINES. IN PLANNING AND CONDUCTING EXCAVATION, THE CONTRACTOR SHALL COMPLY WITH STATE STATUTES, MUNICIPAL AND LOCAL ORDINANCES, RULES AND REGULATIONS, IF ANY, PERTAINING TO THE LOCATION OF THESE LINES AND FACILITIES.

4. SHOULD A CONFLICT EXIST BETWEEN THESE PLANS AND ACTUAL FIELD CONDITIONS, THE CONTRACTOR SHALL PROMPTLY NOTIFY THE ENGINEER IN WRITING SO THAT THE CONFLICT CAN BE RESOLVED WITH A MINIMUM AMOUNT OF DELAY FOR ALL PARTIES.

5. THE CONTRACTOR SHALL MAINTAIN ACCESS TO ADJACENT PROPERTIES DURING CONSTRUCTION.

6. ALL WORK ON THIS PROJECT SHALL BE PERFORMED IN ACCORDANCE WITH APPLICABLE FEDERAL, STATE AND LOCAL LAWS, RULES AND REGULATIONS CONCERNING SAFETY AND HEALTH.

7. CONTRACTOR SHALL COMPLY WITH SECTION 19 OF THE "STANDARD SPECIFICATIONS".

8. ALL UTILITIES AND UTILITY SERVICE LINES SHALL BE INSTALLED PRIOR TO PAVING.

9. BACKFILL COMPACTION SHALL BE ACCORDING TO SPECIFIED STREET USE.

10. TACK COAT REQUIREMENTS SHALL BE DETERMINED DURING CONSTRUCTION BY THE PROJECT ENGINEER.

11. ALL SLOPES AS SHOWN ON PROFILES ARE BASED ON BASELINE STATIONING UNLESS OTHERWISE NOTED.

12. WHERE REMOVAL OF EXISTING CURB AND GUTTER, SIDEWALK OR PAVEMENT IS REQUIRED, THE CONTRACTOR SHALL SAWCUT AND/OR REMOVE TO THE NEAREST JOINT. CURB AND GUTTER SHOWN AS EXISTING AND NOT TO BE REMOVED UNDER THIS CONTRACT WHICH IS DAMAGED OR DISPLACED BY THE CONTRACTOR SHALL BE REMOVED AND REPLACED BY THE CONTRACTOR AT THE CONTRACTOR'S EXPENSE.

13. ALL DIMENSIONS OF CURB AND CURB RETURNS ARE SHOWN TO FACE OF CURB.

14. ALL WATER VALVE BOXES, WATER METER BOXES AND MANHOLES ENCOUNTERED WITHIN THE PROPOSED PROJECT AREA SHALL BE ADJUSTED TO FINISH GRADE.

15. ALL NEW PAVEMENT MARKINGS WILL BE REQUIRED TO BE COMPLETED BY THE CONTRACTOR IN ACCORDANCE WITH THE "MANUAL FOR TRAFFIC CONTROL DEVICES" (MUTCD), LATEST EDITION.

1 2 3 4 5 6 7 8 9 10 11 12
2 6 3 8 7 0 0 1 8 9

APPROVED FOR CONSTRUCTION
CITY ENGINEER 9-20-89 DATE

APPROVAL OF AS BUILT DRAWINGS
CHIEF CONSTRUCTION ENGINEER
DATE 11/13/89

JOB No. 890224

SURVEY INFORMATION — FIELD NOTES — NO. — BY — DATE

BENCH MARKS

AS BUILT INFORMATION
CONTRACTOR SUNDANCE MECH. — DATE
WORK STAKED BY — DATE
INSPECTIONS PERFORMED BY S.E. MOYA — DATE 10/89
FIELD VERIFICATION BY — DATE
CALCULATIONS CORRECTED BY E.N. — DATE 10/89
MICRO-FILM INFORMATION
RECORDED BY — DATE
NO.

ENGINEER'S SEAL
ROGER G. MORTENSEN — NEW MEXICO — 6547 — REGISTERED PROFESSIONAL ENGINEER
06-9-89

REVISIONS

NO.	DATE	REMARKS	BY
1	10/10/89	Revised from "As-Built" Information	E.N.

DESIGN	DATE	
DESIGNED BY	J.G.M.	6-1989
DRAWN BY	C.V.M.	6-1989
CHECKED BY	J.G.M.	6-1989

CITY OF ALBUQUERQUE
PUBLIC WORKS DEPARTMENT
ENGINEERING GROUP

TITLE: JEFFERSON COURT
JEFFERSON ST. N.E. LEFT TURNBAY

APPROVALS	ENGINEER	DATE	APPROVALS	ENGINEER	DATE
D.R.C. Chair		7/20/89			
Trans. Dev.		7-18-89			
Utility Dev.		7-18-89			

DRAWING NO. 3870 — MAP NO. E-17 — SHEET 1 OF 1

RELEASED BY PUBLIC WORKS DEPT. FOR CONSTRUCTION
NOTICE: SIGNATURE AND SEAL ON THIS SHEET CONSTITUTE SIGNATURE AND SEAL ON ALL SHEETS