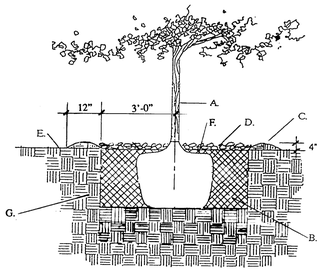


GENERAL NOTES

1. Rootball shall be placed on undisturbed soil.
2. Top of rootball indicates level at which tree was grown and dug; this represents the level at which the tree should be installed; that level may be exceeded by only a one inch layer of soil.
3. Prior to backfilling tree, all wire, rope and synthetic materials shall be removed from the tree and the planting pit.
4. Prior to backfilling, all burlap shall be cut away except from the bottom of the rootball.

CONSTRUCTION NOTES

A. Tree.
~~B. Planting soil mixture (Reference the Specifications).~~
C. Earth berm around water retention basin.
D. 4" depth of bark mulch.
E. Finish grade. 4" CRUSHED SAND
F. Water retention basin.
G. Undisturbed soil.

## 1/1 TREE PLANTING DETAIL

SCALE: NTS




GENERAL NOTES

1. The outside diameter of the water retention basin shall be twice the diameter of the shrub planting pit.

CONSTRUCTION NOTES

A. Shrub.
~~B. Planting soil mixture (Reference the Specifications).~~
C. Water retention basin.
D. 4" depth of bark mulch.
E. Finish grade. 4" CRUSHED SAND
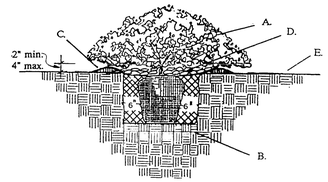
## 2/1 SHRUB PLANTING DETAIL

SCALE: NTS

## PLANTING NOTES:

1. NO PLANT MATERIAL TO BE PLACED WITHIN 30' OF MEDIAN ENDS.
2. PLANT MATERIAL SHALL BE PLACED A MIN. OF 10' AWAY FROM SIDES OF MEDIANS. SEE SECTION DETAIL.
3. WATER RETENTION BASINS SHALL BE CONSTRUCTED FOR EACH PLANT MATERIAL AS THERE WILL BE NO IRRIGATION SYSTEM PROVIDED.
4. WATERING OF PLANT MATERIAL WILL BE BY NEIGHBORHOOD.

### PLANT LEGEND

TREES:

| SYMBOL | QUANTITY | COMMON-BOTANICAL NAME | COMMENTS |
|---|---|---|---|
| | 21 | PALM YUCCA- Yucca aliofolia | 6'-9' tall planted 30' o.c. min. |

SHRUBS:

| SYMBOL | QUANTITY | COMMON-BOTANICAL NAME | COMMENTS |
|---|---|---|---|
| | 67 | CHAMISA- Chrysothamnus nauseosus | 1 gal. planted 5' o.c. min. |
| | 49 | SNAKEWEED- Gutierrezia sarothrae | 1gal. planted 1' o.c. min. |




TYPICAL SECTION
NOT TO SCALE




LOCATION MAP
NOT TO SCALE

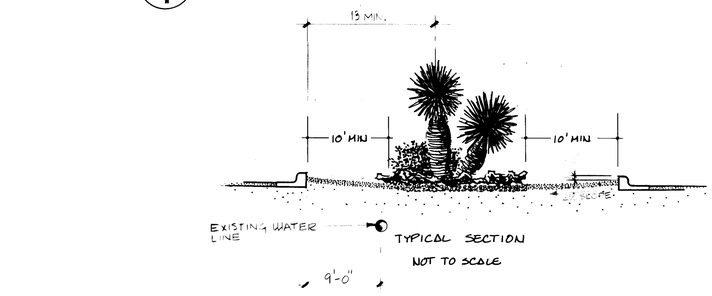


## PLANTING PLAN

SCALE: 1" : 30'

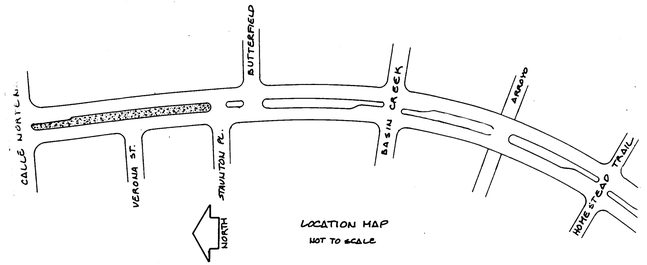APPROVED AS BUILT DRAWINGS
CITY CONSTRUCTION ENGINEER
DATE 6-6-97

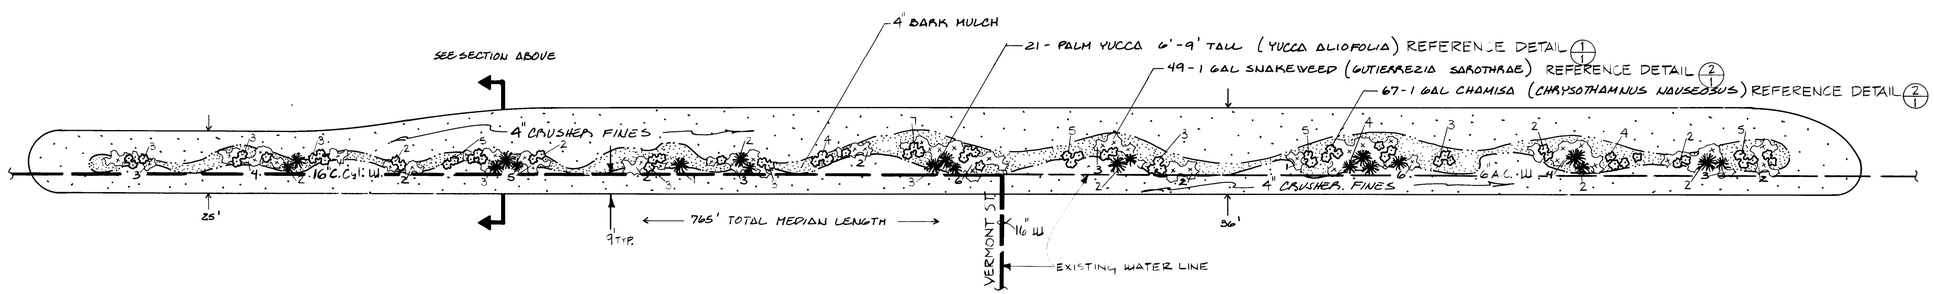


SEE ZONE ATLAS PAGE # D-11

TRAFFIC CONTROL

THREE (3) WORKING DAYS PRIOR TO BEGINNING CONSTRUCTION, THE CONTRACTOR SHALL SUBMIT TO THE CONSTRUCTION CO-ORDINATION DIVISION A DETAILED CONSTRUCTION SCHEDULE. TWO (2) WORKING DAYS PRIOR TO CONSTRUCTION THE CONTRACTOR SHALL OBTAIN A BARRICADING PERMIT FROM THE CONSTRUCTION CO-ORDINATION DIVISION. CONTRACTOR SHALL NOTIFY BARRICADE ENGINEER (768-2551) PRIOR TO OCCUPYING AN INTERSECTION. SEE SECTION 19 OF THE SPECIFICATIONS.

NOTICE TO CONTRACTOR

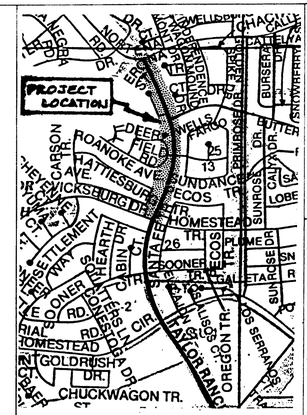1. All work detailed on these plans to be performed under contract shall, except as otherwise stated or provided for hereon, be constructed in accordance with City of Albuquerque Standard Specifications, Public Works Construction, 1986.
2. Two (2) working days prior to any excavation, contractor must contact contact Line Locating Service, 260-1990 for location of existing utilities.
3. Prior to construction, the contractor shall verify the horizontal and vertical locations of all obstructions. Should a conflict exist, the contractor shall notify the engineer or surveyor so that the conflict can be resolved with a minimum amount of delay.

26-3901.92 0107

APPROVED FOR CONSTRUCTION
3/19/92
DATE

SURVEY INFORMATION — FIELD NOTES — NO. — BY — DATE
AS BUILT INFORMATION — BENCH MARKS — ELEV. — DATUM — SOURCE — INCEPT. BY — RECEIVED BY — FIELD — DATE
ENGINEER'S SEAL
NO. — BY — DATE — REMARKS

CITY OF ALBUQUERQUE
PUBLIC WORKS DEPARTMENT
ENGINEERING GROUP

TITLE: LANDSCAPING FOR EXISTING MEDIAN AT RANCH DRIVE AND CALLE NORTENA N.W.

| APPROVALS | ENGINEER | DATE | APPROVALS | ENGR |
|---|---|---|---|---|
| D.R.C. Chair | | 3-19-92 | Hydrology | |
| Trans. Dev. | | 3-18-92 | | |
| Utility Dev. | | 3-18-92 | | |
| Parks | | 3-19-92 | | |

DRAWING NO. 3901.92 | MAP NO. D-11 | SHEET