
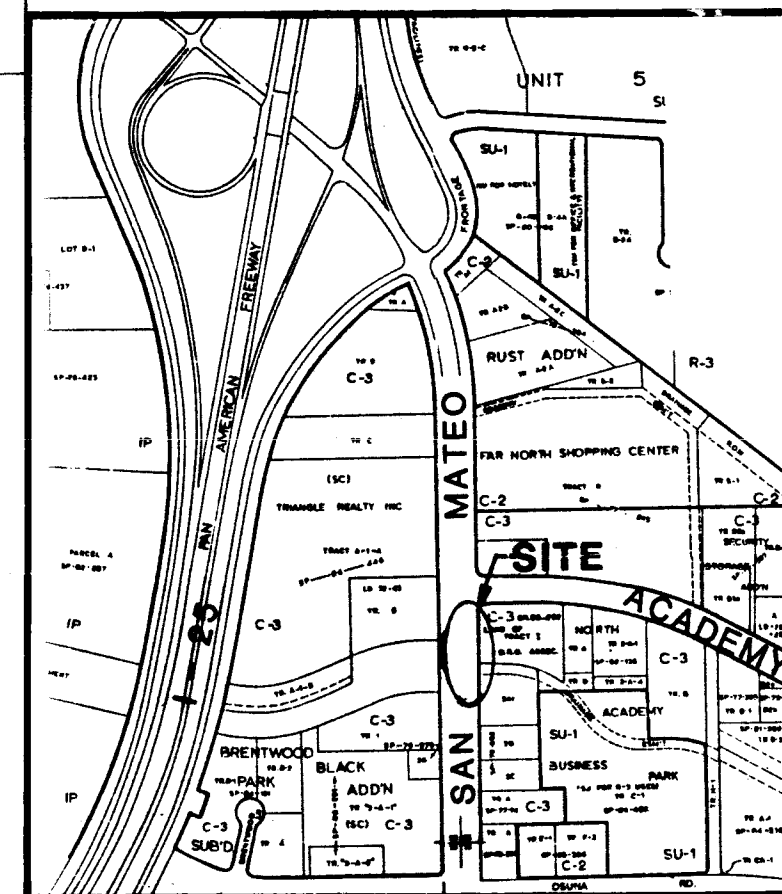


ACADEMY RD NE


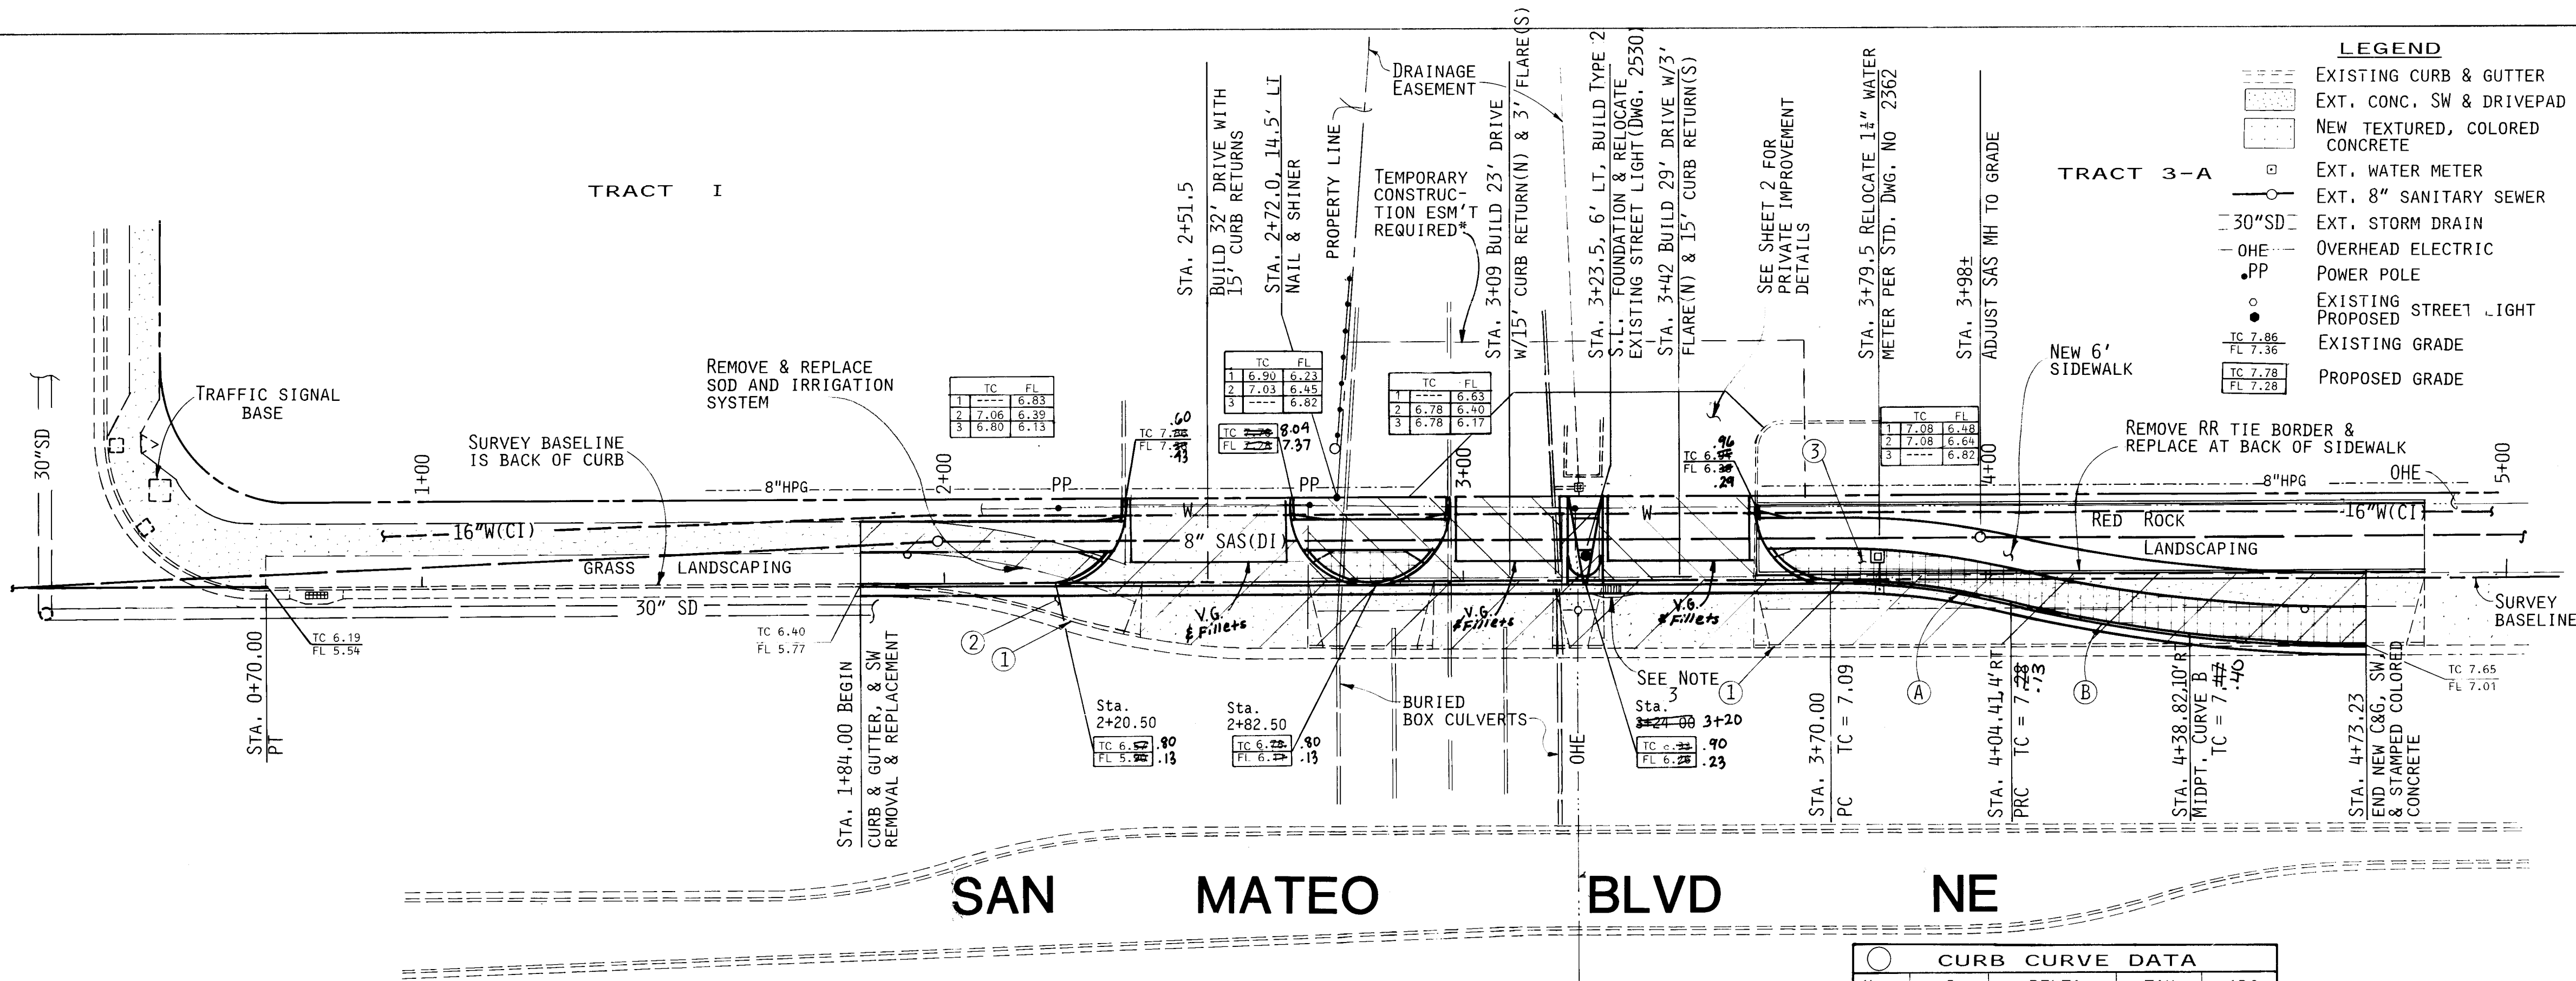


REMOVAL KEY

- REMOVE & DISPOSE OF SIDEWALK, DRIVEPAD, & STAMPED COLORED CONCRETE
- REMOVE & DISPOSE OF ASPHALTIC CONCRETE PAVING
- REMOVE & DISPOSE OF CURB & GUTTER
- REMOVE, STOCKPILE & REUSE SOD LANDSCAPING
- REMOVE, STOCKPILE & REUSE RED ROCK & RR TIE LANDSCAPING MATERIAL

CONSTRUCTION NOTES

- BUILD NEW CURB & GUTTER, SIDEWALK, & TEXTURED CONCRETE (COLOR TO MATCH EXISTING) PER STD. DWG. NOS. 2408, 2415, & 2430.
- PROVIDE 4" WIDE PAVEMENT STRIPING.
- REMOVE & DISPOSE OF EXISTING ARTERIAL PAVEMENT WHERE IT IS WITHIN ONE FOOT OF LIP OF PROPOSED GUTTER. BUILD NEW ARTERIAL PAVING PER STD. DWG. NO. 2408, AND AS SHOWN BELOW.
- SEE SHEET 2 FOR REQUIRED CONSTRUCTION TO EXTEND THE INTERMEDIATE WALLS OF THE BURIED BOX CULVERTS.
- BUILD SINGLE D TYPE INLET AT STA. 3+29 PER STD. DWG. NO. 2206 & AS DETAILED ON SHEET 2.
- CURB RETURN RADII ARE 15 FEET UNLESS OTHERWISE SHOWN.

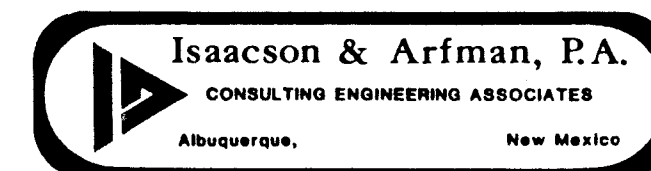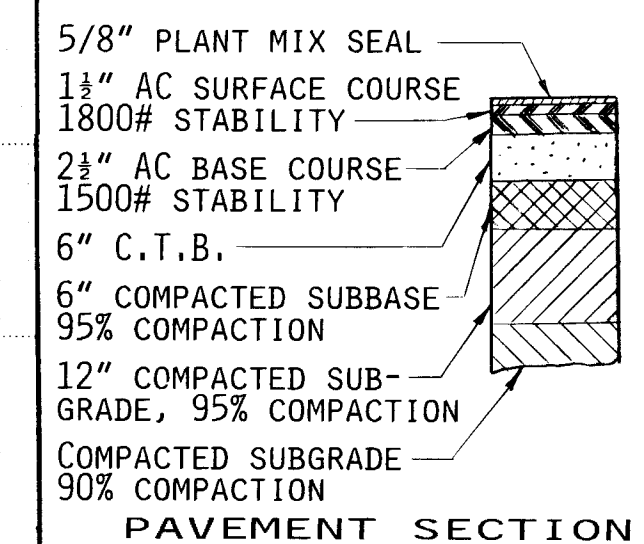

PUBLIC WORKS DEPARTMENT
ENGINEERING GROUP

TITLE **SAN MATEO RIGHT TURN LANE EXTENSION
SOUTH OF ACADEMY ROAD NE**

APPROVAL	DATE	APPROVAL	DATE
DRC Chair	4/26/91	Water	4-25-91
Transportation	4-26-91	Waste Water	
Hydrology	4/26/91		

