83596

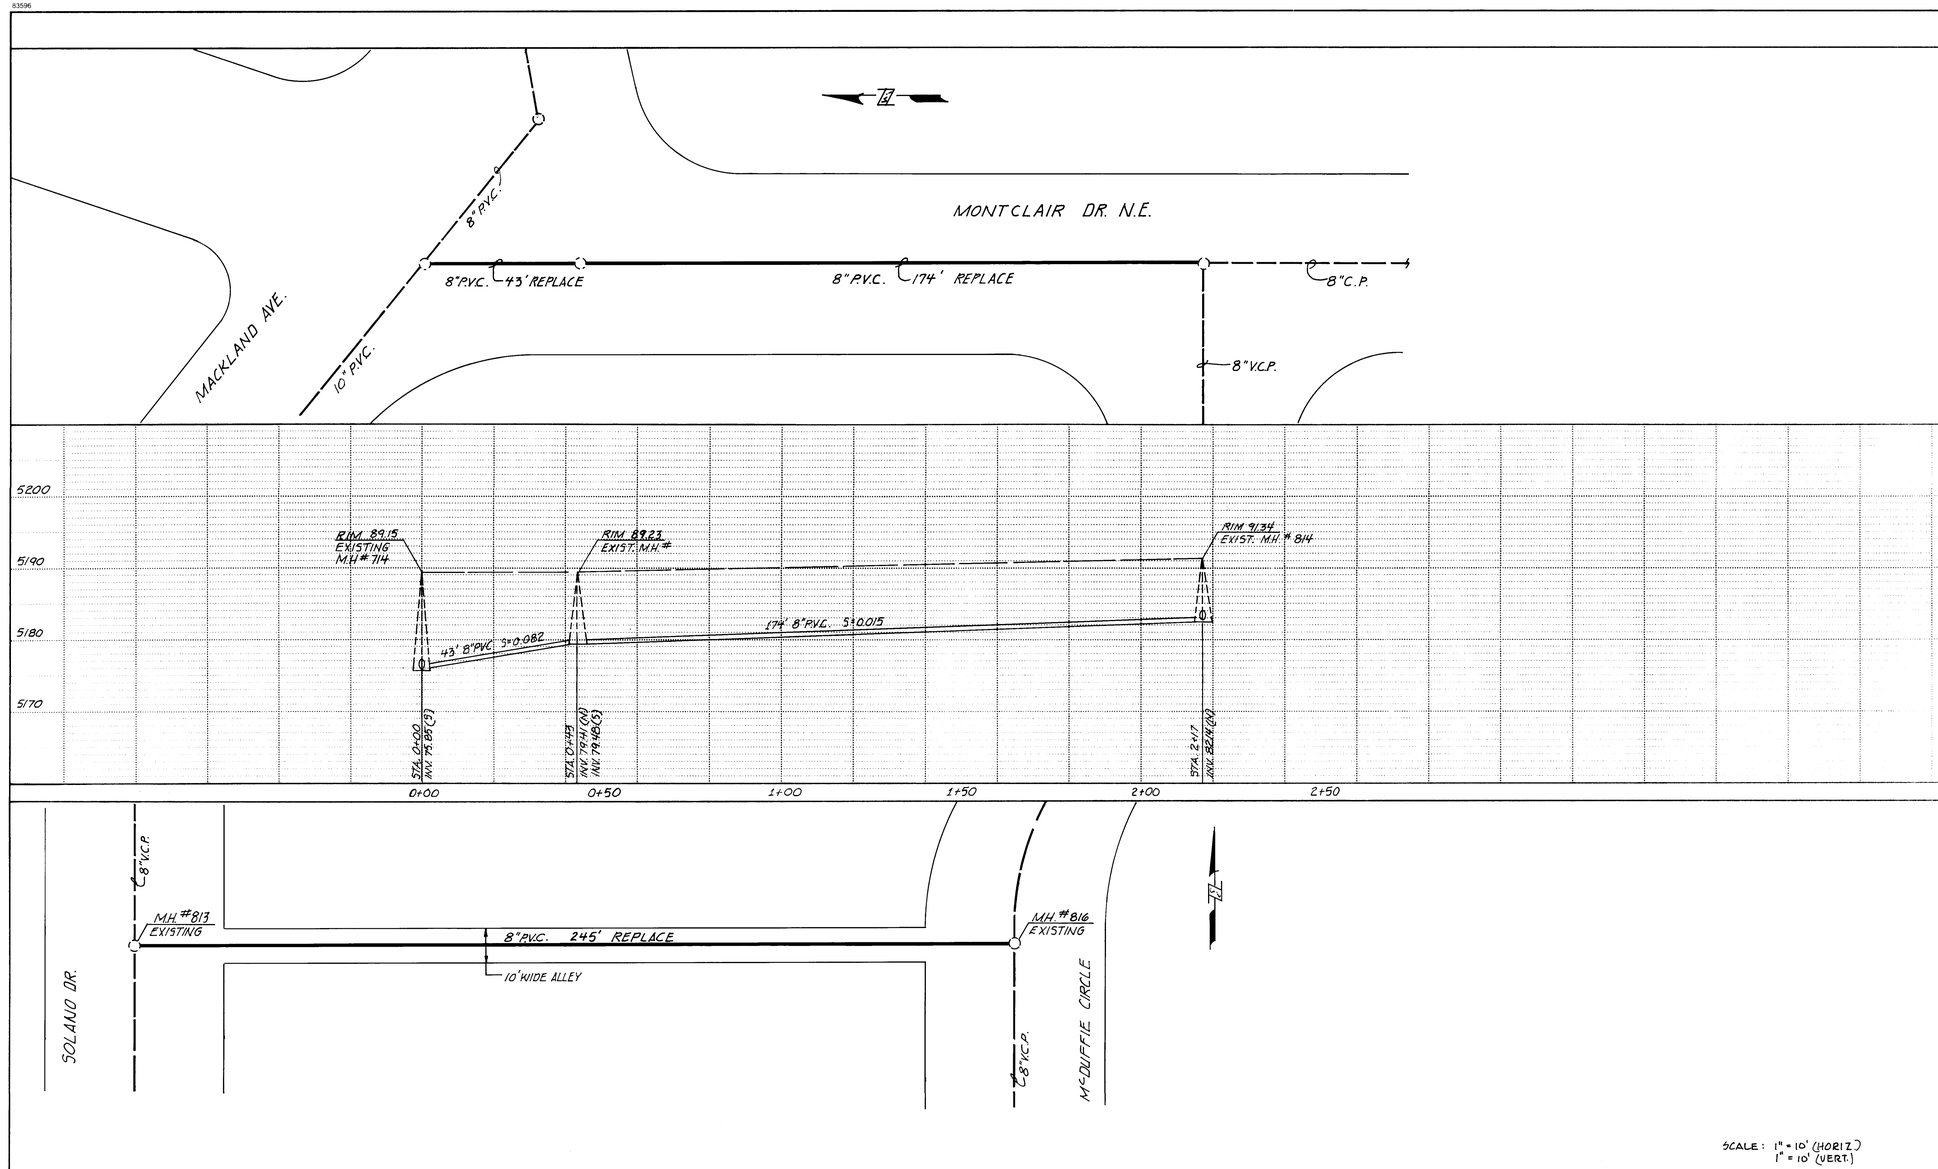

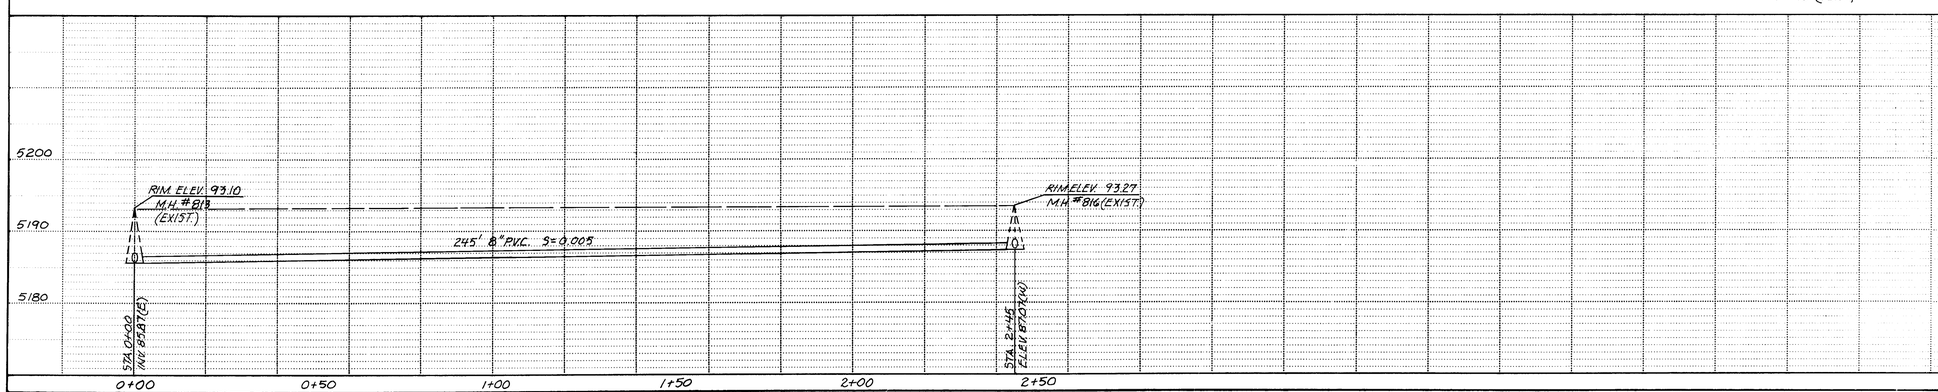

SCANNED BY
BY LASON

C of A PWD Maps & Records
1 2 3 4 5 6 7 8 9 10 11 12
2 6 1 9 0 1 4 0 1 9 0

APPROVAL OF AS BUILT DRAWINGS
CHIEF CONSTRUCTION ENGINEER
DATE 6/25/90

AS BUILT INFORMATION
CONTRACTOR Pride Construction
A.C.E. INSPECTOR BY C.O.A. DATE
INSPECTOR BY DATE
ENGINEER BY L. Romero DATE 6/11/90
FIELD VERIFICATION BY DATE
DRAWINGS CORRECTED BY E.J. DATE 6/90
MICRO-FILM INFORMATION
RECORDED BY DATE
NO.

BENCH MARKS

SURVEY INFORMATION
FIELD NOTES

NO.	BY	DATE

ENGINEER'S SEAL

REVISIONS

NO.	DATE	REMARKS	BY

DESIGN
DESIGNED BY DATE
DRAWN BY DATE
CHECKED BY DATE

CITY OF ALBUQUERQUE
MUNICIPAL DEVELOPMENT DEPARTMENT
ENGINEERING DIVISION

TITLE: MONTCLAIRE SAS REPLACEMENT (89-2)

APPROVALS	ENGINEER	DATE	APPROVALS	ENGINEER	DATE
City Engineer			Liquid Waste		
A.C.E. - Design			Traffic		
A.C.E. - Hydrology			Water		

DRAWING NO. 4014 | MAP NO. J-17 | SHEET 1 OF 1