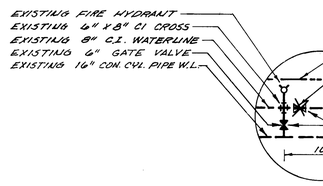

VALVE SHUT-OFF PLAN

FOR NON-PRESSURE CONNECTION TO EXISTING 8" C.I. WATERLINE, SHUT OFF EXISTING 6" & 8" GATE VALVES. OPEN FIRE HYDRANT TO BLEED PRESSURE.

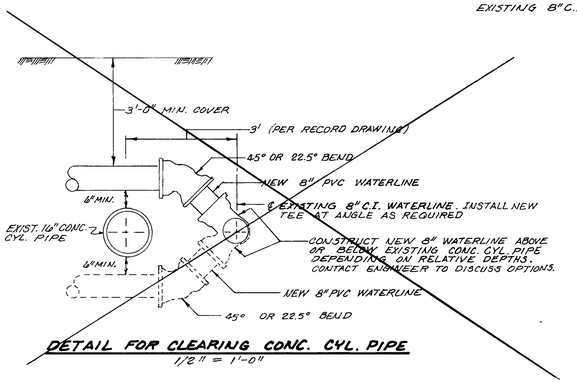

DETAIL FOR CLEARING CONC. CYL. PIPE

1/2" = 1'-0"

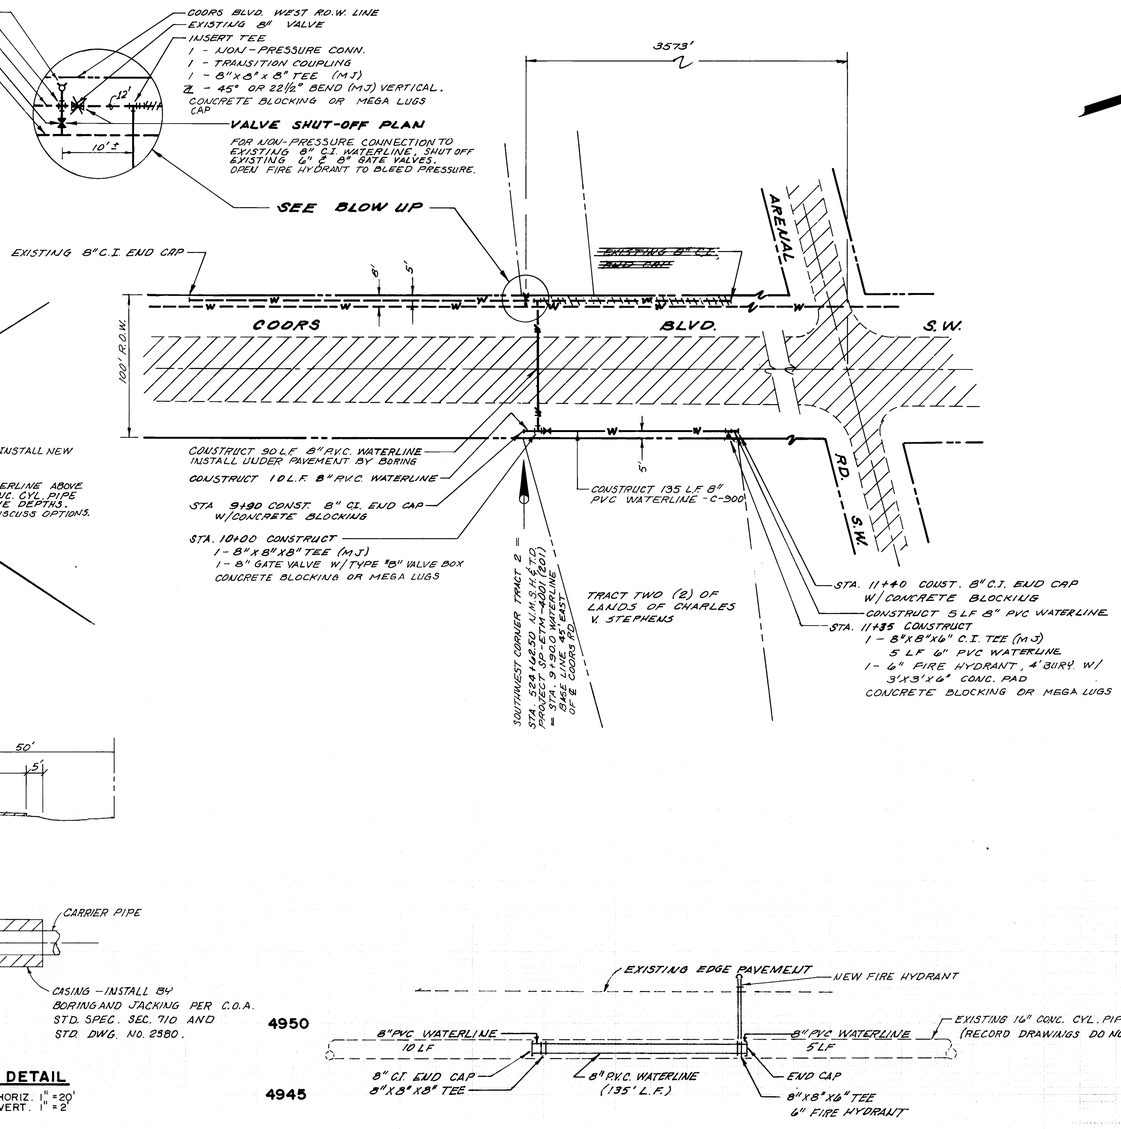

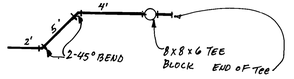

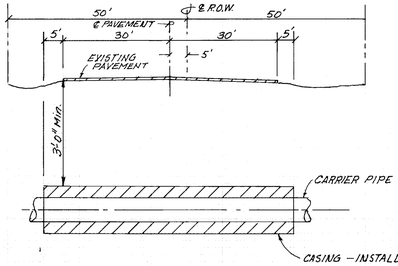

COORS BLVD. CROSSING DETAIL

SCALE: HORIZ. 1" = 20'
VERT. 1" = 2'

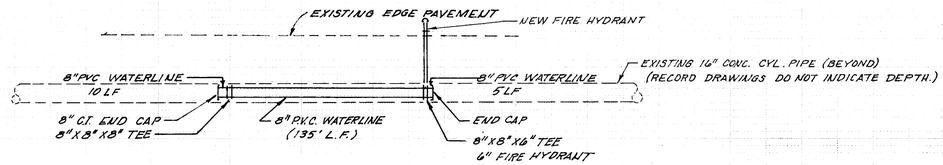

PLAN:
SCALE: 1" = 50'

PROFILE:
SCALE: HORIZ. 1" = 50'
VERT. 1" = 5'

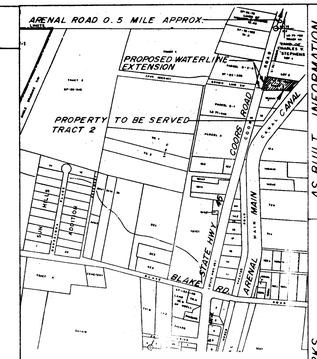

LOCATION MAP N-10

NOTICE TO CONTRACTOR

1. All work detailed on these plans to be performed under contract shall, except as otherwise stated or provided for hereon, be constructed in accordance with the City of Albuquerque Standard Specifications for Public Works Construction, 1986.
2. Two (2) working days prior to any excavation, contractor must contact New Mexico One-Call System, Inc., 260-1990, for location of existing utilities.
3. Prior to construction, the contractor shall excavate and verify the horizontal and vertical locations of all obstructions. Should a conflict exist, the contractor shall notify the engineer or surveyor so that the conflict can be resolved with a minimum amount of delay.
4. Three (3) working days prior to beginning construction the Contractor shall submit to the Construction Co-ordination Division a detailed construction schedule. Two (2) working days prior to construction the contractor shall obtain a barricading permit from the Construction Co-ordination Division. Contractor shall notify Barricading Engineer (768--2551) prior to occupying an intersection.
5. Three (3) working days prior to construction, contractor shall contact Water Systems (823-4200) for execution of the valve shut-off plan.

AS BUILT INFORMATION
JD EXCAVATORS
DATE 1/4/90
M. STEPHEN
DATE
MICRO-FILM INFORMATION
DATE
NO

BENCH MARKS
NM #45-7A LOCATED 4.8 MILES FROM DOWNTOWN ALBUQUERQUE AT THE INTERSECTION OF COORS ROAD SOUTH AND BLAKE ROAD. STATION IS IN THE ROADWAY ON THE CENTERLINE OF BLAKE ROAD, 42.3' WEST OF CENTERLINE OF COORS ROAD. STATION IS A STANDARD A.C.S. BRASS CAP STAMPED "ACS 45-7A, 1976", 0.2' BELOW THE ROADWAY UNDER A WATER METER.
ELEVATION 4953.487 FEET.

SURVEY INFORMATION
FIELD NOTES
NO
BY
DATE

ENGINEER'S SEAL
LEONARD D. CLEVELAND
NEW MEXICO
12212
REGISTERED PROFESSIONAL ENGINEER
7/19/90

REVISIONS

NO	DATE	BY	REMARKS
		DESIGN	FDL. DATE 6-4-90
		DRAWN BY	FDL. DATE 6-11-90
		CHECKED BY	FDL DATE 6-12-90

APPROVAL OF AS BUILT DRAWINGS BY CONSTRUCTION ENGINEER
DATE 11/4/91

APPROVED FOR CONSTRUCTION
CITY ENGINEER Russell B. Fisher 9-27-90 DATE

CITY OF ALBUQUERQUE
PUBLIC WORKS DEPARTMENT
ENGINEERING GROUP

TITLE: **WATERLINE ON COORS BLVD.**
BETWEEN BLAKE ROAD & ARENAL ROAD, S.W.

APPROVALS	ENGINEER	DATE	APPROVALS	ENGINEER	DATE
D.R.C. Chairman	Roger Snow	7-19-90	Water	R.W. Kane	7-19-90
Transportation	[signature]	7-19-90	Wastewater	R.W. Kane	7-19-90
Hydrology	N/A	—			

DRAWING NO.	MAP NO.	SHEET	OF
4108.90	N-10	1	1

1 2 3 4 5 6 7 8 9 10 11 12 13 14 15
2 6 4 1 0 8 . 9 0 0 1 9 1

SCANNED BY BY EASON