3

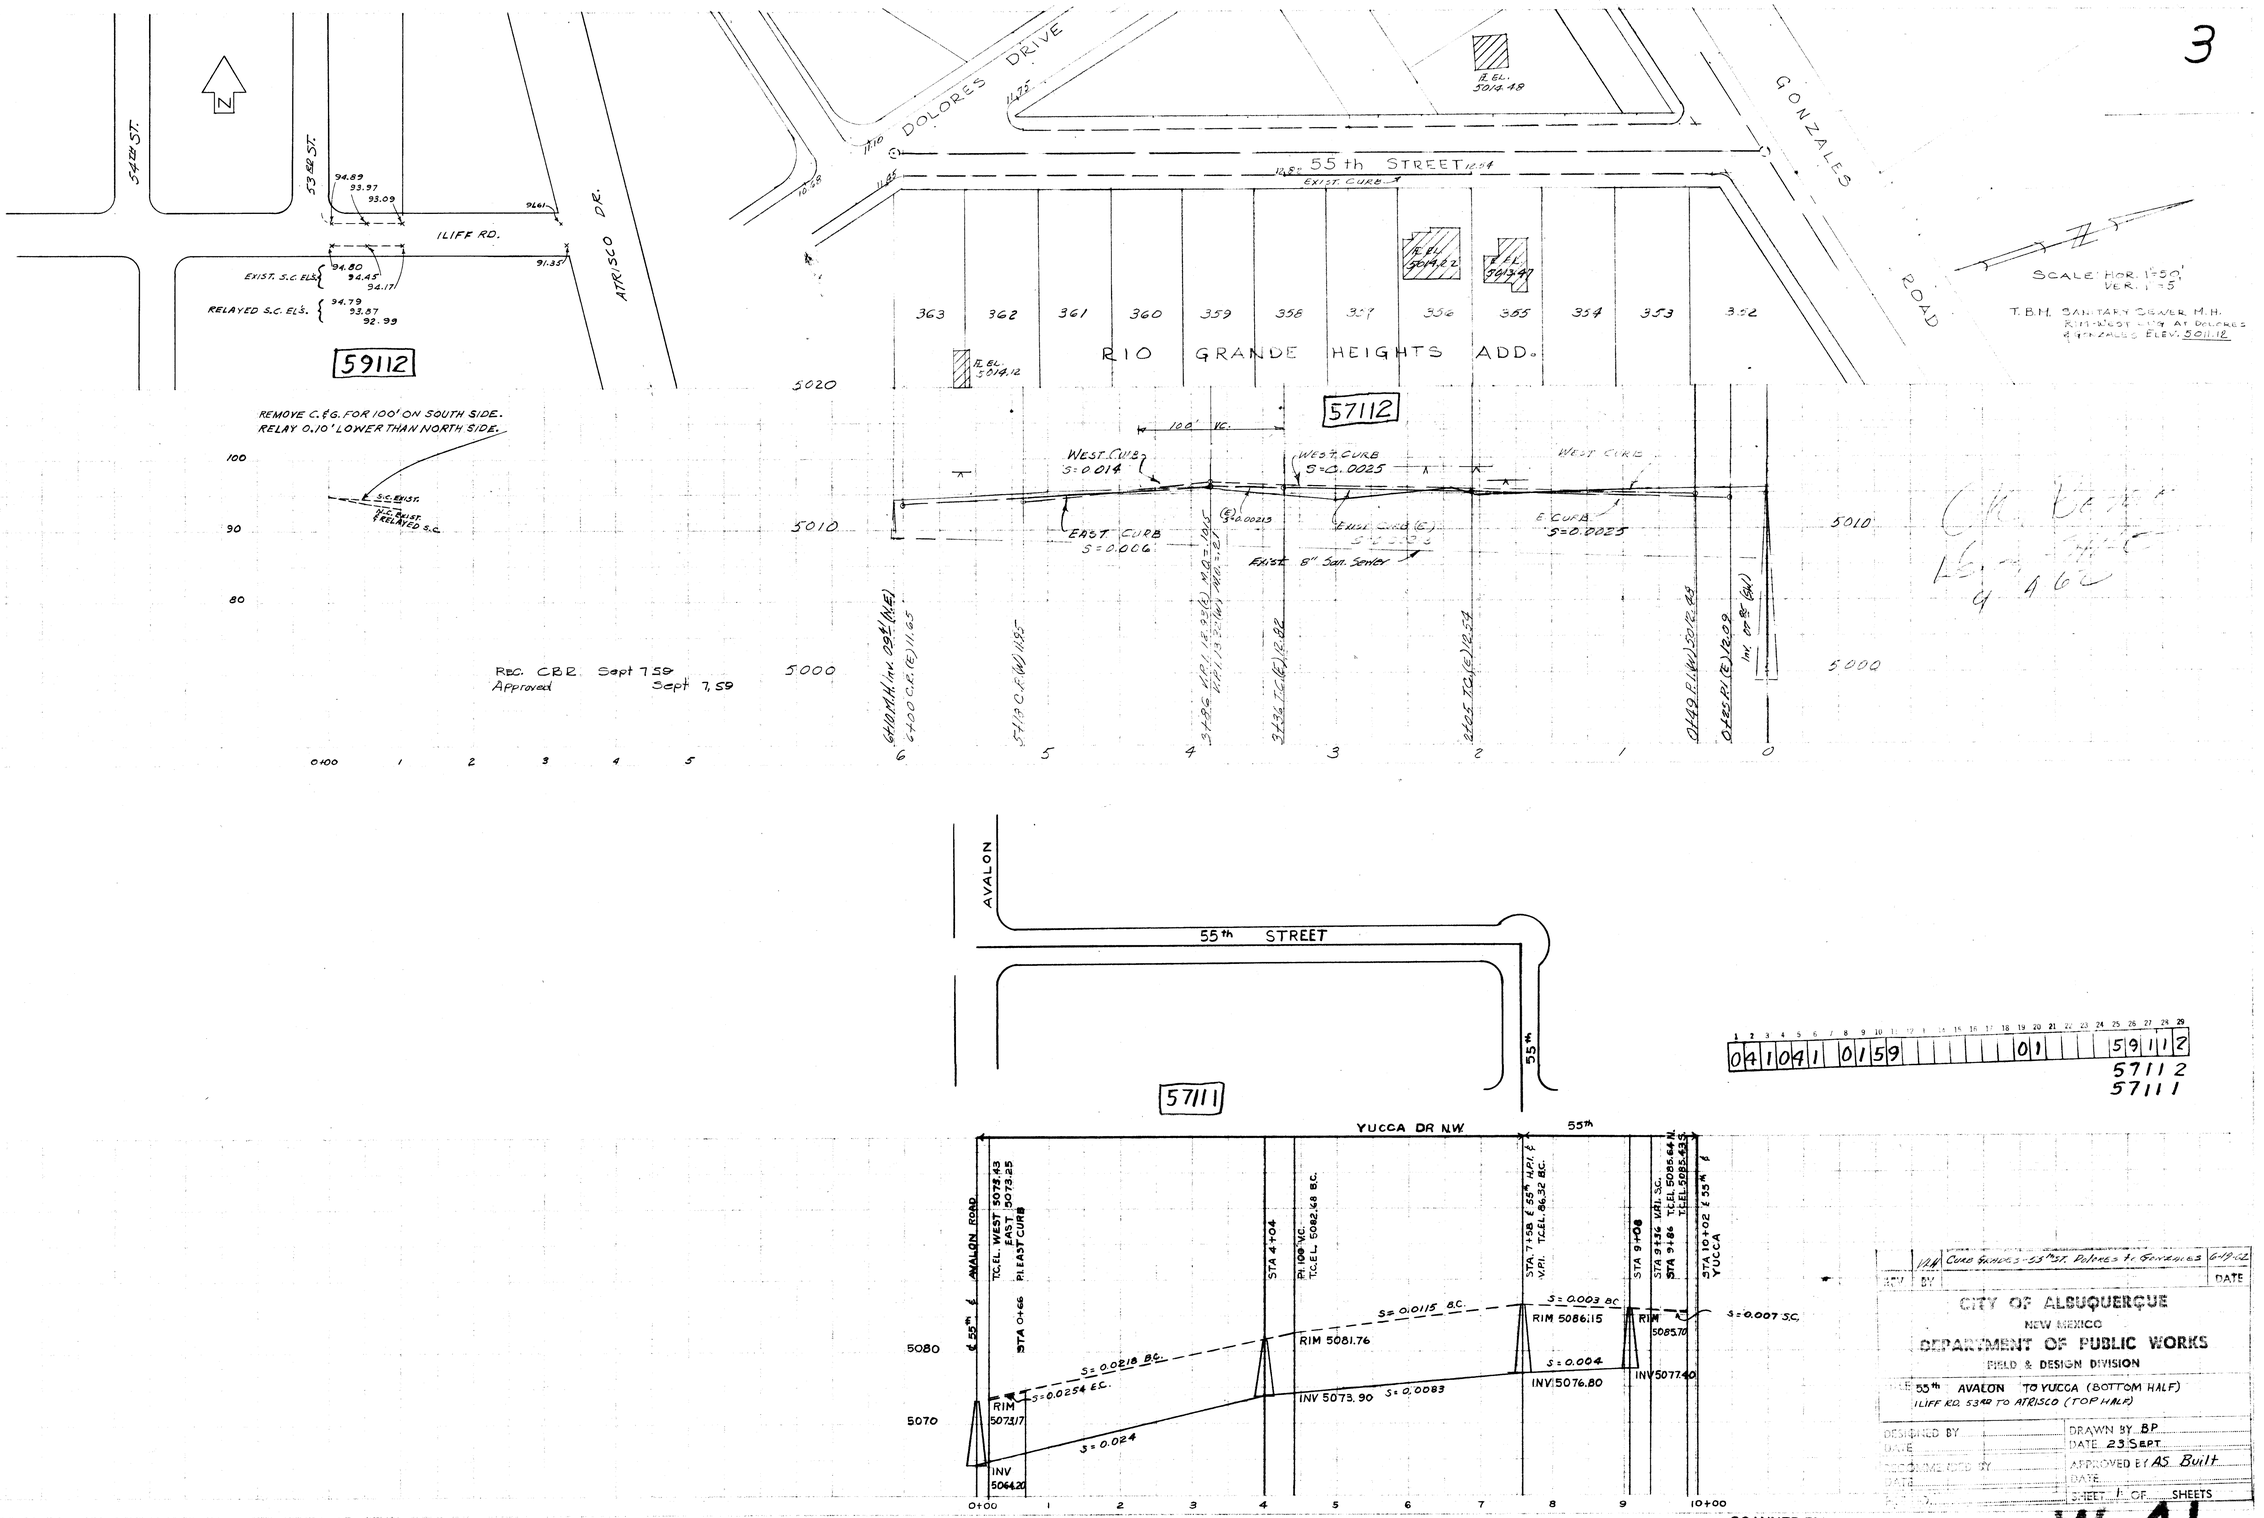

Reg. CBR Sept 7 59
Approved Sept 7, 59

0 4 1 0 4 1 0 1 5 9 0 1 5 9 1 1 2

57112
57111

SCANNED BY
BY LASON

W-41