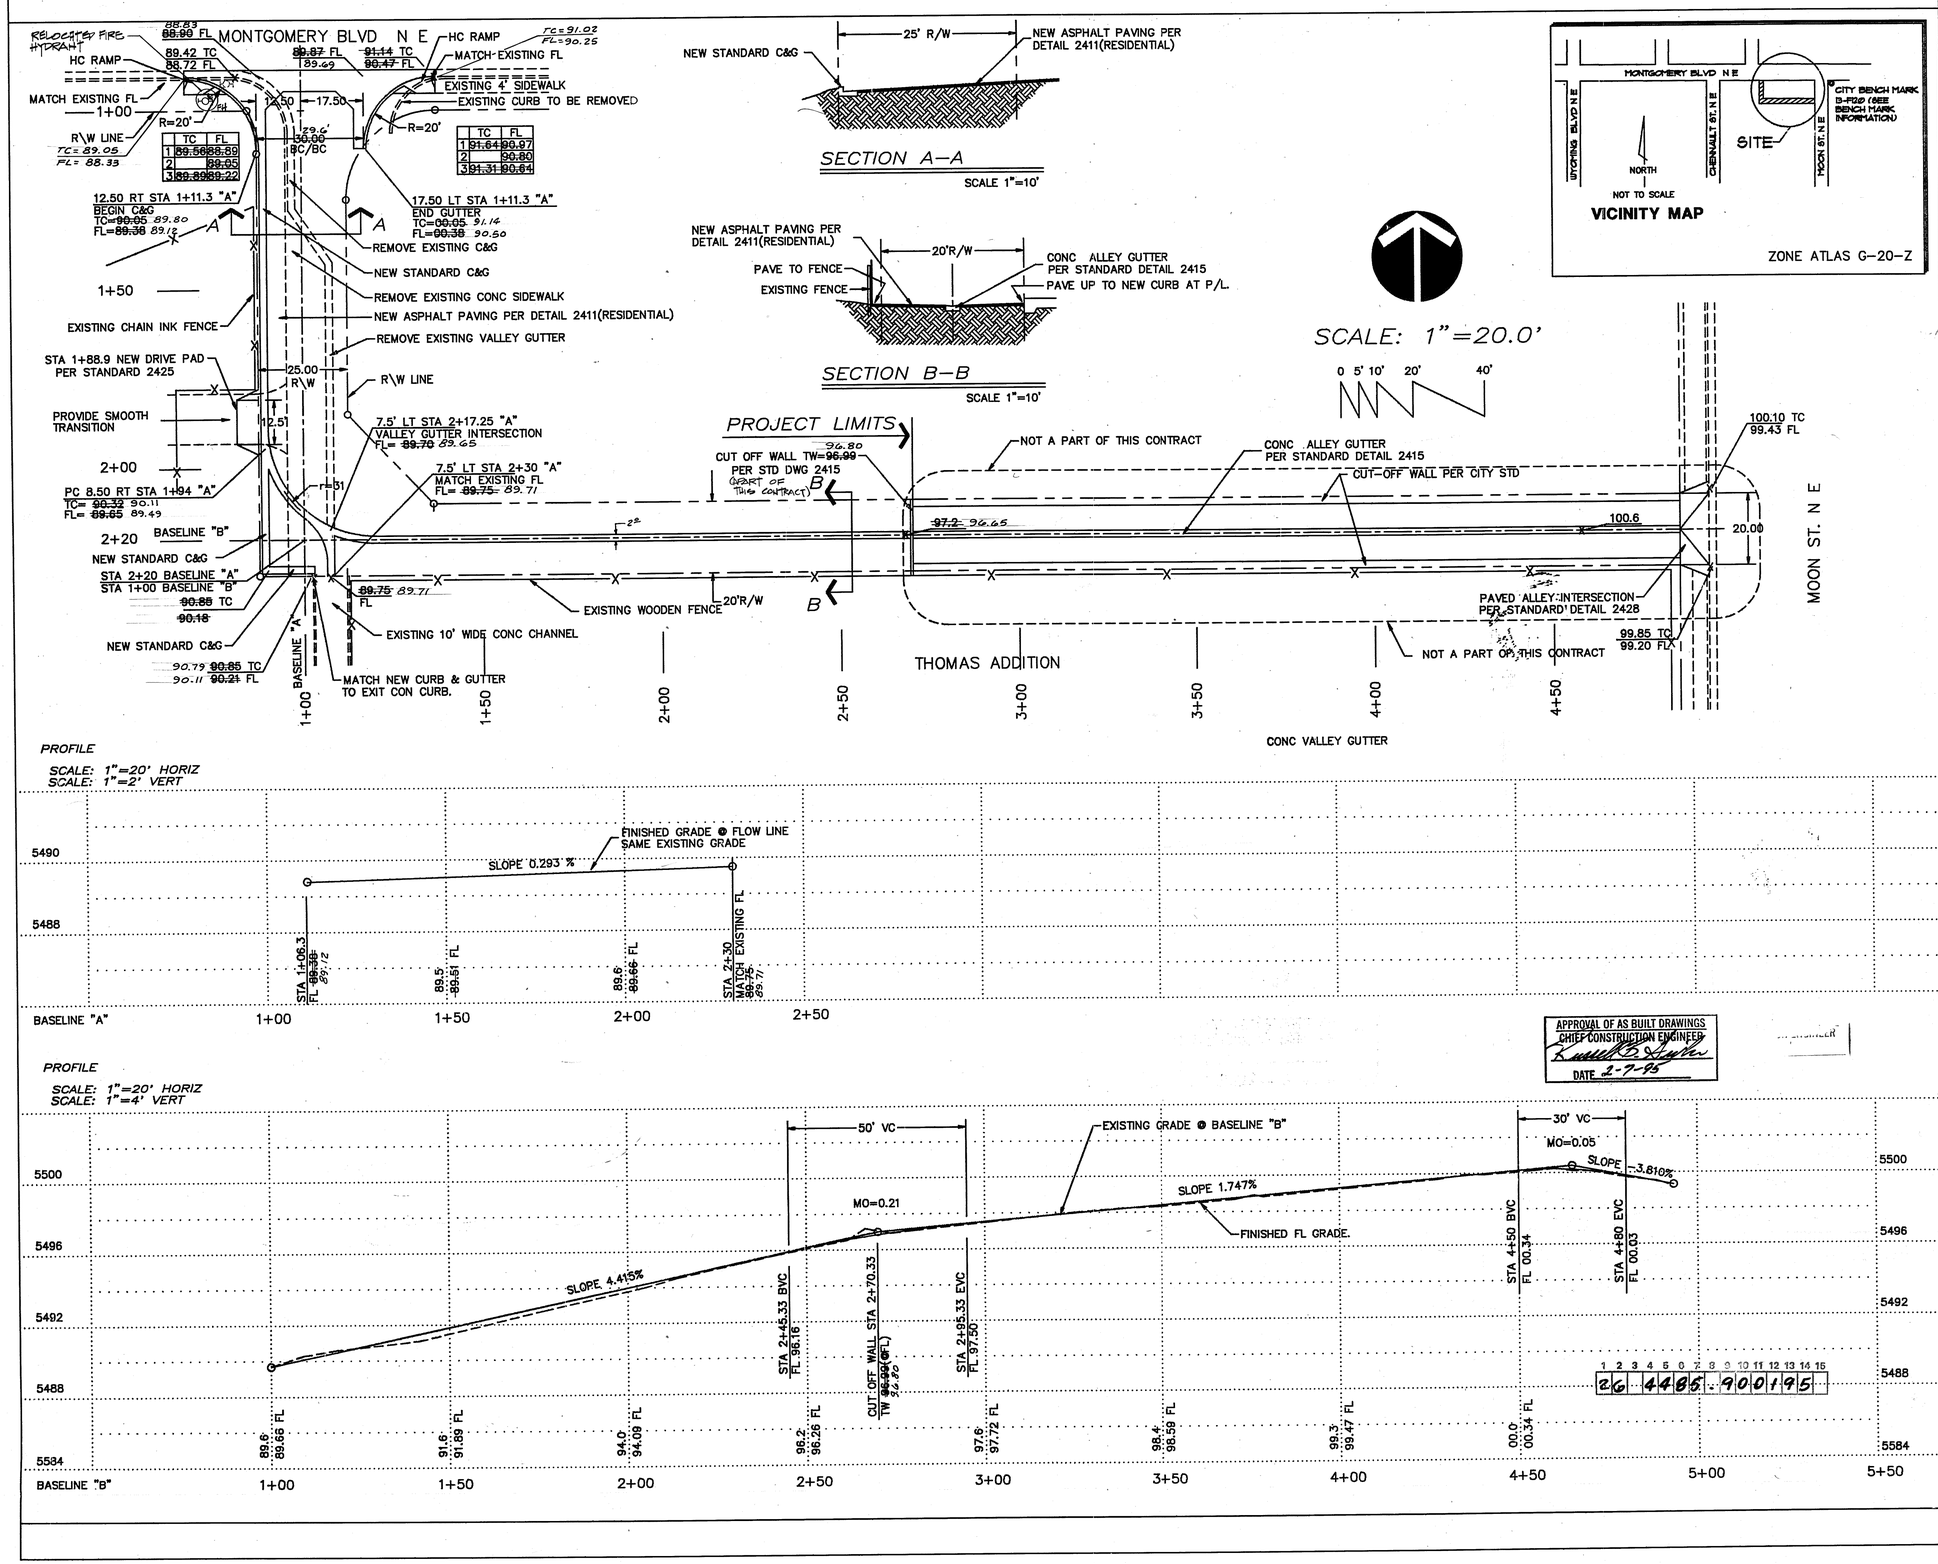

APPROVAL OF AS BUILT DRAWINGS
CHIEF CONSTRUCTION ENGINEER
DATE 2-7-95

NOTE TO CONTRACTOR:

1. CITY OF ALBUQUERQUE SPECIFICATIONS FOR PUBLIC WORKS CONSTRUCTION, 1986 EDITION WILL BE REFERRED TO HEREIN AS "STANDARD SPECIFICATION".
2. TWO WORKING DAYS PRIOR TO ANY EXCAVATION, CONTRACTOR SHALL CONTACT NEW MEXICO ONE CALL SYSTEM (260-1990) AND DETERMINE LOCATION OF EXISTING UTILITIES.
3. PRIOR TO ANY CONSTRUCTION, THE CONTRACTOR SHALL EXCAVATE AND VERIFY HORIZONTAL AND VERTICAL LOCATIONS OF ALL OBSTRUCTIONS. SHOULD A CONFLICT EXIST, THE CONTRACTOR SHALL NOTIFY THE ENGINEER SO THAT THE CONFLICT MAY BE RESOLVED WITHOUT DELAY.
4. ALL EXISTING SIGNS, MARKER, DELINEATOR, ETC., WITHIN THE CONSTRUCTION LIMITS SHALL BE REMOVED, STORED AND RE-SET BY CONTRACTOR.
5. THREE (3) WORKING DAYS PRIOR TO BEGINNING CONSTRUCTION THE CONTRACTOR SHALL SUBMIT TO THE CONSTRUCTION CO-ORDINATION DIVISION A DETAILED CONSTRUCTION SCHEDULE. TWO (2) WORKING DAYS PRIOR TO CONSTRUCTION THE CONTRACTOR SHALL OBTAIN A BARRICADING PERMIT FROM THE CONSTRUCTION CO-ORDINATION DIVISION. CONTRACTOR SHALL NOTIFY BARRICADE ENGINEER (768-2551) PRIOR TO OCCUPYING AN INTERSECTION. SEE SECTION 19 OF THE STANDARD SPECIFICATIONS.

RECORD DRAWINGS AS-BUILT

THESE DRAWINGS HAVE BEEN REVISED (IN ACCORDANCE WITH A FIELD SURVEY CONDUCTED BY COMMUNITY SCIENCES CORPORATION ON 9/29/92) TO REFLECT THE CONSTRUCTION AS ACCOMPLISHED. COMMUNITY SCIENCES CORPORATION DID NOT PERFORM ANY CONSTRUCTION OBSERVATION, AND CANNOT CERTIFY TO THE QUALITY OF CONSTRUCTION OR ITS CONFORMANCE TO THE PLANS AND SPECIFICATIONS.

Michael J. Yost 10/12/92
MICHAEL J. YOST, P.E. N.M.P.E. 9665 DATE

MICHAEL J. YOST NEW MEXICO 9665 REGISTERED PROFESSIONAL ENGINEER

APPROVED FOR CONSTRUCTION
Roger L. Green 9-4-92
CITY ENGINEER DATE

CITY OF ALBUQUERQUE
MUNICIPAL DEVELOPMENT DEPARTMENT
ENGINEERING DIVISION

TITLE: ALLEY GRADES
THOMAS ADDITION

APROVALS	ENGINEER	DATE	APROVALS	ENGINEER	DATE
DRC CHAIRMAN	Roger L. Green	6-30-92	WATER	R.W. Kane	6-19-92
TRANSPORTATION	[illegible]	6-25-92	WASTE WATER	R.W. Kane	6-19-92
HYDROLOGY	[illegible]	6-26-92	Water		

Drawing Number 4485.90 | Map NO. G-20 | Sheet 1 of 1

AS BUILT INFORMATION
CONTRACTOR ALBUQUERQUE ASPHALT
WORK STAKED BY ALBS. ASPHALT DATE
INSPECTOR'S INITIALS MERV NEPHEW DATE SEP., 1992
FIELD VERIFICATION BY: COMMUNITY SCIENCES CORP.
DRAWINGS CORRECTED BY COMMUNITY SCIENCES DATE OCT., 1992

BENCH MARKS
PROJECT BENCH-MARK BEING THE CITY BENCH-MARK
13-F20 LOCATED AT THE SE QUADRANT OF THE INTERSECTION MOON ST & MONTGOMERY BLVD.
"□" CUT ESE CURB RETURN BEARS ELEVATION 5502.372

MICRO-FILM INFORMATION
RECORDED BY DATE
NO.

SURVEY INFORMATION
FIELD NOTES

NO.	BY	DATE
	LEE ENGINEERING	6\92

ENGINEER'S SEAL: R. W. KANE NEW MEXICO 9173 REGISTERED PROFESSIONAL ENGINEER

NO.	DATE	REMARKS	BY
		REVISIONS	
		DESIGN	

DESIGN BY : H. HOOD/ RON LEE DATE MAY 1992
DRAWING BY : H. HOOD DATE MAY 1992
CHECKED BY : RON LEE DATE MAY 1992