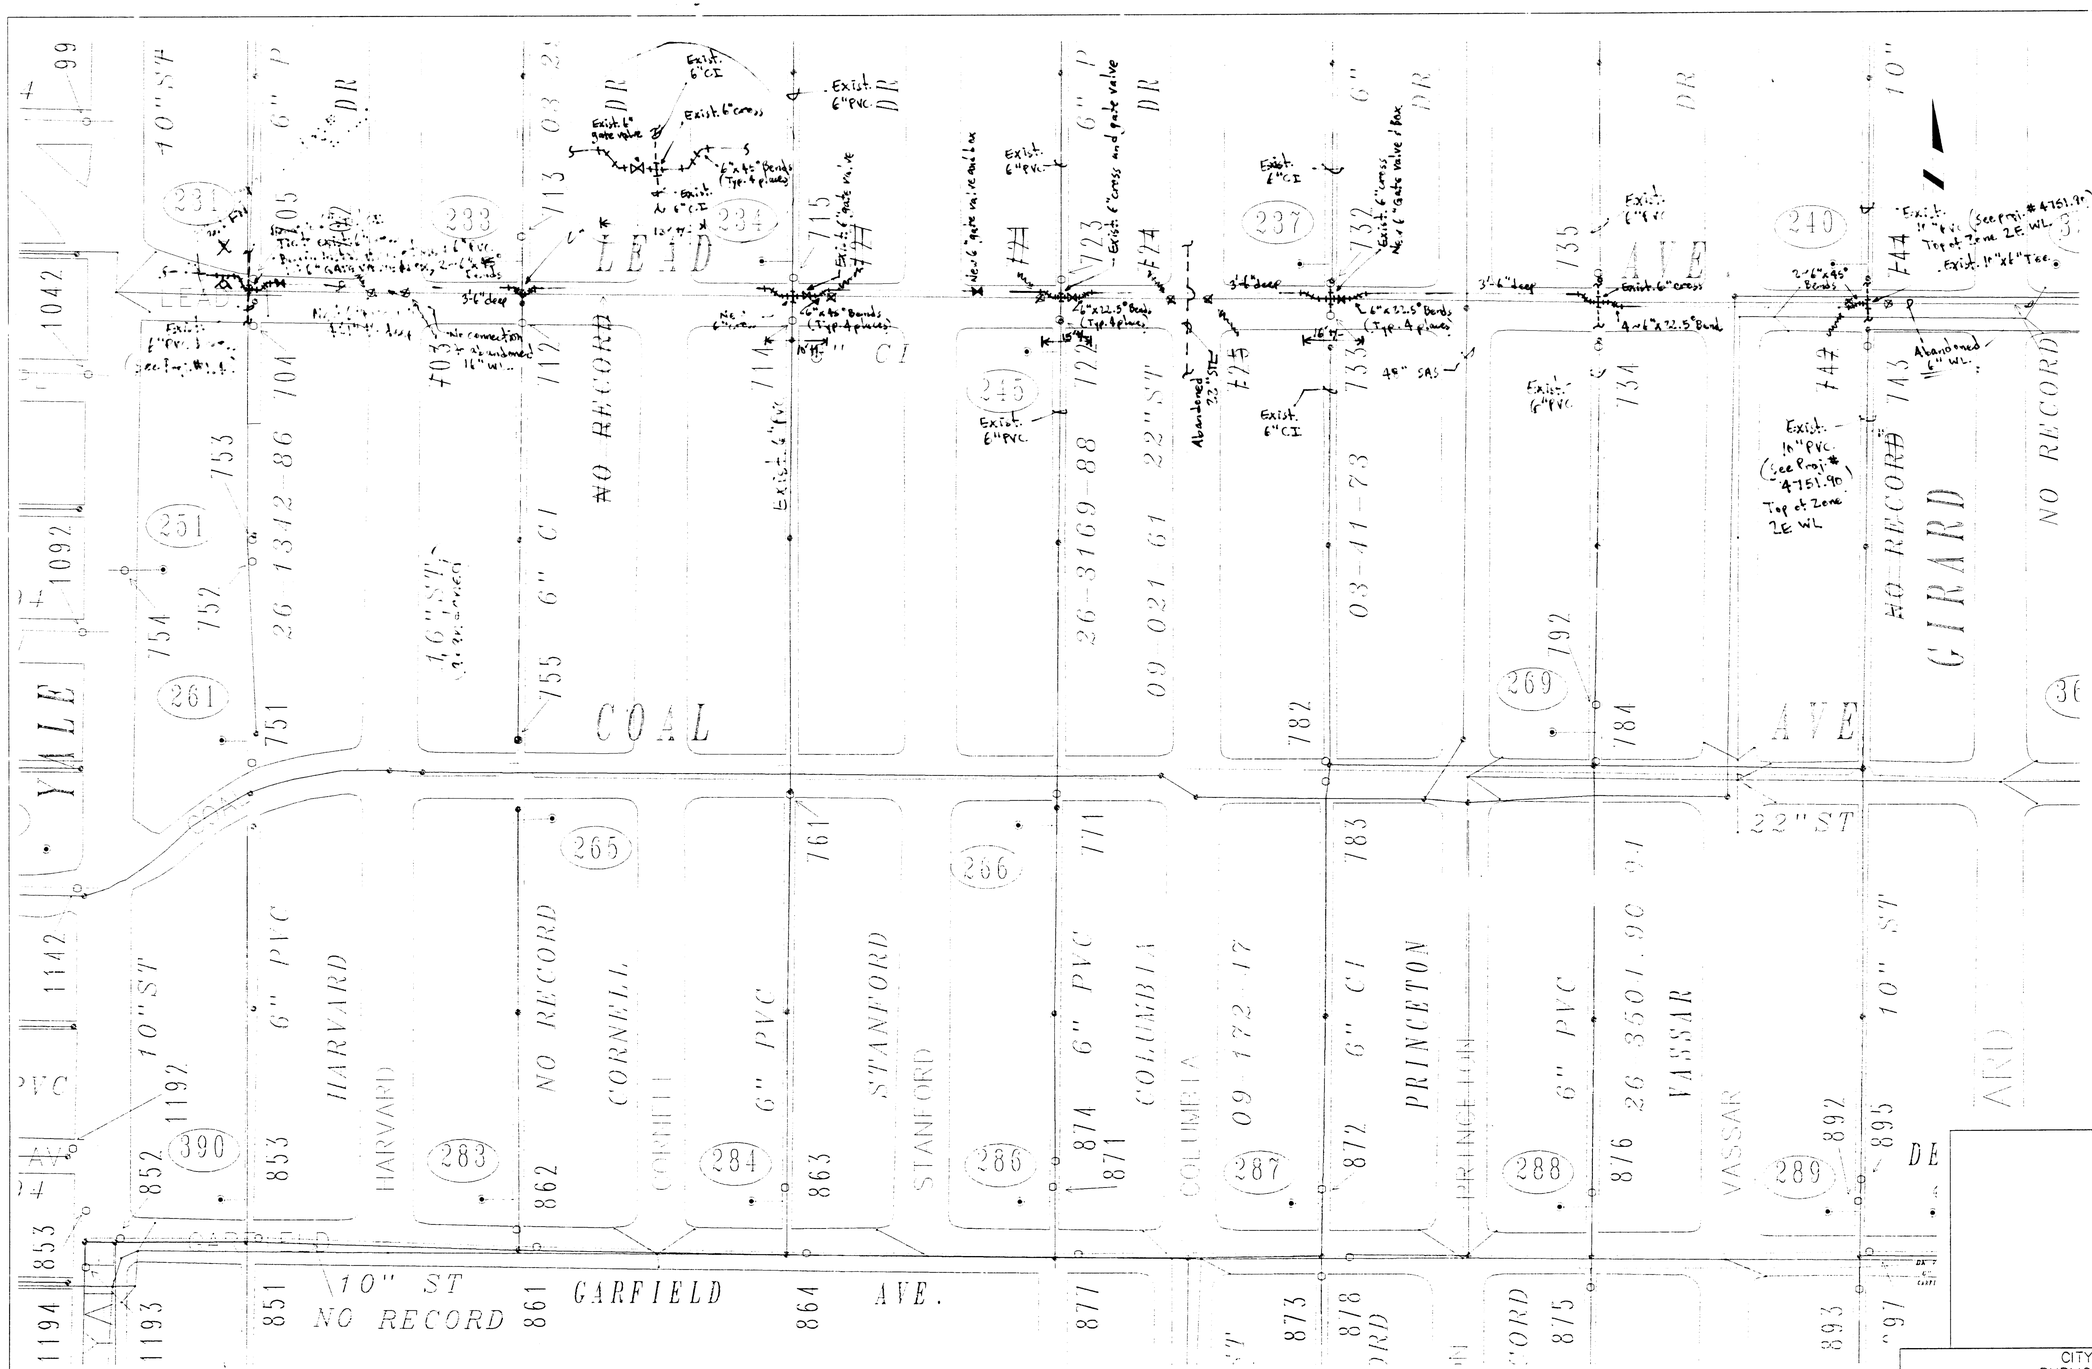

APPROVAL OF AS BUILT DRAWINGS
CHIEF CONSTRUCTION ENGINEER
DATE

LASON 1-505-344-9404
BEST COPY AVAILABLE

1 2 3 4 5 6 7 8 9 10 11 12 13 14 15
26 4536. 92 98 K 16

AS BUILT INFORMATION
CONTRACTOR A.C.L. Underground DATE 7-98
WORK STAKED BY A.C.L. Underground DATE 7-98
AS CONSTRUCTED BY C.O.A. Field DATE 7-98
AS BUILT BY C.O.A. Field DATE 7-98
VERIFIED BY DATE
DRAWINGS CORRECTED BY C.O.A. Field DATE 7-98
MICRO-FILM INFORMATION
RECORDED BY DATE
NO.

BENCH MARKS

SURVEY INFORMATION
FIELD NOTES
NO. BY DATE

ENGINEER'S SEAL

NO.	DATE	REMARKS	BY

DESIGN
DESIGNED BY CoA DATE 4-98
DRAWN BY CoA DATE 4-98
CHECKED BY CoA DATE 4-98

CITY OF ALBUQUERQUE
PUBLIC WORKS DEPARTMENT
UTILITY DEVELOPMENT

TITLE: LEAD AVENUE WATERLINE REPLACEMENT
YALE TO CARLISLE

DESIGN REVIEW COMMITTEE	CITY ENGINEER APPROVAL	MO./DAY/YR.	MO./DAY/YR.
N/A	N/A		

City Project No.	Zone Map No.	Sheet	Of
4536.92	K-11	1	2

SCANNED BY LASON

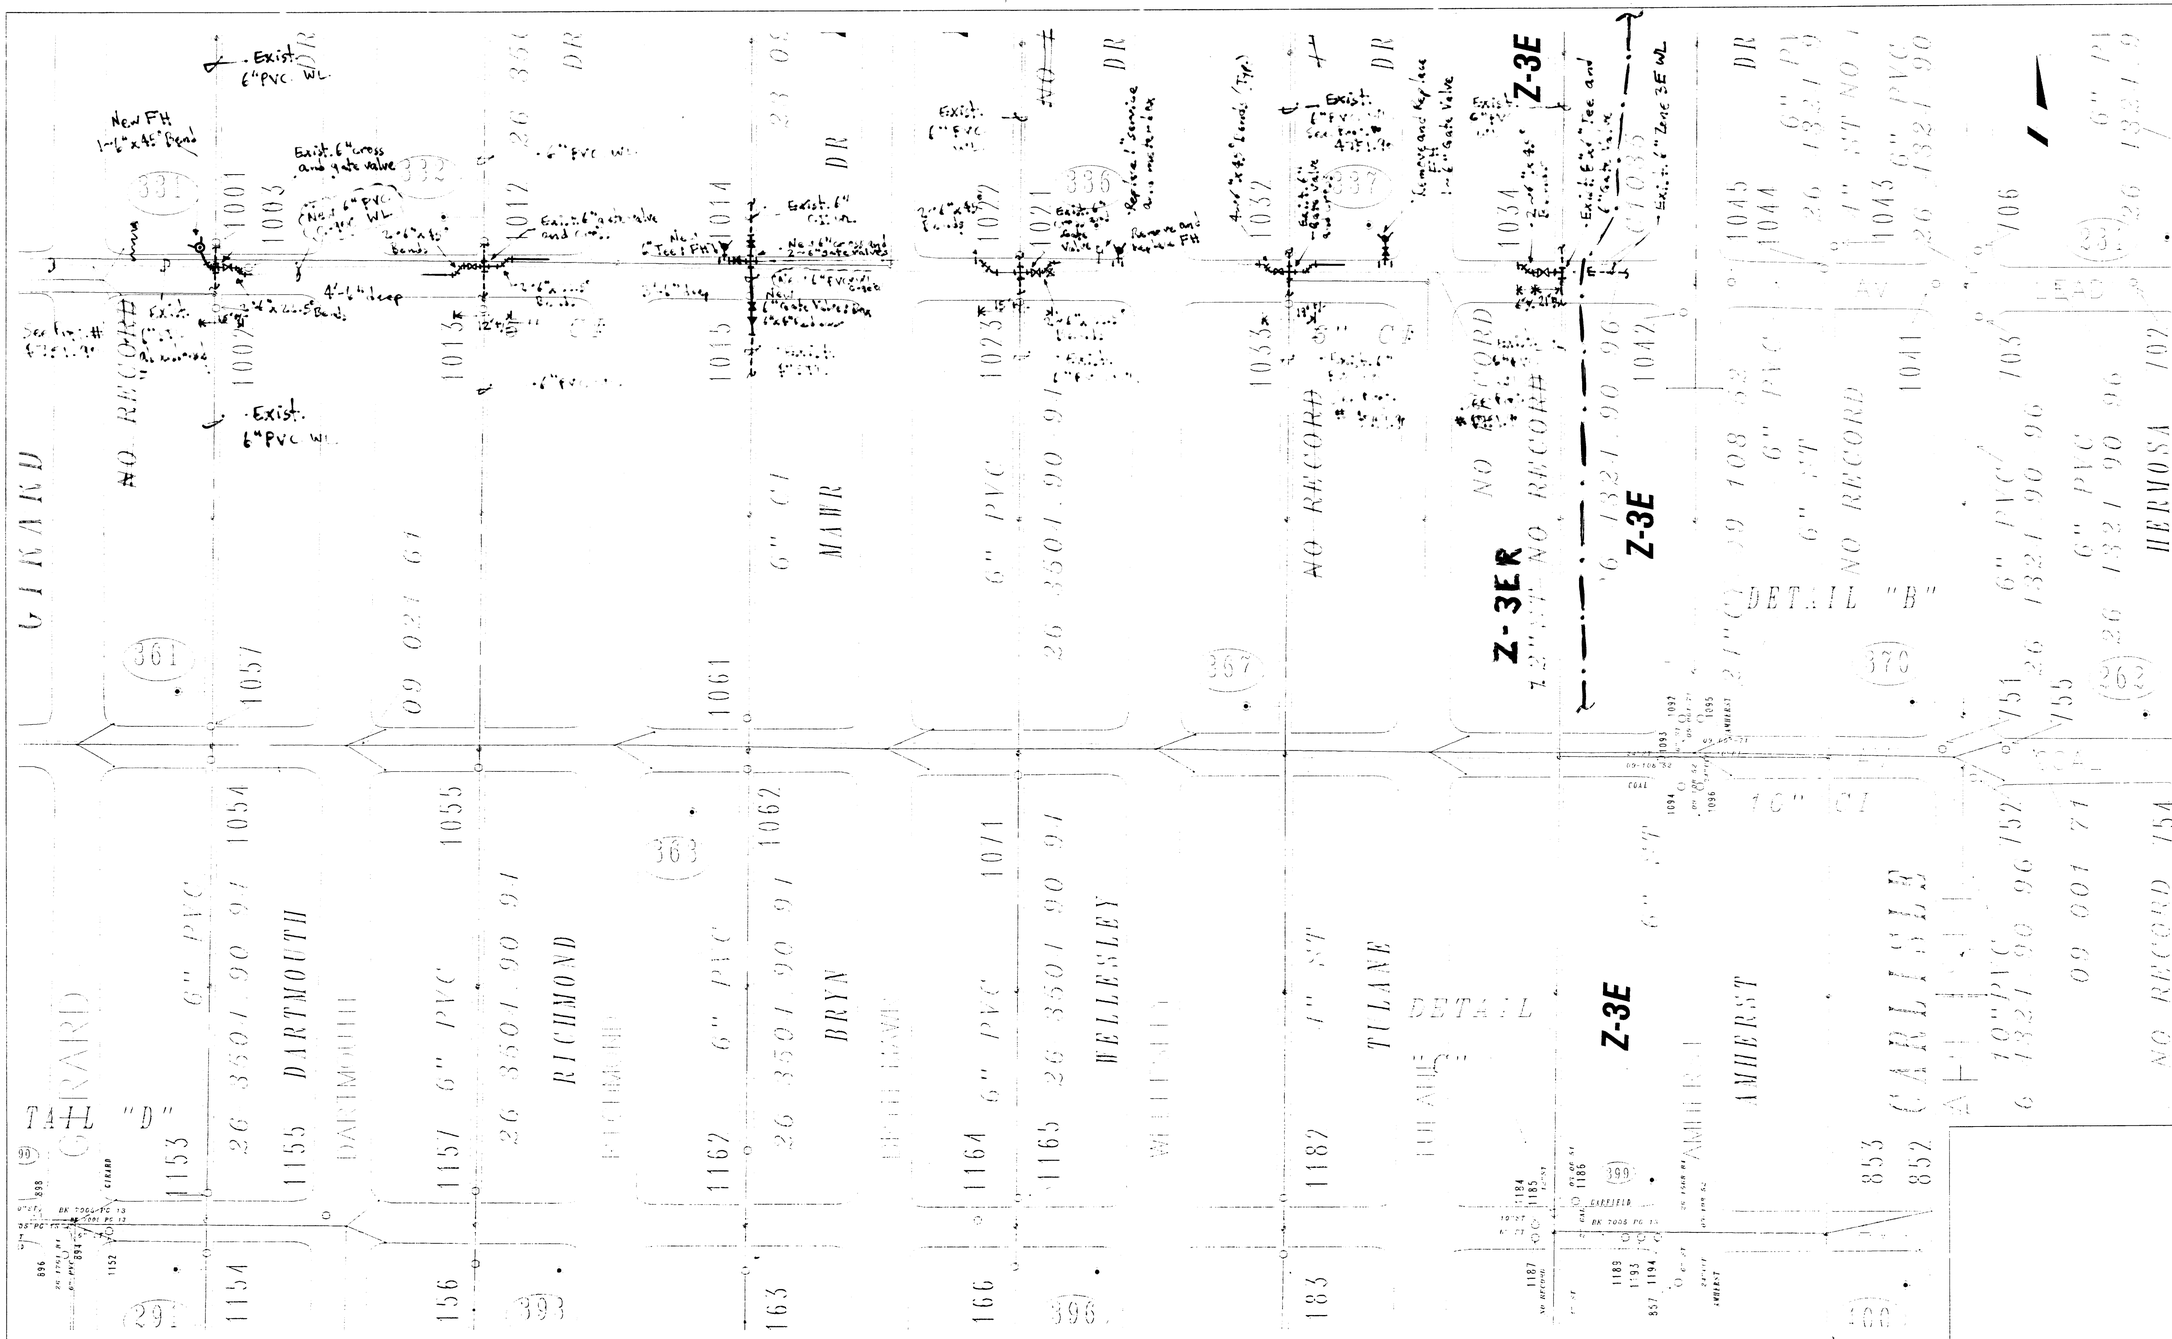

APPROVAL OF AS BUILT DRAWINGS
CHIEF CONSTRUCTION ENGINEER
DATE

AS BUILT INFORMATION
CONTRACTOR Aztec Underground DATE 4/96
WCR
INSPECTOR CEA Inspect DATE 4/96
ACCEPTABLE BY CEA Inspect DATE 4/96
VERIFICATION BY CEA Inspect DATE 4/96
CHECKED BY CEA Inspect DATE 4/96
MICRO-FILM INFORMATION
RECORDED BY DATE
NO.

BENCH MARKS

SURVEY INFORMATION
FIELD NOTES
NO. BY DATE

ENGINEER'S SEAL

NO.	DATE	REMARKS	BY

DESIGN
DESIGNED BY CEA DATE 4/96
DRAWN BY CEA DATE 4/96
CHECKED BY CEA DATE 4/96

CITY OF ALBUQUERQUE
PUBLIC WORKS DEPARTMENT
UTILITY DEVELOPMENT

TITLE: LEAD AVENUE WATERLINE REPLACEMENT
YALE TO CARLISLE

DESIGN REVIEW COMMITTEE	CITY ENGINEER APPROVAL	MO./DAY/YR.	MO./DAY/YR.
N/A	N/A		

City Project No.	Zone Map No.	Sheet	Of
4536.92.	K-16	2	2.

LASON 1-505-344-9404
BEST COPY AVAILABLE

SCANNED BY
BY LASON