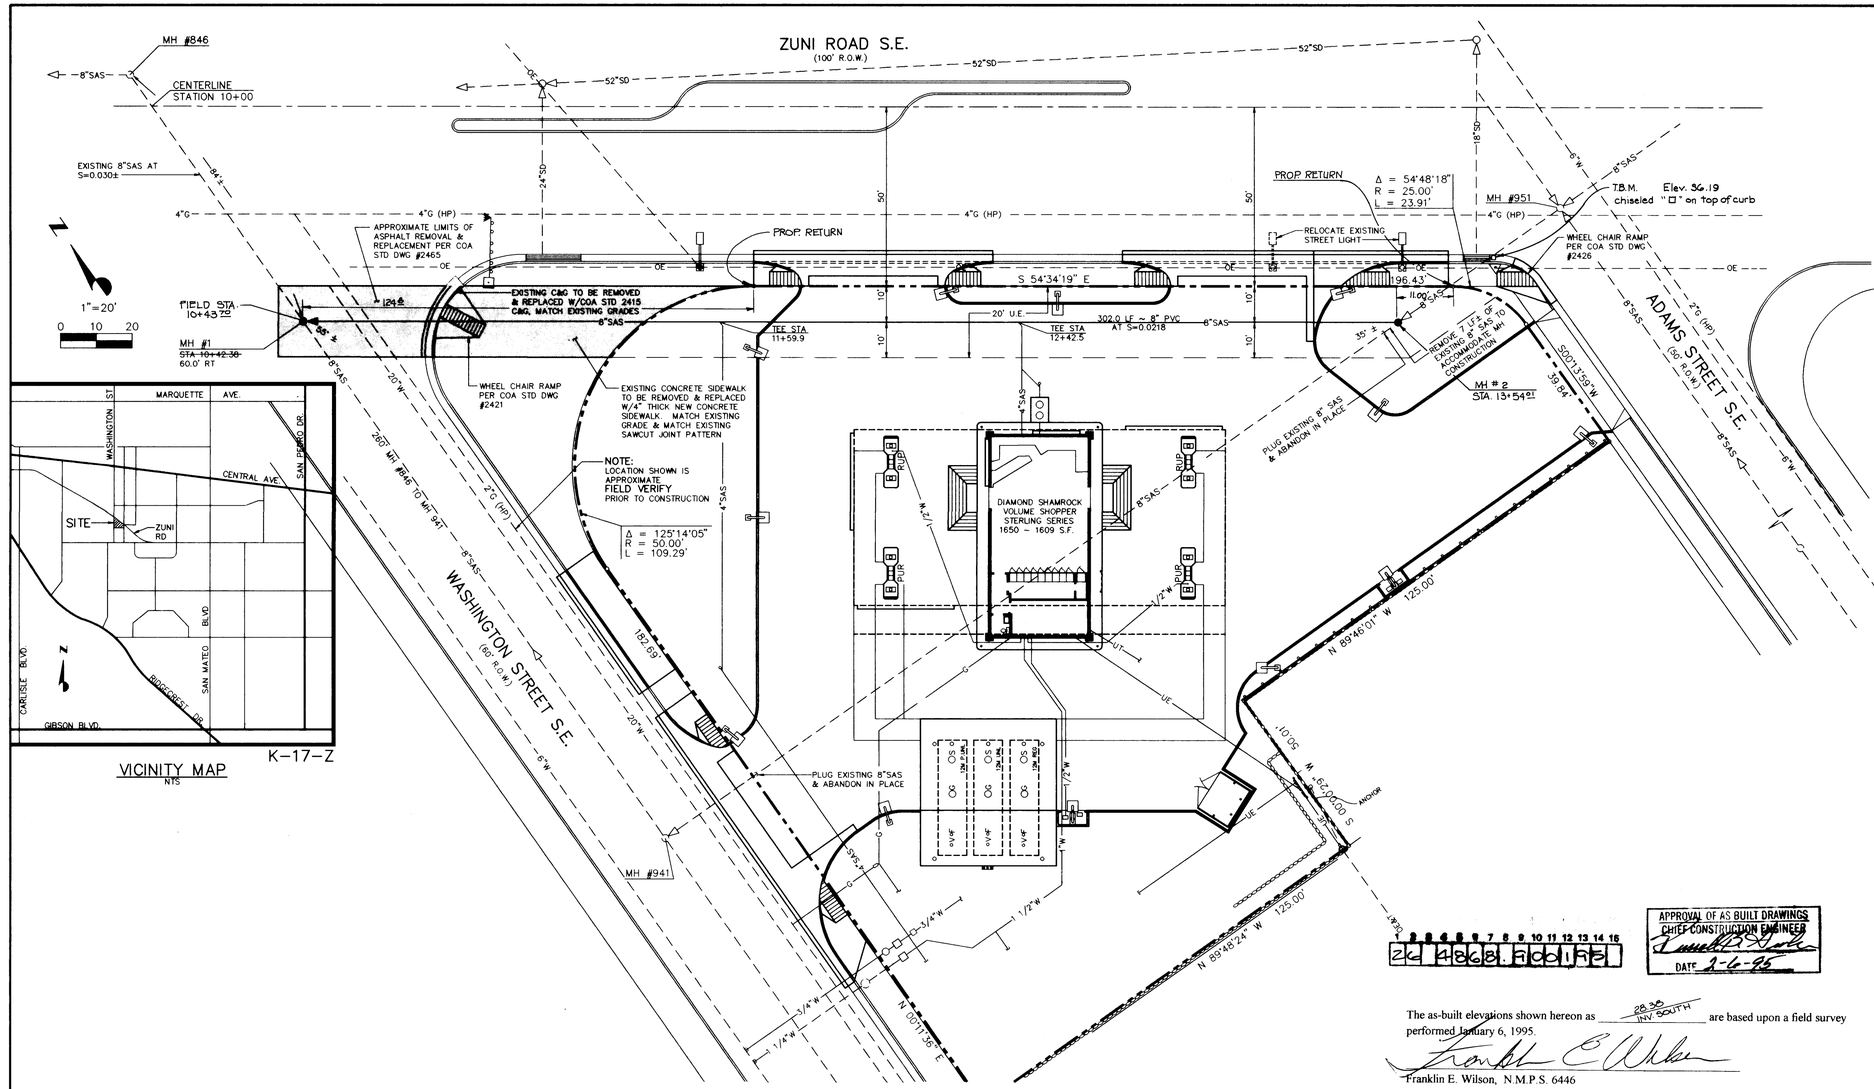

VICINITY MAP
NTS

APPROVAL OF AS BUILT DRAWINGS
CHIEF CONSTRUCTION ENGINEER
DATE 2-6-95

The as-built elevations shown hereon as 28.30 INV. SOUTH are based upon a field survey performed January 6, 1995.

Franklin E. Wilson, N.M.P.S. 6446

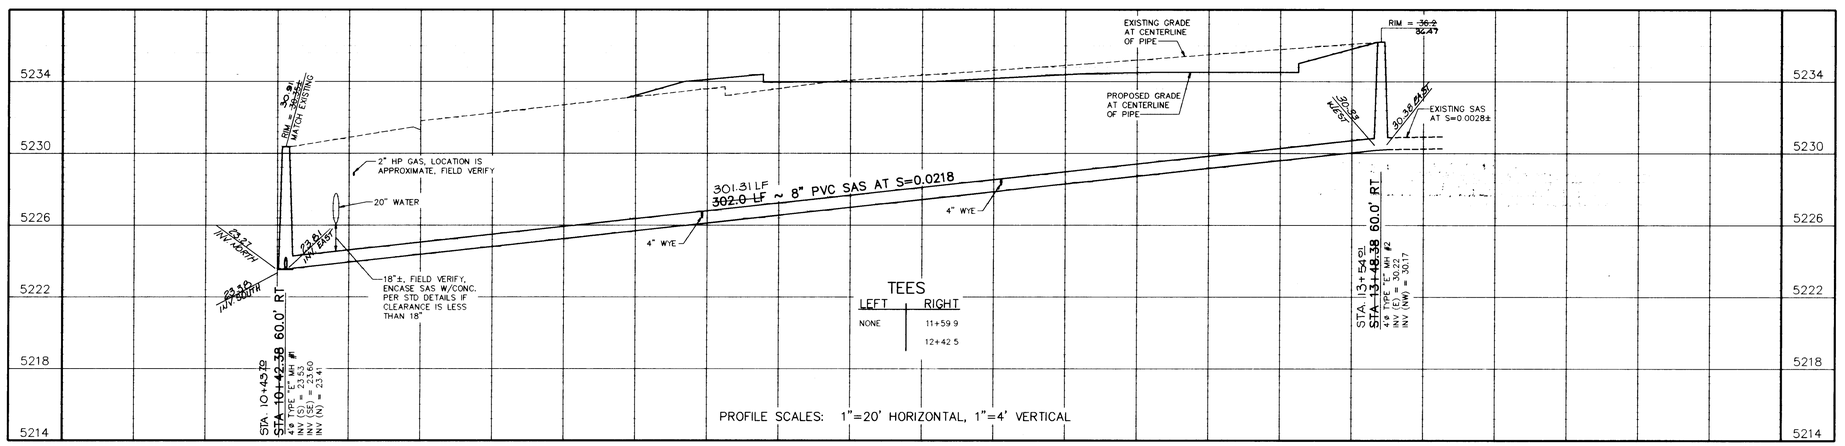

NOTES

1. ALL WORK DETAILED ON THESE PLANS TO BE PERFORMED UNDER CONTRACT SHALL, EXCEPT AS OTHERWISE STATED OR PROVIDED FOR HEREON, BE CONSTRUCTED IN ACCORDANCE WITH THE CITY OF ALBUQUERQUE STANDARD SPECIFICATIONS FOR PUBLIC WORKS CONSTRUCTION – 1986 EDITION W/UPDATE #4.
2. TWO (2) WORKING DAYS PRIOR TO ANY EXCAVATION, CONTRACTOR MUST CONTACT LINE LOCATING SERVICE, 260-1990, FOR LOCATION OF EXISTING UTILITIES.
3. PRIOR TO CONSTRUCTION, THE CONTRACTOR SHALL EXCAVATE AND VERIFY THE HORIZONTAL AND VERTICAL LOCATIONS OF ALL OBSTRUCTIONS. SHOULD A CONFLICT EXIST, THE CONTRACTOR SHALL NOTIFY THE ENGINEER OR SURVEYOR SO THAT THE CONFLICT CAN BE RESOLVED WITH MINIMUM AMOUNT OF DELAY.
4. IF ANY UTILITY LINES, PIPELINES OR UNDERGROUND UTILITY LINES ARE SHOWN ON THESE DRAWINGS, THEY ARE SHOWN IN AN APPROXIMATE MANNER ONLY, AND SUCH LINES MAY EXIST WHERE NONE ARE SHOWN. IF ANY SUCH EXISTING LINES ARE SHOWN, THE LOCATION IS BASED UPON INFORMATION PROVIDED BY THE OWNER OF SAID UTILITY, AND THE INFORMATION MAY BE INCOMPLETE, OR MAY BE OBSOLETE BY THE TIME CONSTRUCTION COMMENCES. THE ENGINEER HAS UNDERTAKEN NO FIELD VERIFICATION OF THE LOCATION, DEPTH, SIZE OR TYPE OF EXISTING UTILITY LINES, PIPELINES OR UNDERGROUND UTILITY LINES. THE CONTRACTOR SHALL INFORM HIMSELF OF THE LOCATION OF ANY UTILITY LINE, PIPELINE OR UNDERGROUND UTILITY LINE IN OR NEAR THE AREA OF THE WORK IN ADVANCE OF AND DURING EXCAVATION WORK. THE CONTRACTOR IS FULLY RESPONSIBLE FOR ANY AND ALL DAMAGE CAUSED BY HIS FAILURE TO LOCATE, IDENTIFY AND PRESERVE ANY AND ALL EXISTING UTILITIES, PIPELINES AND UNDERGROUND UTILITY LINES. IN PLANNING AND CONDUCTING EXCAVATION, THE CONTRACTOR SHALL COMPLY WITH STATE STATUES, MUNICIPAL AND LOCAL ORDINANCES, RULES AND REGULATIONS, IF ANY, PERTAINING TO THE LOCATION OF THESE LINES AND FACILITIES.
5. THE CONTRACTOR SHALL BE RESPONSIBLE FOR DETERMINING, IN ADVANCE OF HIS CONSTRUCTION, IF OVERHEAD UTILITY LINES SUPPORT STRUCTURES, POLES, GUYS, ETC. ARE AN OBSTRUCTION TO CONSTRUCTION OPERATIONS. IF ANY OBSTRUCTION TO CONSTRUCTION OPERATIONS IS EVIDENT, THE CONTRACTOR SHALL BE RESPONSIBLE FOR COORDINATING WITH THE APPROPRIATE UTILITY OWNER TO REMOVE OR SUPPORT THE UTILITY OBSTRUCTION. ANY COST ASSOCIATED WITH THIS EFFORT SHALL BE THE RESPONSIBILITY OF THE CONTRACTOR.
6. CONTRACTOR IS TO SUPPORT AND MAINTAIN THE INTEGRITY OF ALL UNDERGROUND TELEPHONE, ELECTRIC CABLES AND CABLE TELEVISION UTILITIES AT NO ADDITIONAL COST TO THE OWNER. CABLE IS TO BE SUPPORTED EVERY 15' (MINIMUM). CONTRACTOR SHALL COORDINATE WITH AND MAKE NECESSARY PAYMENT (IF ANY) TO UTILITY OWNER FOR DE-ENERGIZATION OF CABLES OR SUPPORT OF CABLES BY THE UTILITY OWNER.
7. THE CONTRACTOR SHALL ASSIST THE ENGINEER/INSPECTOR IN THE RECORDING OF DATA ON ALL UTILITY LINES AND ACCESSORIES AS REQUIRED BY THE OWNERS FOR THE PREPERATION OF "RECORD DRAWINGS". THE CONTRACTOR SHALL NOT COVER UTILITY LINES AND ACCESSORIES UNTIL ALL DATA HAS BEEN RECORDED.
8. ALL CONSTRUCTION WITHIN CITY RIGHT-OF-WAY OR EASEMENTS MUST BE DONE FROM APPROVED WORK ORDER DOCUMENTS FROM THE CITY OF ALBUQUERQUE AND PREPARED BY GALLOWAY, ROMERO & ASSOCIATES.
9. THREE (3) WORKING DAYS PRIOR TO BEGINNING CONSTRUCTION THE CONTRACTOR SHALL SUBMIT TO THE CONSTRUCTION CO-ORDINATOR DIVISION A DETAILED CONSTRUCTION SCHEDULE. TWO (2) WORKING DAYS PRIOR TO CONSTRUCTION THE CONTRACTOR SHALL OBTAIN A BARRICADING PERMIT FROM THE CONSTRUCTION CO-ORDINATOR DIVISION. CONTRACTOR SHALL NOTIFY BARRICADE ENGINEER (768-2551) PRIOR TO OCCUPYING AN INTERSECTION. SEE SECTION 19 OF THE SPECIFICATIONS.
10. ALL STREET STRIPING ALTERED OR DESTROYED SHALL BE REPLACED IN KIND BY CONTRACTOR TO LOCATION AND IN KIND AS EXISTING OR AS INDICATED BY THIS PLAN SET.
11. ALL FINAL BACKFILL FOR TRENCHES SHALL BE COMPACTED TO A MINIMUM 90% MAXIMUM DENSITY PER ASTM-D1557 AND AS DIRECTED BY SECTION 701.14.2 AND STANDARD DRAWING 2315.

LEGEND

- EXIST SANITARY SEWER MAIN
- EXIST SANITARY SEWER MANHOLE
- PROPOSED SANITARY SEWER MAIN
- PROPOSED SANITARY SEWER MANHOLE
- PROPOSED GATE VALVE
- EXIST GATE VALVE
- EXIST WATER MAIN
- PROPOSED WATER MAIN
- EXIST STORM DRAIN
- PROPOSED STORM DRAIN
- EXIST GAS LINE
- PROPOSED GAS LINE
- EXIST UNDERGROUND ELECTRICAL
- PROPOSED UNDERGROUND ELECTRICAL
- EXIST OVERHEAD ELECTRICAL
- PROPOSED OVERHEAD ELECTRICAL
- EXIST UNDERGROUND TELEPHONE
- PROPOSED UNDERGROUND TELEPHONE
- EXIST OVERHEAD TELEPHONE

SURVEY INFORMATION
FIELD NOTES

NO.	BY	DATE
1	SOUTHWEST SURVEY CO.	11/19/93

BENCH MARKS
BENCH MARK: ALBUQUERQUE STATION 8-K-17, A 3 1/4" ALUMINUM TABLET SET IN A DRILL HOLE FLUSH WITH THE TOP OF CURB AT THE NOSE OF THE MEDIAN AT THE LEAD AVE. S.E./COAL AVE. S.E. AND WASHINGTON ST. S.E. INTERSECTION. STATION IS STAMPED "ACS, 8-K 17, 1984."
ELEVATION = 5229.820

AS BUILT INFORMATION
CONTRACTOR TLC
WORK STAKED BY Southwest Survey DATE 1/31/95
ACCEPTANCE BY R. Baca DATE 1/31/95
FIELD INSPECTION BY Frank Wilson DATE 1/31/95
DRAWINGS CORRECTED BY Franc Wilson DATE 1/31/95
MICRO-FILM INFORMATION
RECORDED BY
DATE
NO.

ENGINEER'S SEAL

NO.	DATE	REMARKS	BY
1	3/11/94	PER DRC COMMENTS	LLP

REVISIONS

DESIGN		
DESIGNED BY	LLP	DATE 2/11/94
DRAWN BY	RDG	DATE 2/11/94
CHECKED BY	LLP	DATE 2/11/94

CITY OF ALBUQUERQUE
MUNICIPAL DEVELOPEMENT DEPARTMENT
ENGINEERING DIVISION

TITLE DIAMOND SHAMROCK - ZUNI & WASHINGTON
SANITARY SEWER PLAN & PROFILE

APPROVALS	ENGINEER	DATE	APPROVALS	ENGINEER	DATE
DRC Chairman		4-11-94	Water	R.W. Kane	3-18-94
Transportation		3-22-94	Wastewater	R.W. Kane	3-18-94
Hydrology		3/24/94			

DRAWING NO. 4868.90 | MAP NO. K-17 | SHEET 1 OF 1 (SP-3.3)

APPROVED FOR CONSTRUCTION
CITY ENGINEER 10/5/94 DATE

SCANNED BY BY LASON