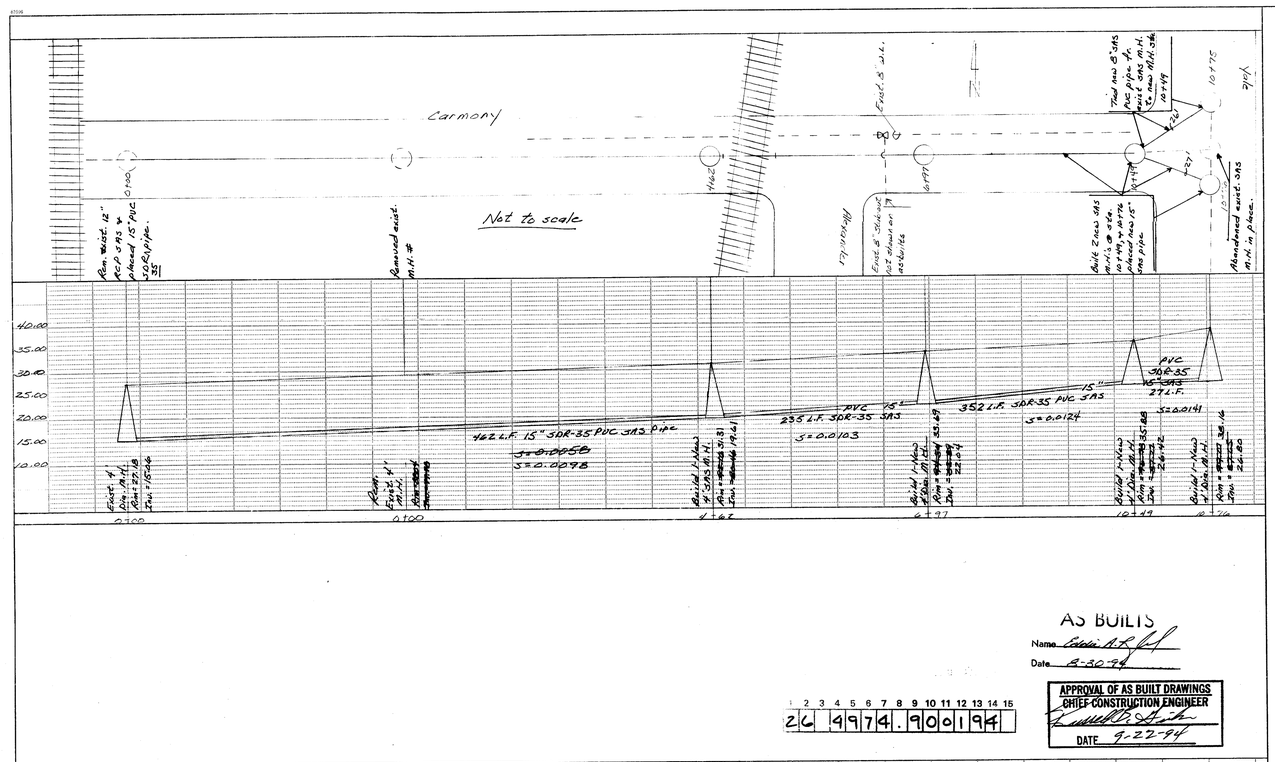

AS BUILTS
Name Eddie A.R. [illegible]
Date 8-30-94

1 2 3 4 5 6 7 8 9 10 11 12 13 14 15
2 6 4 9 7 4 . 9 0 0 1 9 4

APPROVAL OF AS BUILT DRAWINGS
CHIEF CONSTRUCTION ENGINEER
[illegible]
DATE 9-22-94

AS BUILT INFORMATION
CONTRACTOR [illegible]
FIELD INSPECTOR [illegible]
ENGINEER [illegible]
FIELD VERIFICATION BY [illegible]
DATE [illegible]
DRAWING NO. MICRO-FILM INFORMATION
SHEET NO.
DRAWING NO.
NO.

BENCH MARKS

SURVEY INFORMATION
FIELD NOTES
NO. BY DATE

ENGINEER'S SEAL

NO.	DATE	REMARKS	BY
		REVISIONS	

DESIGN
DESIGNED BY — DATE
DRAWN BY — DATE
CHECKED BY — DATE

CITY OF ALBUQUERQUE
MUNICIPAL DEVELOPMENT DEPARTMENT
ENGINEERING DIVISION

TITLE: Emergency SAS Replacement on Carmony b/w Yale & Alexander N.E.

APPROVALS	ENGINEER	DATE	APPROVALS	ENGINEER	DATE
City Engineer			Liquid Waste		
A.C.E.-Design			Traffic		
A.C.E.-Hydrology			Water		

DRAWING NO. 41974.90 | MAP NO. G-15 | SHEET 1 OF 1

SCANNED BY
BY LASON