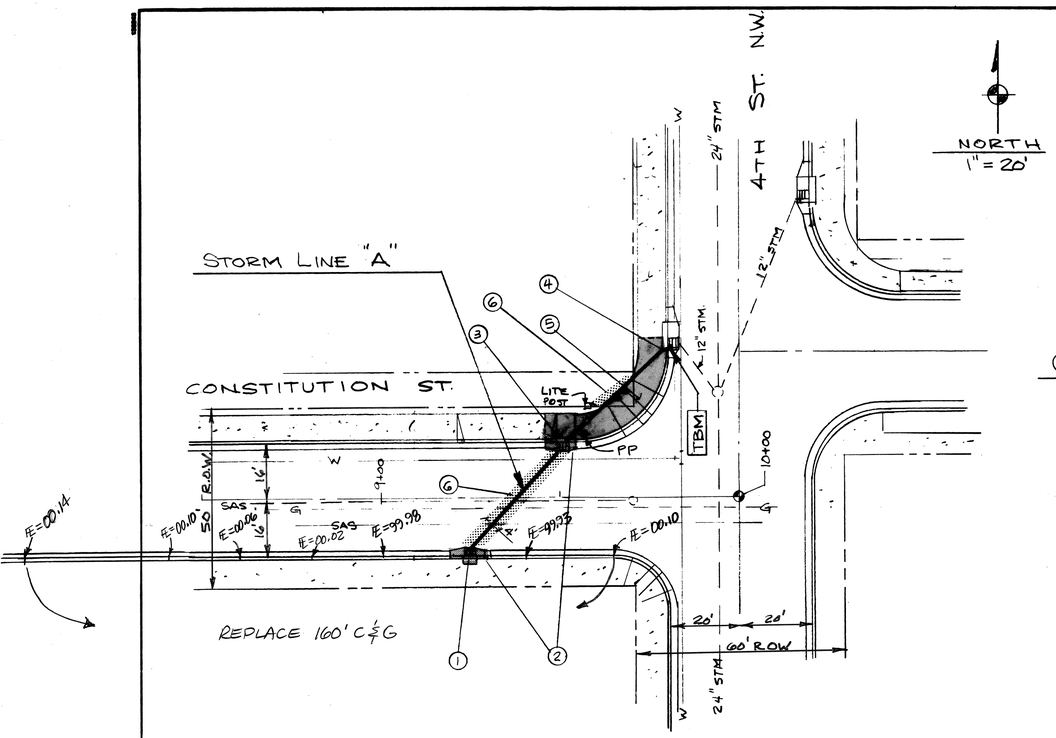


## LEGEND

1. Storm Line "A", Sta ~~0+80~~ 0+81. Construct Type "C" inlet (St. Sta ~~9+25~~ 9+30) per Std Dwg 2205. Sawcut and remove sidewalk to match edges of inlet.
2. Remove and Replace 12 lin. ft. of std curb and gutter, two (2) locations.
3. Storm Line "A", Sta ~~0+40~~ 0+34 Const. Type "C" inlet (St Sta ~~9+50~~ 9+62.5) per Std Dwg 2205.
4. Storm Line "A", Sta 0+00. Connect 8" DIP to existing Type "A" inlet. See Std. Dwg. No. 2237.
5. Remove and replace existing 4" concrete sidewalk, driveway, and wheelchair ramp to match existing, total of 300 sq. ft. See Std Dwg 2441, Case I. Remove and reinstall 2 (two) bollard posts. Existing curb and gutter to remain in place.
6. Sawcut and remove existing pavement. Replace with residential asphaltic concrete pavement. See Std. Dwg 2465.

PROJECT LOCATION

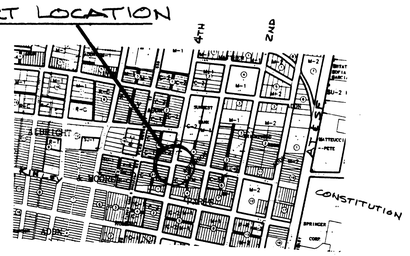


VICINITY MAP, ZM-J14

SURVEYOR'S CERTIFICATION

"I, Timothy Aldrich, a duly qualified Registered Professional Land Surveyor under the laws of the State of New Mexico, do hereby certify that the 'as-built' information shown on these drawings was obtained from field construction and 'as-built' surveys performed by me or under my supervision, that the 'as-built' information shown on these drawings was added by me or under my supervision, and that this 'as-built' information is true and correct to the best of my knowledge and belief." Aldrich Land Surveying is not responsible for any of the design concepts, calculations, engineering, or intent of the record drawings.

Timothy A. Aldrich, P.S. No. 7719 — 3-28-95 Date

**GENERAL NOTES:**

1. All work detailed on these plans to be performed under contract shall, except as otherwise stated or provided for hereon, be constructed in accordance with the City of Albuquerque Standard Specifications - Public Works Construction 1986(including all revision updates-No's. 1 thru 4).
2. Two (2) working days prior to any excavation, contractor must contact New Mexico one call system, 260-1990, for location of existing utilities.
3. Should a conflict exist between these plans and actual field conditions, the contractor shall promptly notify the Engineer in writing so that the conflict can be resolved with a minimum amount of delay for all parties.
4. The contractor shall maintain access to adjacent properties during construction.
5. All work on this project shall be performed in accordance with applicable Federal, State and local laws, rules and regulations concerning safety and health.
6. All stationing shall be based on construction base line.
7. Contractor shall comply with section 19 of the "Standard Specifications".
8. Backfill compaction shall be according to specified street use.
9. Contractor shall notify the Engineer not less than seven (7) days prior to starting work in order that the Engineer may take necessary measures to insure the preservation of survey monuments. Contractor shall not disturb permanent survey monuments without the consent of the Engineer and shall notify the Engineer and bear the expense of replacing any that may be disturbed without permission. Replacement shall be done only by the Engineer. When a change is made in the finished elevation of the pavement of any roadway in which a permanent survey monument is located, contractor shall, at his own expense, adjust the monument cover to the new grade unless otherwise specified. Refer to section 4.4 of the specifications.
10. Three (3) working days prior to beginning construction the contractor shall submit to the Construction Co-ordination Division a detailed construction schedule. Two (2) working days prior to construction the contractor shall obtain a barricading permit from the Construction Co-ordination Division. Contractor shall notify barricade engineer (768-2551) prior to occupying an intersection. Contractor must refer to section 19 of the specifications for traffic control.
11. All street striping altered or destroyed shall be replaced in kind by contractor to location and in kind as existing or as indicated by this plan set.

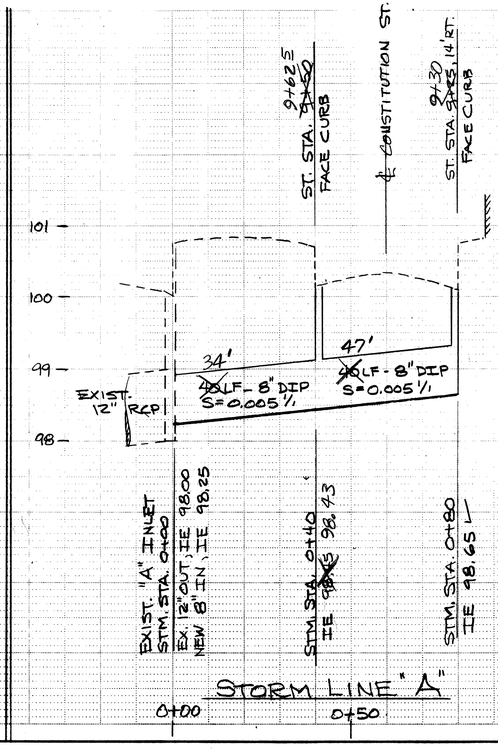


APPROVAL OF AS BUILT DRAWINGS
CHIEF CONSTRUCTION ENGINEER
DATE 6-2-97

2 3 4 5 6 7 8 9 10 11 12 13 14 15 16
26-5006.90 0197

APPROVED
CITY ENGINEER
8/18/94

AS BUILT INFORMATION
CONTRACTOR CGM, INC. DATE 94
WORKED BY ALS, INC DATE 94
INSPECTOR'S ACCEPTANCE
FIELD VERIFICATION BY ALS, INC DATE 94
COMPUTATIONS COMPILED BY ALS, INC DATE 94
MICRO-FILM INFORMATION
RECORDED BY DATE
NO

BENCH MARKS
ASSUMED TBM ELEV. 100.00
SW COR. INLET GRATE, AT FACE OF CURB.

SURVEY INFORMATION
FIELD NOTES

| NO. | BY | DATE |
|---|---|---|

REVISIONS

| NO. | BY | DATE |
|---|---|---|
| | REMARKS | |
| | DESIGN | DATE July 94 |
| | DESIGNED BY L. MEINZ | DATE July 94 |
| | DRAWN BY | DATE |
| | CHECKED BY | |

ENGINEER'S SEAL

CITY OF ALBUQUERQUE
PUBLIC WORKS DEPARTMENT
ENGINEERING GROUP

TITLE: CONSTITUTION @ 4TH, N.W.
STORM DRAINAGE IMPROVEMENTS

| APPROVALS | ENGINEER | DATE | APPROVALS | ENGINEER | DATE |
|---|---|---|---|---|---|
| D.R.C. Chair | | 8-16-94 | Water | Roger N. Green | 8.11.94 |
| Trans. Dev. | | | Wastewater | | " " |
| Hydrology | | 8/12/94 | Parks & Rec. | | |
| | | | | | |

DRAWING NO. 5006.90 | MAP NO. J-14 | SHEET 1 OF 1