


## COCHITI ROAD, S.E.

SCALE HORIZ 1" = 20'
VERT 1" = 5'

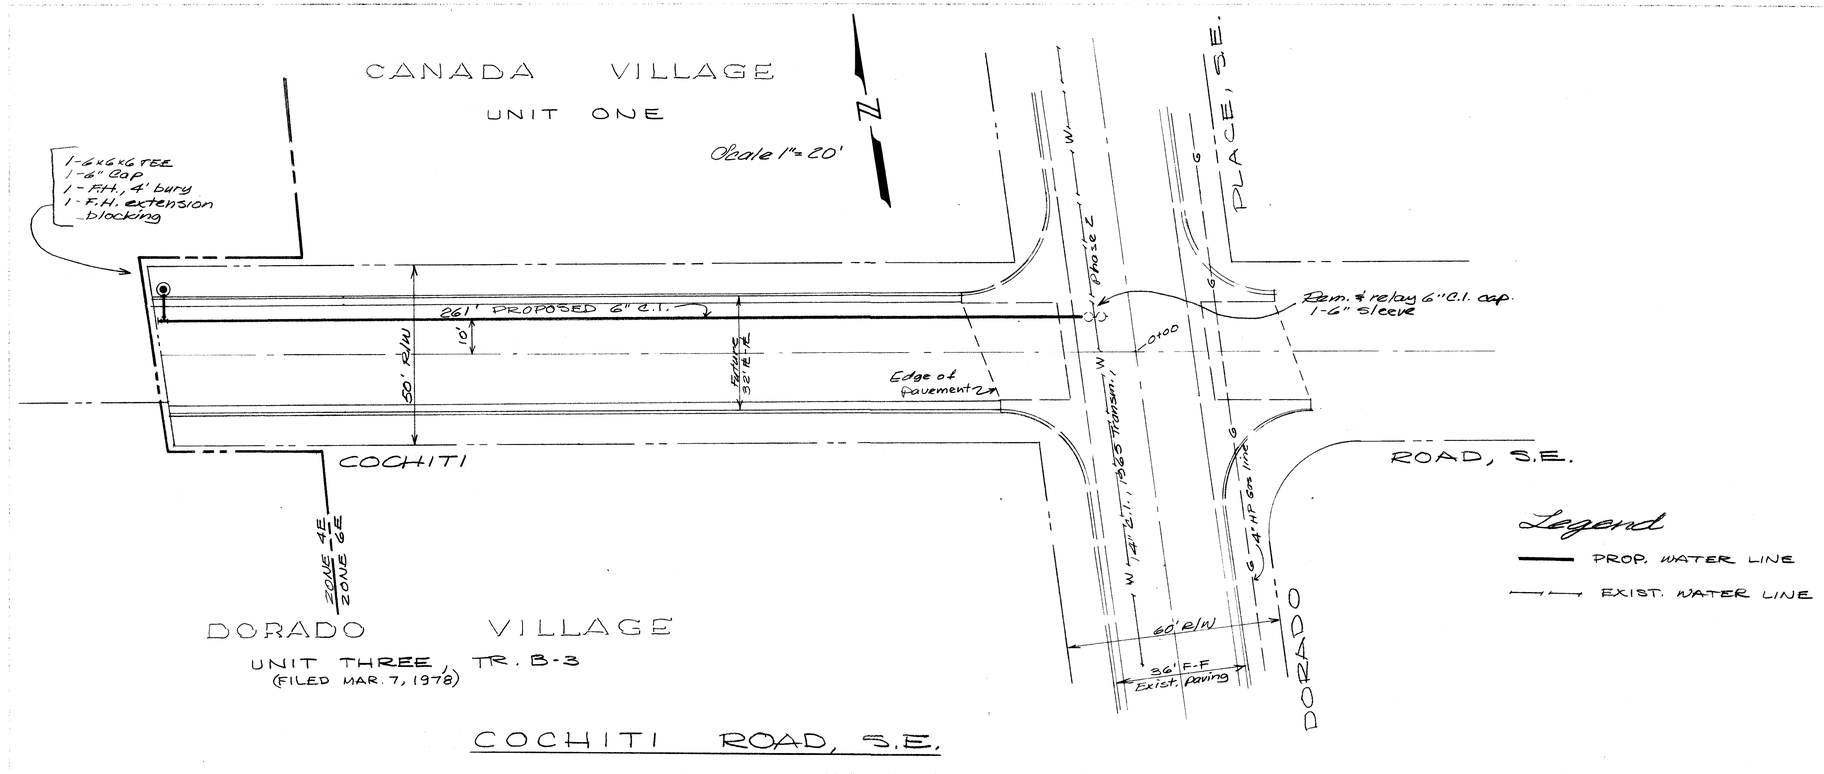


SCANNED BY LASER

(Called Gas Co. 4/24/78)

23 050 0178

APPROVAL OF AS BUILT DRAWINGS
ASST. CITY ENGINEER FIELD
DATE

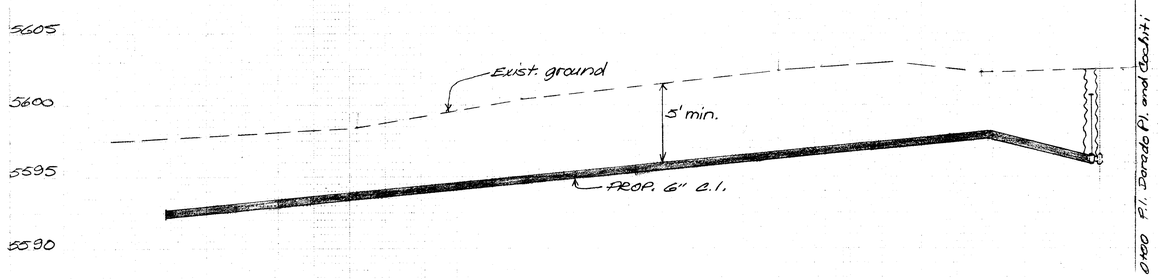AS BUILT INFORMATION
JR HOLE
M.R. CHAVEZ DATE 11-30-79
ORTEGA, P. DATE 3-2-79
RECORD DATE
NO. 23-050-0178-----01-----5722178

APPROVED FOR CONSTRUCTION
CITY ENGINEER DATE 6-22-78

CITY OF ALBUQUERQUE
PUBLIC WORKS DEPARTMENT
ENGINEERING DIVISION

TITLE: WATER EXTENSION IN COCHITI RD. W. OF DORADO PLACE

| APPROVALS | ENGINEER | DATE | APPROVALS | ENGINEER | DATE |
|---|---|---|---|---|---|
| City Engineer | | 4-26-78 | Liquid Waste | | |
| A.C.E.-Design | | 24 Apr 78 | Traffic | | |
| A.C.E.-Hydrology | | | Water | | |

DRAWING NO. W-50-78 SHEET 1 OF 1

AS BUILT INFORMATION
MONUMENTATION
NOTE
CITY
DATE
SURVEY INFORMATION
FIELD NOTES
BY
DATE
NO.
BENCH MARKS
1-L22
5608.42
REFERENCES
MAP NO. L22
W. O. NO.
EST. NO. W-50-78
REMARKS
REVISIONS
BY
NO. DATE
DESIGN C. TOMLINSON
DRAWN B. EMMETT
DATE