2

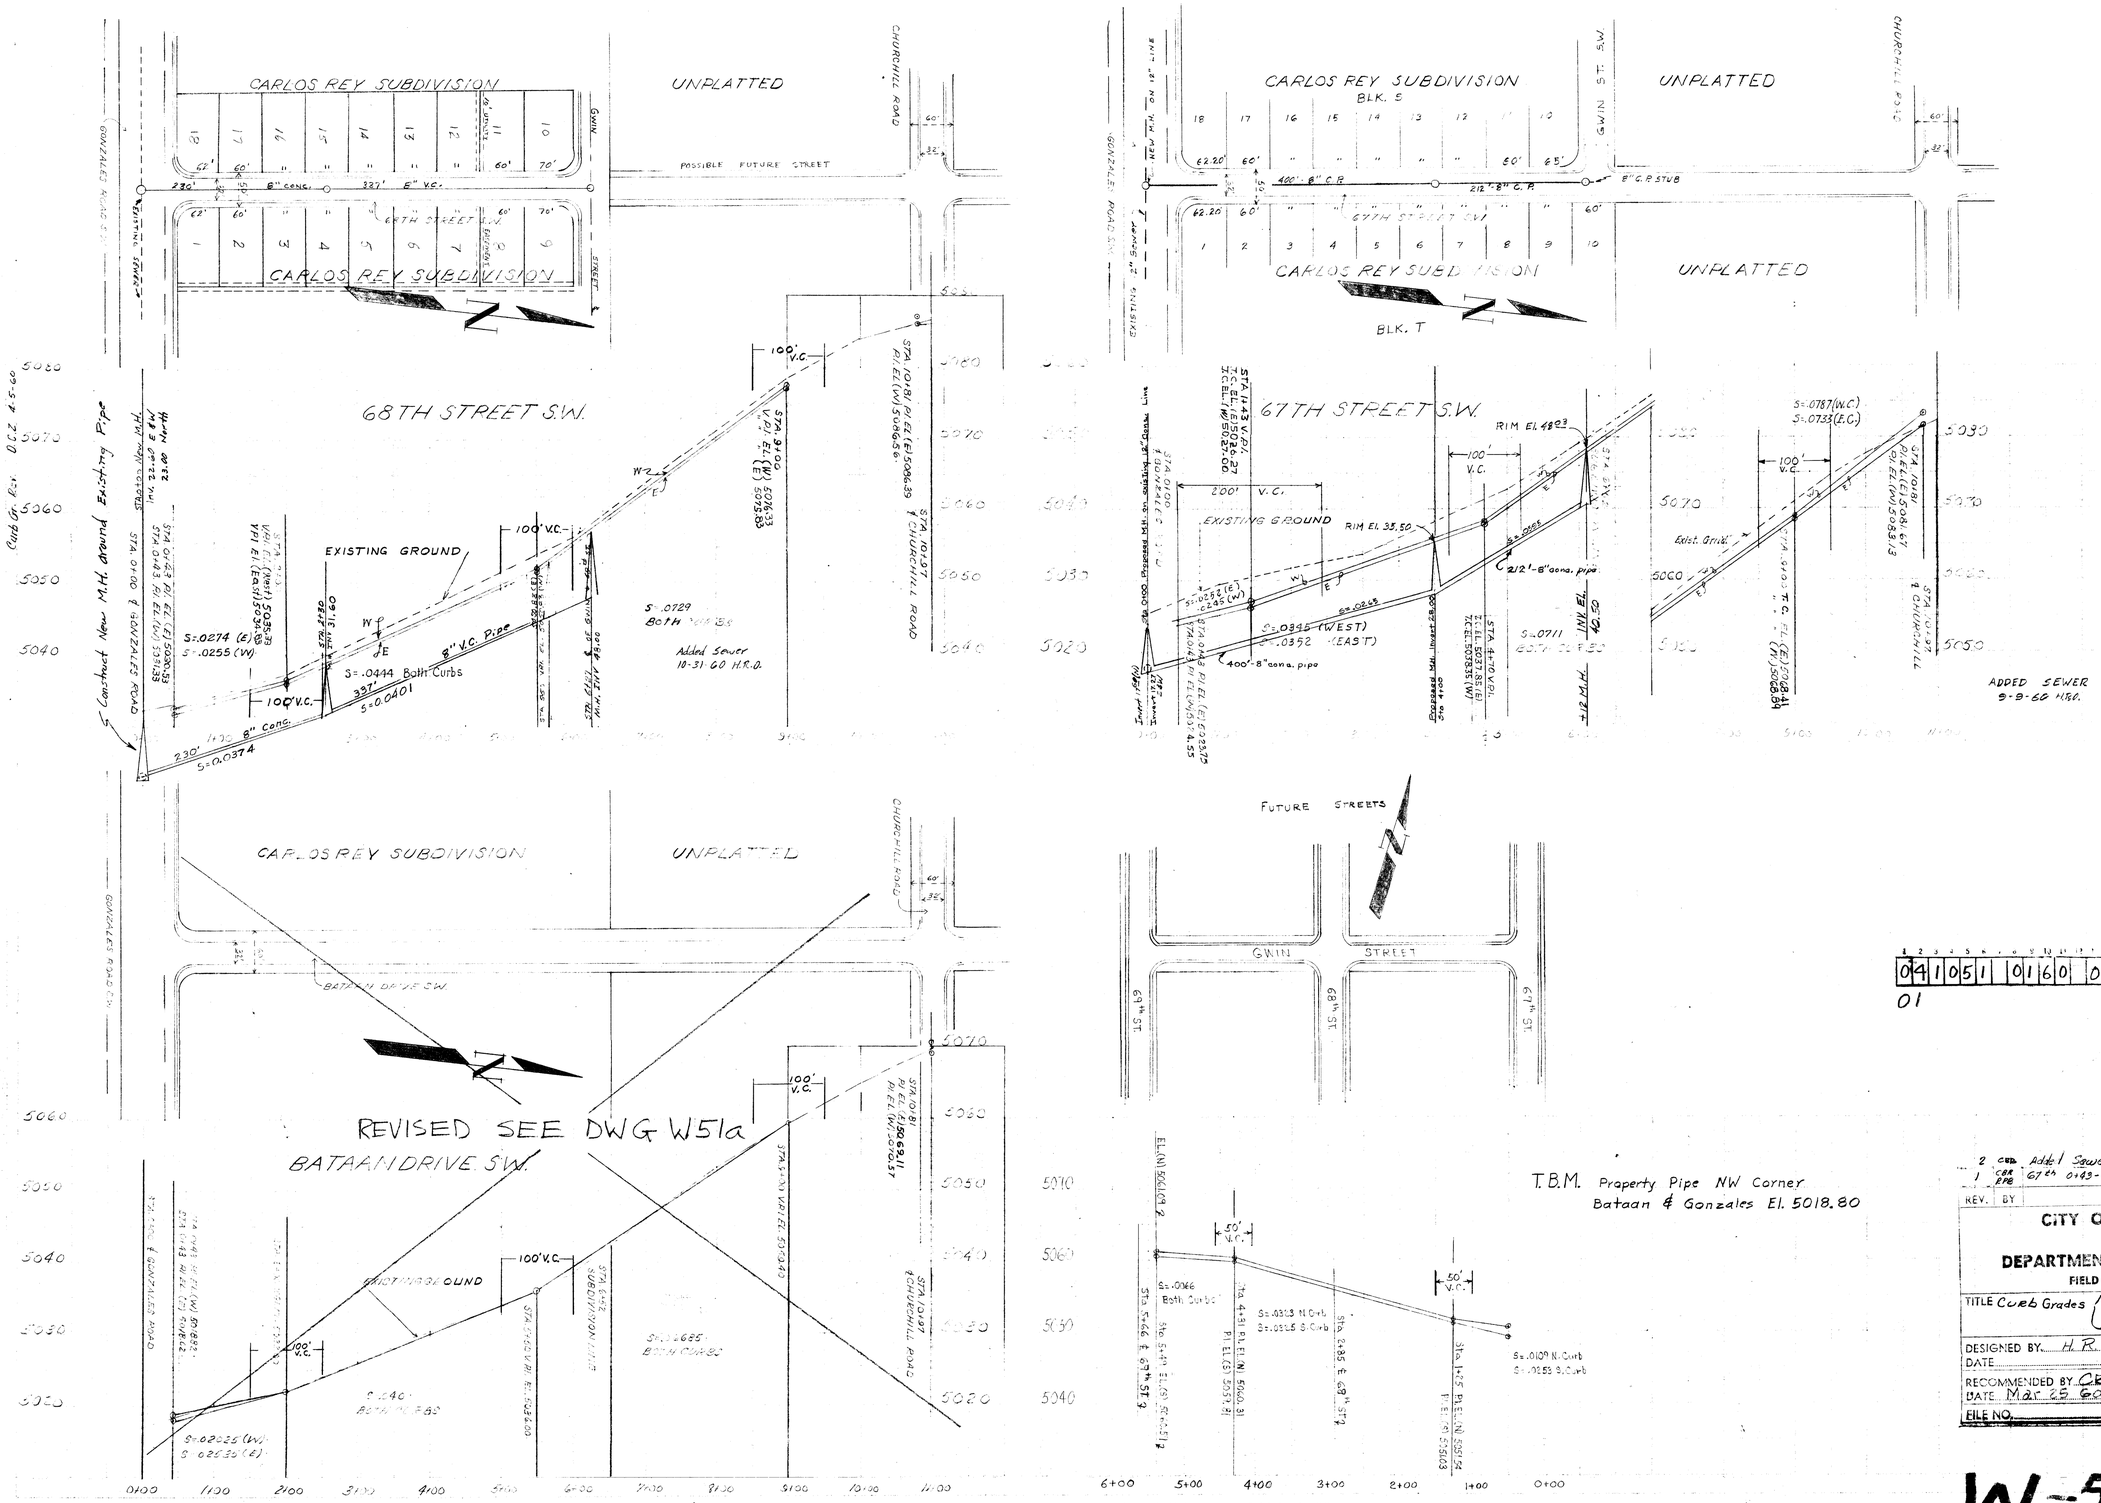

2	CBR	Add'l Sewer 68th	Nov 1, 60
1	CBR RHB	67th 0+43-4+70 Curb Grades	Junco
REV.	BY		DATE

CITY OF ALBUQUERQUE
NEW MEXICO
DEPARTMENT OF PUBLIC WORKS
FIELD & DESIGN DIVISION

TITLE Curb Grades — 68TH STREET, 67TH, BATAAN DRIVE

DESIGNED BY H.R.O.	DRAWN BY R.G.F.
DATE	DATE 3-23-60
RECOMMENDED BY CBR	APPROVED BY W.J. Hennessy
DATE Mar 25 60	DATE 3-24-60
FILE NO.	SHEET 1 OF 1 SHEETS

04 1 05 1 01 60 01 57 1 2
01

W-51

SCANNED BY BY LASON