LOCATION MAP D-16-Z

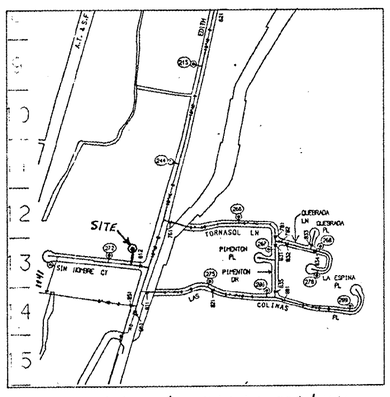

SHUT OFF VALVES 812 (EDITH & SIN NOMBRE) & 1141 (SE COR. LOT 8)

WATER MAP D-16

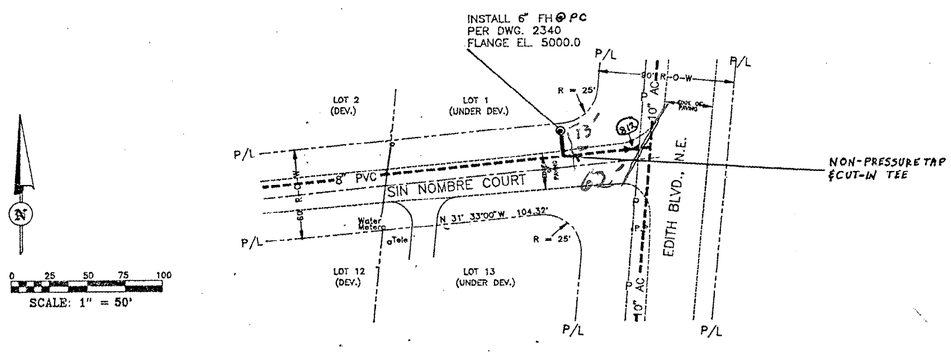

SITE CONFIGURATION

LEGEND

- PROPERTY LINE
- EXIST. WATER LINE
- PROPOSED WATER LINE
- FIRE HYDRANT
- VALVE

3'6" 3'6" 3'5" 3'1"

Jesse Carlin (Inspector) checked that it does indeed exist For Informational Purposes For Facility Mapping

APPROVED FOR CONSTRUCTION
CITY ENGINEER 6/14/95 DATE

B. Wolfe 9/26/96

AS BUILT INFORMATION

CONTRACTOR WORK STAKED BY: DAS
INSPECTOR'S FIELD VERIFICATION BY: DAS
DRAWING CORRECTED BY: DK
MICRO-FILM INFORMATION BY: DK
RECORDED BY: DK

BENCH MARKS

BM ACS STA. 1-D16 LOCATED 0.5 MI. SOUTH OF LOS RANCHOS, N.E. OPPOSITE HOUSE NUMBER 7337 ON THE WEST SIDE OF EDITH, N.E. DESCRIPTION- 40 PENNY NAIL IN POWER POLE; ELEV. 5000.63

SURVEY INFORMATION

FIELD NOTES BY: DATE:

ENGINEER'S SEAL

CARROLL A. COONCE NEW MEXICO 2934 REGISTERED PROFESSIONAL ENGINEER
C.A.C. 5/22/95

NO.	DATE	REMARKS	BY
		REVISIONS	
		DESIGN	
		DESIGNED BY C.A. COONCE & ASSOC., INC.	DATE 05/22/95
		DRAWN BY LSC	DATE 05/22/95
		CHECKED BY CAC	DATE 05/22/95

THE FOLLOWING NOTES ALSO APPLY WHEN CHECKED

- ☐ UTILITIES AND UTILITY SERVICE LINES SHALL BE INSTALLED PRIOR TO PAVING.
- ☐ BACKFILL COMPACTION SHALL BE ACCORDING TO SPECIFIED STREET USE.
- ☐ TACK COAT REQUIREMENTS SHALL BE DETERMINED BY THE CITY ENGINEER.
- ☐ SIDEWALKS AND WHEELCHAIR RAMPS WITHIN THE CURB RETURNS SHALL BE CONSTRUCTED WHEREVER A NEW CURB RETURN IS CONSTRUCTED.
- ☐ IF CURB IS DEPRESSED FOR A DRIVEPAD, THE DRIVEPAD SHALL BE CONSTRUCTED PRIOR TO ACCEPTANCE OF CURB AND GUTTER.
- ☐ ALL STORM DRAINAGE FACILITIES SHALL BE COMPLETED PRIOR TO FINAL ACCEPTANCE.

1. ALL CONSTRUCTION SHALL CONFORM TO THE CITY OF ALBUQUERQUE STANDARD SPECIFICATIONS FOR PUBLIC WORKS CONSTRUCTION, 1986 EDITION (UPDATE #5).

2. TWO (2) WORKING DAYS PRIOR TO ANY EXCAVATION, THE CONTRACTOR MUST CONTACT NEW MEXICO ONE CALLS SYSTEM (260-1990) FOR LOCATION OF EXISTING UTILITIES.

3. PRIOR TO CONSTRUCTION, THE CONTRACTOR SHALL EXCAVATE AND VERIFY THE HORIZONTAL AND VERTICAL LOCATIONS OF ALL OBSTRUCTIONS. SHOULD A CONFLICT EXIST, THE CONTRACTOR SHALL NOTIFY THE ENGINEER OR SURVEYOR IMMEDIATELY SO THAT THE CONFLICT CAN BE RESOLVED WITH A MINIMUM AMOUNT OF DELAY.

4. THREE (3) WORKING DAYS PRIOR TO BEGINNING CONSTRUCTION, THE CONTRACTOR SHALL SUBMIT TO CONSTRUCTION COORDINATIONS DIVISION A DETAILED CONSTRUCTION SCHEDULE. TWO (2) WORKING DAYS PRIOR TO CONSTRUCTION, THE CONTRACTOR SHALL OBTAIN A BARRICADING PERMIT FROM THE CONSTRUCTION COORDINATION DIVISION. CONTRACTOR SHALL NOTIFY BARRICADE ENGINEER (768-2551) PRIOR TO OCCUPYING AN INTERSECTION. REFER TO SECTION 19 OF THE GENERAL CONDITIONS OF THE STANDARD SPECIFICATONS.

5. ALL STREET STRIPING ALTERED OR DESTROYED SHALL BE REPLACED IN KIND BY CONTRACTOR TO LOCATION AND IN KIND AS EXISTING OR AS INDICATED BY THIS PLAN SET.

6. CONTRACTOR SHALL NOTIFY THE ENGINEER NOT LESS THAN SEVEN (7) DAYS PRIOR TO STARTING WORK IN ORDER THAT THE ENGINEER MAY TAKE NECESSARY MEASURES TO INSURE THE PRESERVATION OF SURVEY MONUMENTS. CONTRACTOR SHALL NOT DISTURB PERMANENT SURVEY MONUMENTS WITHOUT THE CONSENT OF THE ENGINEER AND SHALL NOTIFY THE ENGINEER AND BEAR THE EXPENSE OF REPLACING ANY THAT MAY BE DISTURBED WITHOUT PERMISSION. REPLACEMENT SHALL BE DONE ONLY BY THE CITY SURVEYOR. WHEN A CHANGE IS MADE IN THE FINISHED ELEVATIONS OF THE PAVEMENT OF ANY ROADWAY IN WHICH A PERMANENT SURVEY MONUMENT IS LOCATED, CONTRACTOR SHALL, AT HIS OWN EXPENSE, ADJUST THE MONUMENT COVER TO THE NEW GRADE UNLESS OTHERWISE SPECIFIED. REFER TO SECTION 4.4 OF THE GENERAL CONDITIONS OF THE STANDARD SPECIFICATIONS.

7. CONTACT WATER SYSTEMS DIVISION (857-8236) THREE (3) WORKING DAYS PRIOR TO NEEDING VALVES SHUT OFF OR TURNED ON. ONLY WATER SYSTEM PERSONNEL ARE TO OPERATE VALVES.

CITY OF ALBUQUERQUE
PUBLIC WORKS DEPARTMENT
ENGINEERING GROUP

TITLE: FIRE HYDRANT INSTALLATION
SIN NOMBRE CT., N.E.

APPROVALS	ENGINEER	DATE	APPROVALS	ENGINEER	DATE
D.R.C. Chairman	B.J. Hadley	6-19-95	WATER	R.W. Kane	6-7-95
Transportation	N/A	6-12-95	WASTE WATER	R.W. Kane	6-7-95
Hydrology	N/A	6/12/95			

DRAWING NO. 5229.90 | MAP NO. D-16 | SHEET 1 OF 1