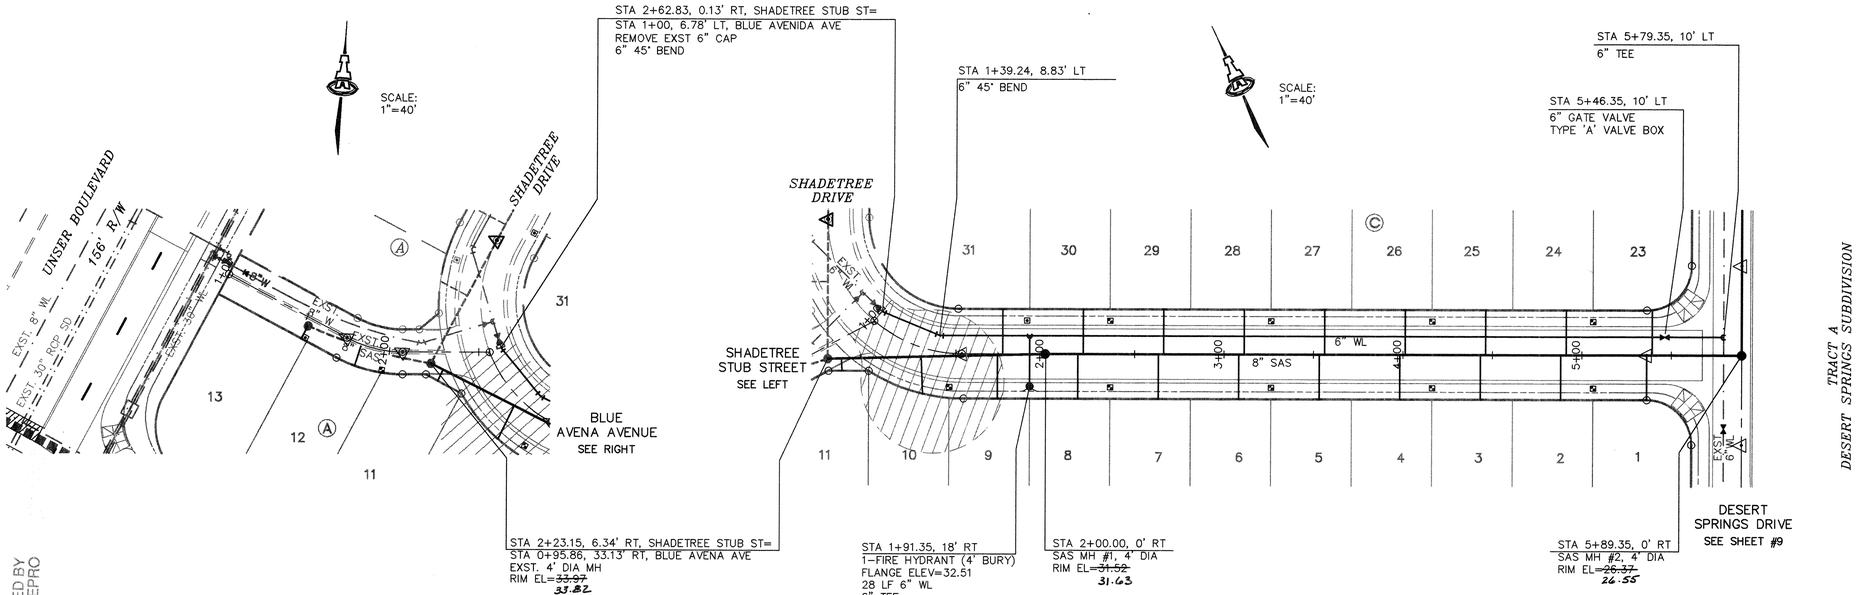

SCANNED BY MESA REPRO

SHADETREE STUB STREET

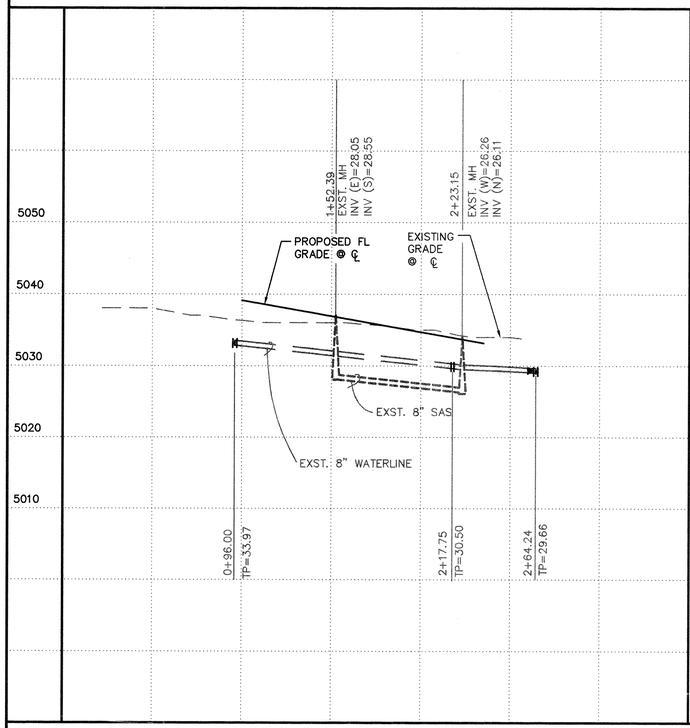

BLUE AVENA AVENUE

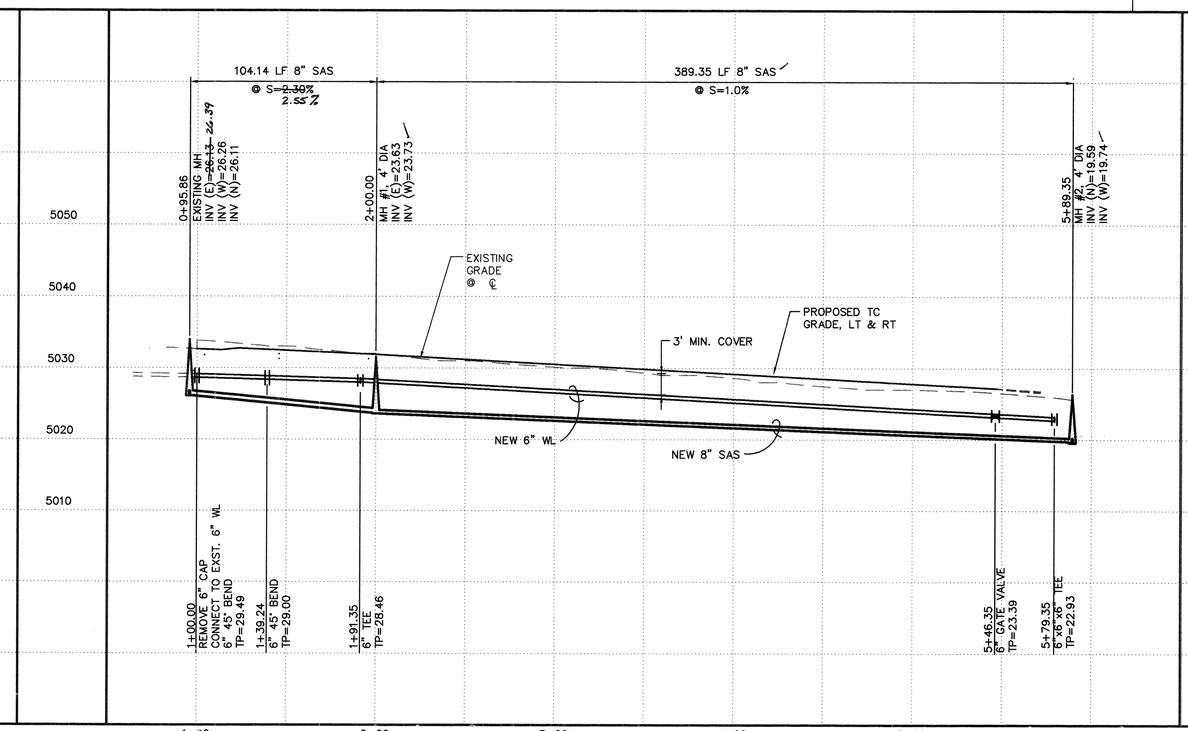

SCALES:
1"=40' HOR.
1"=10' VERT.

GENERAL NOTES

1. CONSTRUCT SAS SERVICES PER COA STD DWG #2125.
2. CONSTRUCT ALL SINGLE & DOUBLE WATER SERVICES PER COA STD DWG #2361, #2362, & #2363.
3. SEE SHEET #10 FOR WATER SHUT-OFF PLAN.
4. SEE SHEET #10 FOR RESTRAINED JOINT LENGTHS FOR WATER LINE FITTINGS.
5. CONSTRUCT FIRE HYDRANTS PER DESIGNATED DEPTHS & LENGTHS PER COA STD DWG #2340.

UTILITY SERVICE TABLE

LOT NO.	STATION WATER, LENGTH	STATION SAS, LENGTH	SAS INV @ R/W
A1	5+06.35, 29'	5+36.35, 25'	22.2
A2		4+88.35, 25'	22.8
A3	4+16.35, 29'	4+43.35, 25'	23.5
A4		3+98.35, 25'	24.1
A5	3+26.35, 29'	3+53.35, 25'	24.7
A6		3+08.35, 25'	25.3
A7	2+36.35, 29'	2+63.35, 25'	25.9
A8		2+18.35, 25'	26.5
A9	1+48.11, 29'	1+73.35, 24'	27.1
A10		1+31.63, 21'	27.5
A11	1+97.28, 13'	2+30.11, 7'	28.4
A12		1+83.79, 11'	30.4
A13	1+55.96, 10' (S)	SAS MH, 8'	31.8
C23	5+06.35, 8'	5+39.35, 25'	22.2
C24		4+91.35, 25'	22.8
C25	4+16.35, 8'	4+46.35, 25'	23.5
C26		4+01.35, 25'	24.1
C27	3+26.35, 8'	3+56.35, 25'	24.7
C28		3+11.35, 25'	25.3
C29	2+36.35, 8'	2+66.35, 25'	25.9
C30		2+21.35, 25'	26.5
C31	1+91.35, 8' (S)	1+76.35, 26'	27.1

ALL WATER SERVICES ARE DOUBLE EXCEPT WHERE NOTED AS (S) SINGLE.

ISAACSON & ARFMAN, P.A.
Consulting Engineering Associates
128 Monroe Street N.E.
Albuquerque New Mexico

9212UTL1.DWGanw 07/24/98

CITY OF ALBUQUERQUE
PUBLIC WORKS DEPARTMENT
ENGINEERING GROUP

TITLE: DESERT SPRINGS SUBDIVISION, UNIT TWO
BLUE AVENA AVENUE & SHADETREE STUB STREET
UTILITY PLAN & PROFILE

Design Review Committee: APPROVED DESIGN REVIEW COMMITTEE
City Engineer Approval
Last Design Update: Mo./Day/Yr. Mo./Day/Yr.

City Project No. 5785.82 | Zone Map No. M-10 | Sheet 12 Of 15

AS-BUILT INFORMATION
CONTRACTOR Spacing 3 DATE 3/00
WORK STAKED BY Spacing 3 DATE 8/00
INSPECTOR'S ACCEPTANCE BY RAA DATE 8/00
AS-BUILTS VERIFICATION BY Spacing DATE 8/00
AS-BUILTS CORRECTED BY IRA DATE 8/00
MICRO-FILM INFORMATION
RECORDED BY DATE
NO.

BENCH MARKS
ACS MONUMENT "1-M10" LOCATED AT THE SOUTHEAST CORNER OF SAGE RD. & UNSER BLVD.
ELEV. = 5079.88
TBM: RIM OF SOUTHWESTERLY MANHOLE AT SAPPHIRE ST. & UNSER BLVD.
ELEV. = 5035.84

SURVEY INFORMATION
FIELD NOTES
1 ALS 1/97

ENGINEER'S SEAL
FRED C. ARFMAN STATE OF NEW MEXICO 7322 REGISTERED PROFESSIONAL ENGINEER
07/24/98

NO.	DATE	REMARKS	BY
1	05/98	REVISIONS DESIGN	MJC

DESIGNED BY MJC DATE 05/98
DRAWN BY EMS DATE 05/98
CHECKED BY FCA DATE 05/98