SCANNED BY
MESA REPRO

TRACT A-UNIT B
NORTH ALBUQUERQUE ACRES

ALBUQUERQUE - BERNALILLO COUNTY - NEW MEXICO

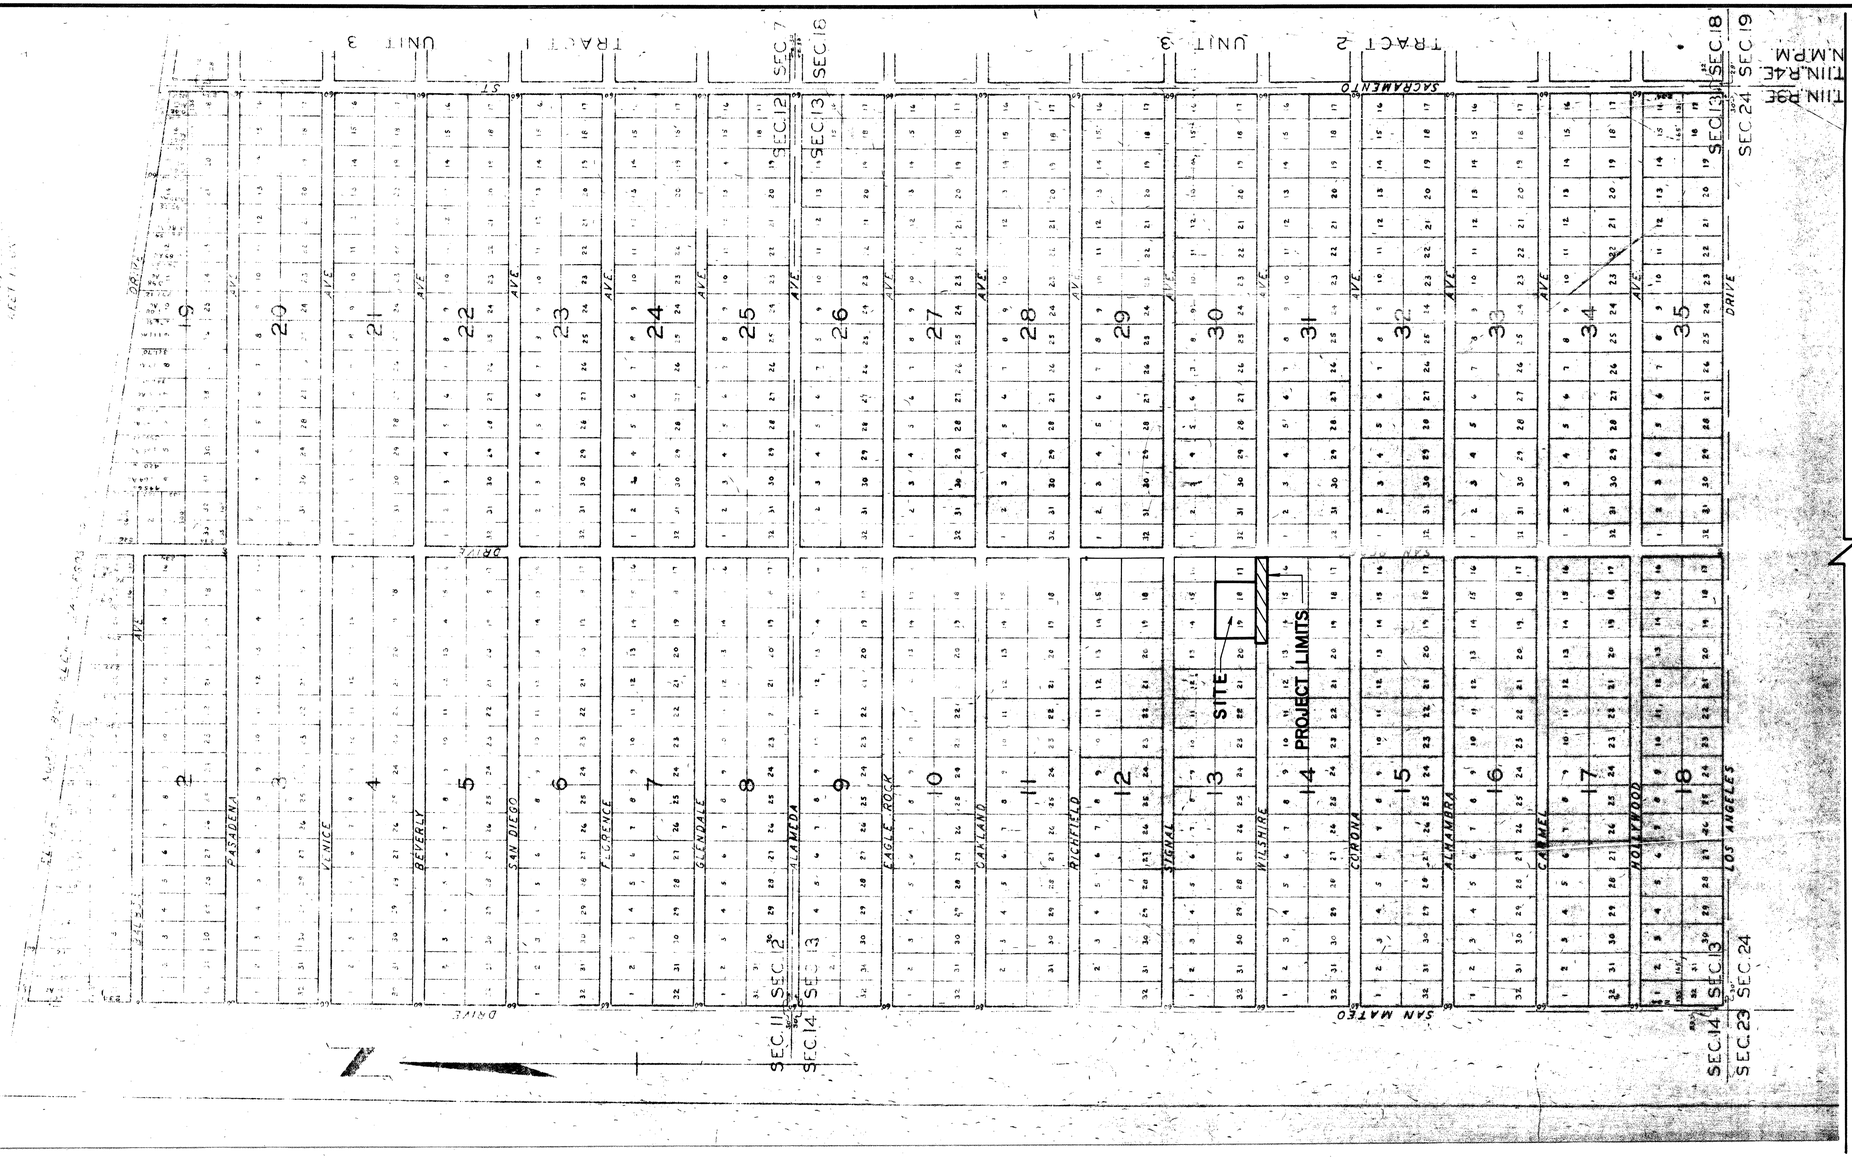

MATCH LINE; FOR CONTINUATION, SEE BELOW

D-130

MATCH LINE; FOR CONTINUATION, SEE ABOVE

The above and foregoing subdivision of that certain tract of land in School District No.3, Bernalillo County, New Mexico, within the Elena Gallegos Grant, being all that portion of Section 18 lying South of the North boundary of said Grant, and all of Section 19, in Township 11 North, Range 5 East, N.M.P.M. (as said Sections are defined by projection of existing public survey lines), surveyed, platted and subdivided as hereon shown, comprising Blocks 1 to 35, inclusive, of TRACT A UNIT B, NORTH ALBUQUERQUE ACRES, is with the free consent and in accordance with the desire of the undersigned owner and proprietor thereof.

MORING REALTY COMPANY, INC. Owner and Proprietor.

Attest: _____ Secretary. by _____ President.

State of California,
County of Los Angeles, } SS.

On this _____ day of April, 1936, before me, a Notary Public in and for said County, personally appeared M.Moring and J.A.Dewey, both to me personally known, who being duly sworn by me according to Law, did say that they are the President and Secretary, respectively, of the Moring Realty Company, Inc., and that the seal affixed to the foregoing instrument is the corporate seal of said corporation, and that said instrument was signed and said seal affixed thereto in behalf of said corporation by authority of its Board of Directors; and said M.Moring did acknowledge said instrument to be the free act and deed of said corporation.

In Witness whereof I have hereunto set my hand and seal the day and date last above written.

_____ Notary Public.

My commission expires _____

I, Edmund Ross, County Surveyor of Bernalillo County, New Mexico, hereby certify that I have examined the plat of Tract A Unit B, North Albuquerque Acres, upon which this certificate appears, and have approved the same this 21st. day of April, 1936.

Edmund Ross County Surveyor.

I GLADYS M. DAVIS, County Clerk of Bernalillo County, New Mexico, do hereby certify that the map on which this certificate appears is a true copy, made under my direction and under the provisions of Chapter 130 of New Mexico Sessions Laws 1939, of a map filed for record on the 24th day of Apr, 1936.

GLADYS M. DAVIS
County Clerk, Bernalillo County
New Mexico

RECORD DRAWING

NO.	DATE	REMARKS	BY
1	06/01	RECORDED DRAWING	MDS

Revisions
DESIGN

Designed By	J.G.M.	Date 01-0001
Drawn By	S.G.H.	Date 01-0001
Checked By	J.G.M.	Date 01-0001

SURVEY INFORMATION
FIELD NOTES
NO. BY DATE

BENCH MARKS

ENGINEER'S SEAL
N/A

AS BUILT INFORMATION
CONTRACTOR
WORK STAKED BY
INSPECTOR'S ACCEPTANCE BY
FIELD VERIFICATION BY
RED LINES CORRECTED BY
MICRO-FILM INFORMATION
RECORDED BY
NO.
DATE

jmra
JEFF MORTENSEN & ASSOCIATES, INC.
6010-B MIDWAY PARK BLVD. N.E.
ALBUQUERQUE NEW MEXICO 87109
ENGINEERS SURVEYORS (505) 345-4250
FAX: 505 345-4254 Email: jmainc@swcp.com
2001.005.R2

CITY OF ALBUQUERQUE
PUBLIC WORKS DEPARTMENT
ENGINEERING DEVELOPMENT GROUP

TITLE: 5801 & 5901 WILSHIRE N.E.
WATER LINE EXTENSION
PLAT OF RECORD

Design Review Committee: APPROVED MAR 2 2 2001 DESIGN REVIEW COMMITTEE
City Engineer Approval
Last Design Update Mo./Day/Yr. Mo./Day/Yr.

City Project No. 659081 | Zone Map No. C-18 | Sheet 2 Of 6

File Path: E:\JMA\WORK\001\005\1
File Name: 10051PL.DWG
Plot Date: 01-30-2001
Plot Time: 11:29 am