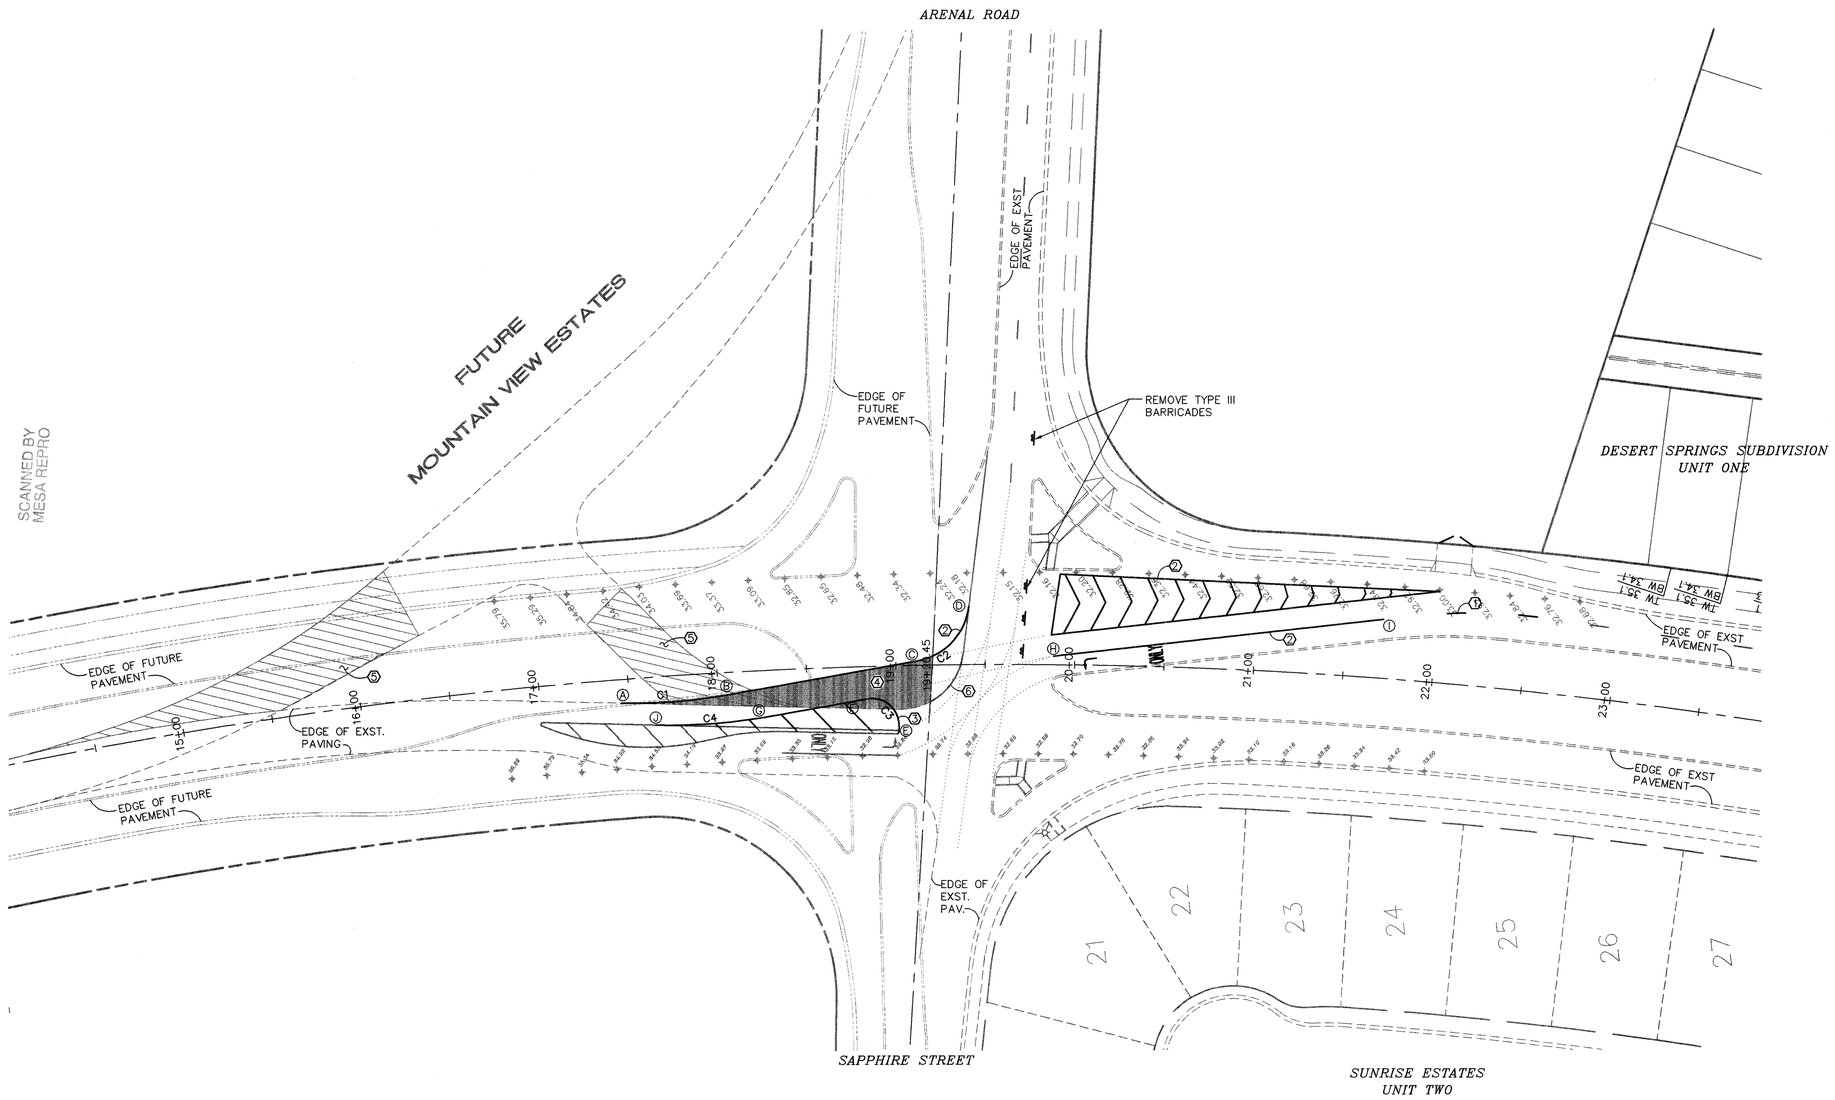

UNSER BLVD. STRIPING PLAN

SCALE: 1"=40'

NOTE:
THIS AREA MAY HAVE CHANGED IN THE FIELD PRIOR TO CONSTRUCTION. CONTACT THE ENGINEER & COA TRANSPORTATION DESIGN FOR A FIELD MEETING TO VERIFY SIGNING & TRAFFIC CONTROL REQUIREMENTS.

KEYED CONSTRUCTION NOTES

1. TEMPORARY DASHED 4" WHITE PLASTIC REFLECTORIZED PAVEMENT STRIPING PER MUTCD. 10' STRIPE W/30' GAP BETWEEN STRIPES.
2. TEMPORARY SOLID 4" WHITE PLASTIC REFLECTORIZED PAVEMENT STRIPING PER MUTCD.
3. TEMPORARY SOLID 4" YELLOW PLASTIC REFLECTORIZED PAVEMENT STRIPING PER MUTCD.
4. CONSTRUCT 231 SY 4" TEMPORARY ASPHALT PAVING.
5. PREVIOUSLY REMOVED PAVING.
6. REMOVE AND DISPOSE EXISTING STRIPING FROM Ⓐ STA 17+45.20, 13.18' RT TO Ⓓ STA 19+41.00, 32.38' LT

CURVE TABLE

C1 R = 300.00'
L = 59.57'
Δ = 11°22'40"

C2 R = 35.00'
L = 44.64'
Δ = 73°05'02"

C3 R = 15.00'
L = 26.54'
Δ = 101°22'40"

C4 R = 312.00'
L = 61.96'
Δ = 11°22'40"

STATION TABLE

Ⓐ 17+45.20, 13.18' RT
Ⓑ 18+04.95, 12.58' RT
Ⓒ 19+12.20, 2.43' LT
Ⓓ 19+41.00, 32.38' LT
Ⓔ 19+01.13, 33.68' RT
Ⓕ 18+83.72, 18.15' RT
Ⓖ 18+26.81, 25.99' RT
Ⓗ 19+88.21, 4.77' LT
Ⓘ 21+70.41, 33.01' LT
Ⓙ 17+64.37, 27.08' RT

NOTE:
THIS STRIPING PLAN SHOULD NOT BE USED IF THE NORTHEAST QUADRANT OF THE ARENAL/UNSER INTERSECTION HAS BEEN CONSTRUCTED.

AS-BUILT INFORMATION
CONTRACTOR Sparling DATE 8/00
WORK STAKED BY Sparling DATE 8/00
INSPECTOR'S ACCEPTANCE BY [illegible] DATE 8/00
FIELD VERIFICATION BY Sparling DATE 8/00
DRAWINGS CORRECTED BY [illegible] DATE 8/00
MICRO-FILM INFORMATION
RECORDED BY DATE
NO.

BENCH MARKS
ACS MONUMENT "1-M10" LOCATED AT THE SOUTHEAST CORNER OF SAGE RD. & UNSER BLVD.
ELEV. = 5079.88
TBM: RIM OF SOUTHWESTERLY MANHOLE AT SAPPHIRE ST. & UNSER BLVD.
ELEV. = 5035.84

SURVEY INFORMATION
FIELD NOTES
1 ALS 1/97

ENGINEER'S SEAL
FRED C. ARFMAN STATE OF NEW MEXICO 7322 REGISTERED PROFESSIONAL ENGINEER

NO.	DATE	REMARKS	BY

REVISIONS

DESIGN		DATE
DESIGNED BY	MJC	05/98
DRAWN BY	EMS	05/98
CHECKED BY	FCA	05/98

ISAACSON & ARFMAN, P.A.
Consulting Engineering Associates
128 Monroe Street N.E.
Albuquerque New Mexico
9212STRP.DWGems 07/24/98

CITY OF ALBUQUERQUE
PUBLIC WORKS DEPARTMENT
ENGINEERING GROUP

TITLE: DESERT SPRINGS SUBDIVISION, UNIT TWO
UNSER BOULEVARD
STRIPING PLAN

Design Review Committee: APPROVED DESIGN REVIEW COMMITTEE
City Engineer Approval
Last Design Update | Mo./Day/Yr. | Mo./Day/Yr.

City Project No. 5785.82 | Zone Map No. M-10 | Sheet 13 Of 15