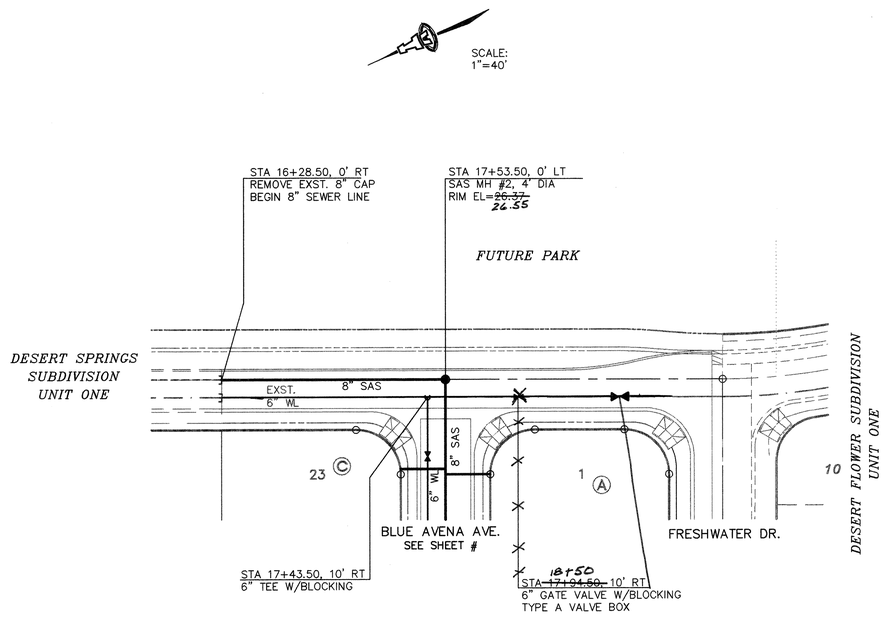

SCANNED BY
MESA REPRO

DESERT SPRINGS DR.

SCALES:
1"=40' HOR.
1"=10' VERT.

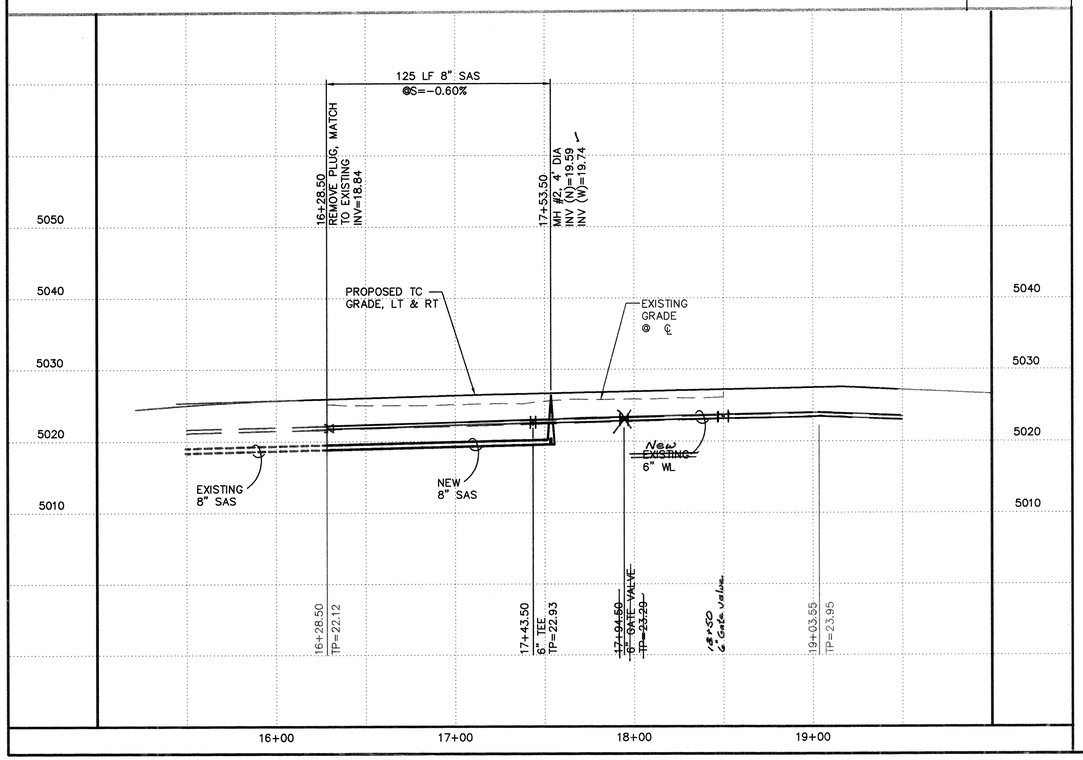

GENERAL NOTES

1. CONSTRUCT SAS SERVICES PER COA STD DWG #2125.
2. CONSTRUCT ALL SINGLE & DOUBLE WATER SERVICES PER COA STD DWG #2361, #2362, & #2363.
3. SEE SHEET #10 FOR WATER SHUT-OFF PLAN.
4. SEE SHEET #10 FOR RESTRAINED JOINT LENGTHS FOR WATER LINE FITTINGS.
5. CONSTRUCT FIRE HYDRANTS PER DESIGNATED DEPTHS & LENGTHS PER COA STD DWG #2340.

AS-BUILT INFORMATION

CONTRACTOR	Spacline	DATE 8/00
WORK STAKED BY	Spacline	DATE 8/00
INSPECTOR'S ACCEPTANCE BY	TAK	DATE 8/00
FIELD VERIFICATION BY	Spacline	DATE 8/00
DRAWINGS CORRECTED BY	TAK	DATE 8/00

MICRO-FILM INFORMATION

RECORDED BY	
DATE	
NO.	

City Inspector: R. Baca

BENCH MARKS

ACS MONUMENT "1-M10" LOCATED AT THE SOUTHEAST CORNER OF SAGE RD. & UNSER BLVD.
ELEV. = 5079.88

TBM: RIM OF SOUTHWESTERLY MANHOLE AT SAPPHIRE ST. & UNSER BLVD.
ELEV. = 5035.84

SURVEY INFORMATION

	FIELD NOTES	
1	ALS	1/97

ENGINEER'S SEAL

FRED C. ARFMAN
STATE OF NEW MEXICO
7322
REGISTERED PROFESSIONAL ENGINEER
07-24-98

NO.	DATE	REMARKS	BY

REVISIONS

DESIGN		
DESIGNED BY	MJC	DATE 05/98
DRAWN BY	EMS	DATE 05/98
CHECKED BY	FCA	DATE 05/98

ISAACSON & ARFMAN, P.A.
Consulting Engineering Associates
128 Monroe Street N.E.
Albuquerque New Mexico
9212UTL3.DWGanw 07/24/98

CITY OF ALBUQUERQUE
PUBLIC WORKS DEPARTMENT
ENGINEERING GROUP

TITLE: DESERT SPRINGS SUBDIVISION, UNIT TWO
DESERT SPRINGS DR.
UTILITY PLAN & PROFILE

Design Review Committee | City Engineer Approval | Last Design Update | Mo./Day/Yr. | Mo./Day/Yr.

DESIGN REVIEW COMMITTEE

City Project No. 5785.82 | Zone Map No. M-10 | Sheet 11 Of 15