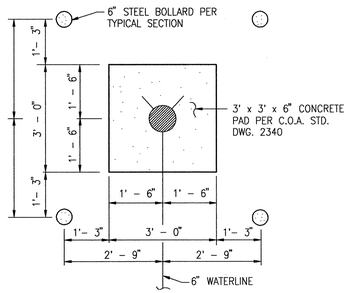

FIRE HYDRANT BOLLARD DETAIL

SCALE: 1" = 2' - 0"

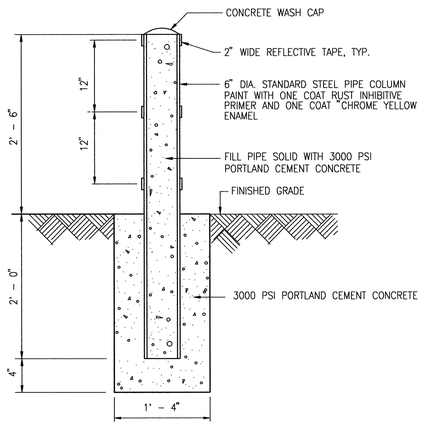

TYPICAL BOLLARD SECTION

SCALE: 1" = 1' - 0"

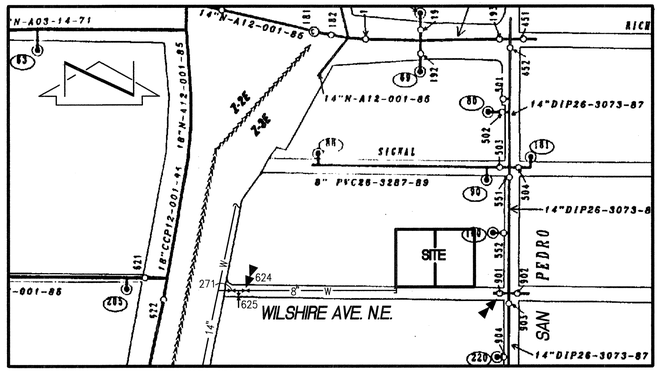

WATER VALVE SHUTOFF PLAN

SCALE: 1" = 300'±

C-18

WATER VALVE SHUTOFF PLAN/NOTES:

1. AS A MINIMUM, THE FOLLOWING VALVES SHALL BE CLOSED TO FACILITATE THE PROPOSED CONNECTIONS:
   A. WILSHIRE AVE. N.E. @ STA 17+09
      VALVE: 624
   B. WILSHIRE AVE. N.E. @ STA 21+50
      VALVE: 901
2. THE CONTRACTOR SHALL NOTIFY WATER SYSTEMS THREE (3) WORKING DAYS IN ADVANCE OF ANY WORK THAT MAY AFFECT EXISTING WATER LINES: ALL SHUTOFFS SHALL BE PERFORMED BY THE WATER SYSTEM DIVISION PERSONNEL (857-8200)
3. THE CONTRACTOR SHALL PROVIDE ALL RESTRAINTS AND THRUST BLOCKS NECESSARY TO EFFECT ALL NECESSARY SHUTOFFS AND CONNECTIONS.
4. EXISTING WATER VALVE AND WATER LINE INFORMATION OBTAINED FROM THE CITY OF ALBUQUERQUE AUTOMATED WATER DISTRIBUTION SYSTEM SECTIONAL MAPS, PLATE C-18 AND CITY PROJECT NO. 570481 AS-BUILTS.
5. COULD NOT FIELD LOCATE VALVE NO. 903 ON EXISTING 14" D.I.P. IN SAN PEDRO SOUTH OF CROSS AND VALVES 901 AND 902.
6. EXISTING WATER LINE MATERIALS BASED UPON RECORD DATA; ACTUAL PIPE MATERIALS MAY VARY, THEREFORE CONTRACTOR SHALL VERIFY PRIOR TO ORDERING FITTINGS, ETC.

⚠ **RECORD DRAWING**

AS BUILT INFORMATION
CONTRACTOR Hydro Systems Inc.
WORK STAKED BY — DATE
INSPECTOR'S ACCEPTANCE BY M.D.S. Ron Rutledge DATE 03/01
FIELD VERIFICATION BY M.D.S. DATE 03/01
DRAWINGS CORRECTED BY J.M.A. DATE 03/01
MICRO-FILM INFORMATION
RECORDED BY — DATE
NO.

BENCH MARKS

SURVEY INFORMATION
FIELD NOTES

NO.	BY	DATE

ENGINEER'S SEAL
06-26-2001
JEFFREY G. MORTENSEN NEW MEXICO 8547 REGISTERED PROFESSIONAL ENGINEER
03-07-2001

NO.	DATE	REMARKS	BY
⚠	03/01	RECORD DRAWING	MDS

Revisions

DESIGN

		Date
Designed By	J.G.M.	03-0001
Drawn By	S.G.H.	03-0001
Checked By	J.G.M.	03-0001

JEFF MORTENSEN & ASSOCIATES, INC.
6010-B MIDWAY PARK BLVD. N.E.
ALBUQUERQUE NEW MEXICO 87109
ENGINEERS SURVEYORS (505) 345-4250
FAX: 505 345-4254 Email: jmainc@swcp.com

2001.005.12

CITY OF ALBUQUERQUE
PUBLIC WORKS DEPARTMENT
ENGINEERING DEVELOPMENT GROUP

TITLE: 5801 & 5901 WILSHIRE N.E.
WATER LINE EXTENSION
WATER VALVE SHUTOFF PLAN; SECTIONS AND DETAILS

Design Review Committee: APPROVED MAR 2 2 2001 DESIGN REVIEW COMMITTEE

City Engineer Approval

Last design update — Mo./Day/Yr. — Mo./Day/Yr.

City Project No. 659081 | Zone Map No. C-18 | Sheet 4 Of 6

File Path: F:\MYWORK\2001\005\
File Name: 100511WV.DWG
Plot Date: 03-07-2001
Plot Time: 2:38 pm

SCANNED BY MESA REPRO