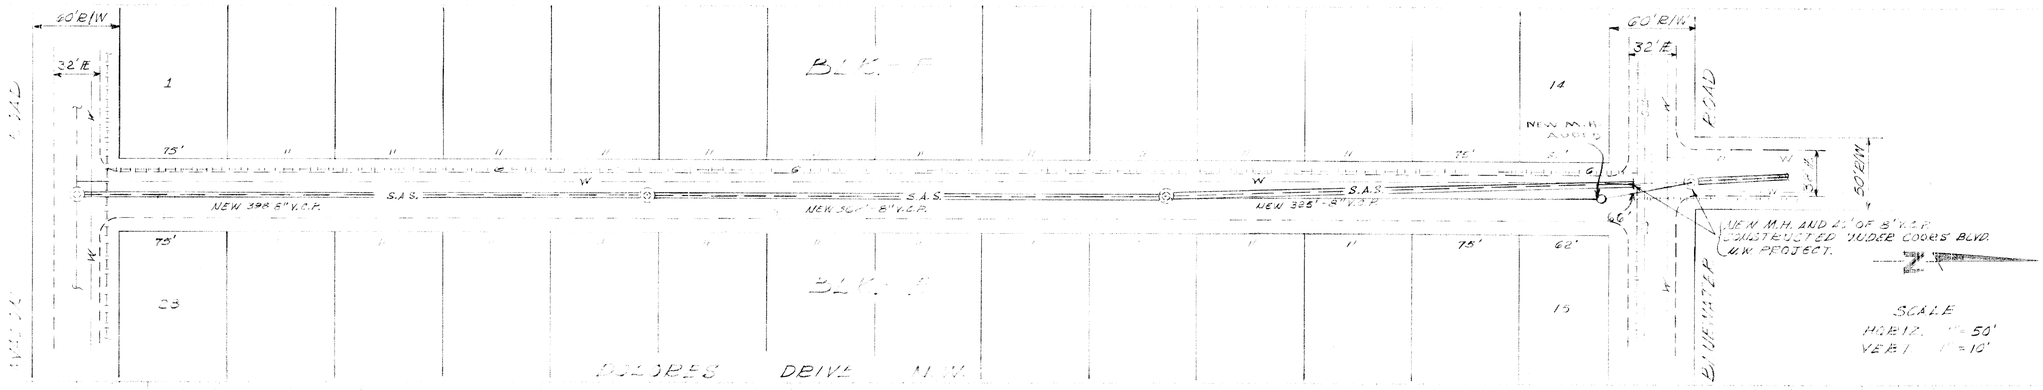

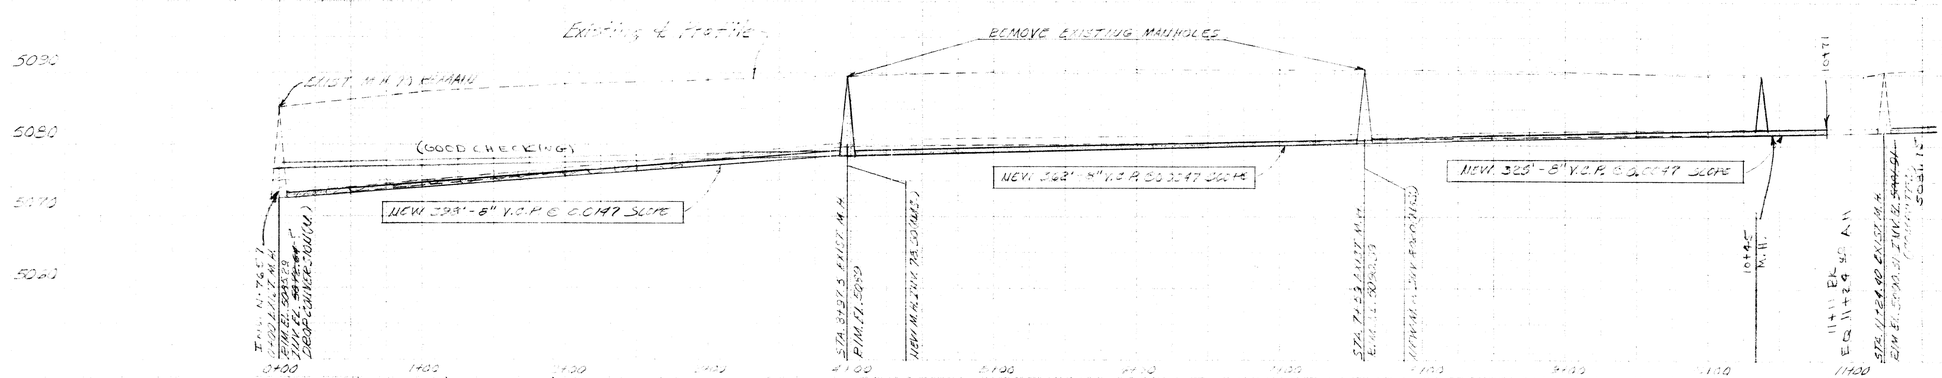

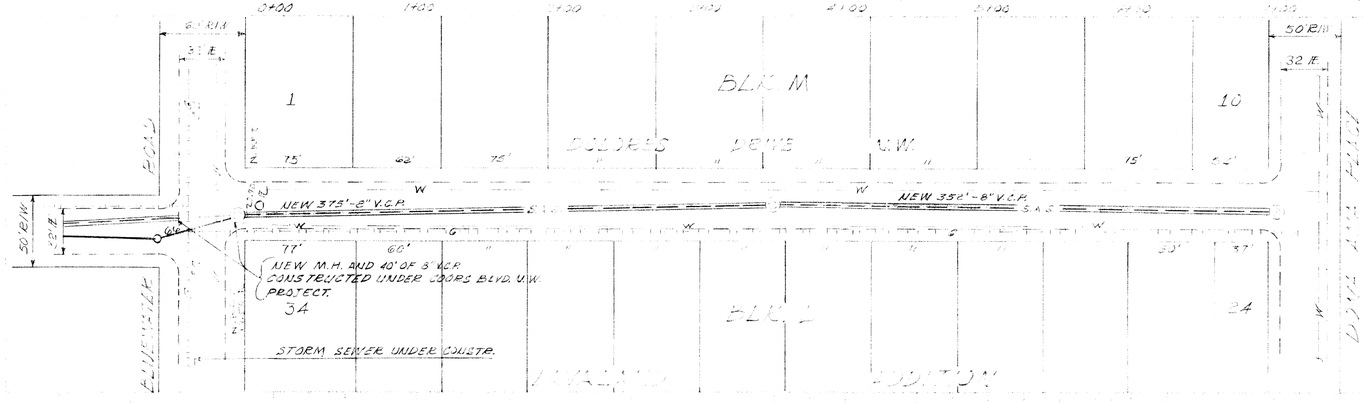

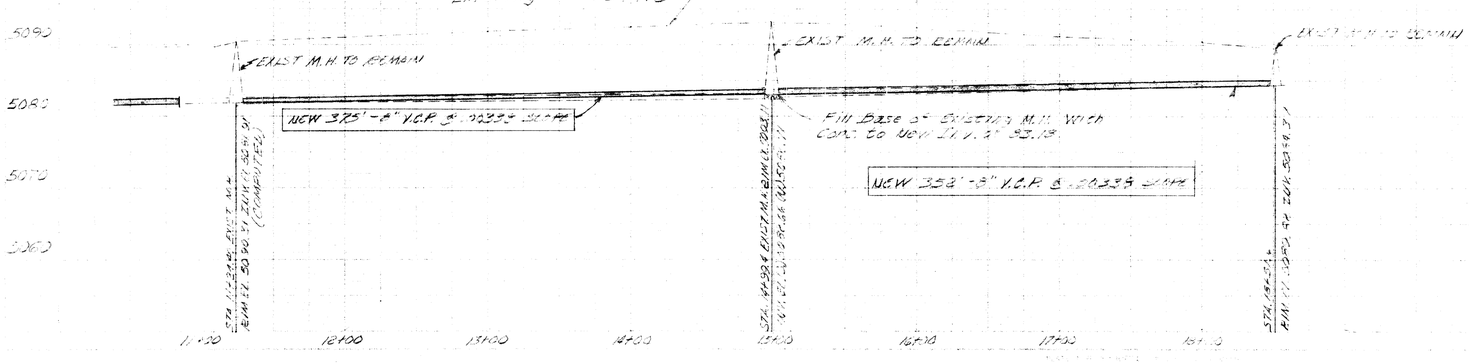

SCALE
HORIZ. 1" = 50'
VERT. 1" = 10'

Note: New M.H. Built @ Sta. 11+44.4 Under Coors Bl. N.W. Project. At Time Of City Survey, M.H. Was Plugged With Conc. So No Invert Elev. Could Be Obtained. Inv. Elev. Shown Is Computed.

LEGEND

- PROPOSED SAN. SEWER LINE REPLACEMENT
- S.A.S. — EXIST. SAN. SEWER LINE
- S.S. — EXIST. 12" SEWER LINE
- W — EXIST. WATER LINE
- G — EXIST. GAS LINE

B.M.-X On N. END N.E. C.B. Bluewater & Coors Elev. 5090.69

21 059 0175 05 58112

"AS STAKED"

NO.	DATE	REVISIONS	RECORDED BY

CITY OF ALBUQUERQUE
PUBLIC WORKS DEPARTMENT
ENGINEERING DIVISION

TITLE SAN. SEWER REPLACEMENT ON COORS AND ADDITION ON COORES DR. N.W. TO AVOID PD.M.W. TO BLUE WATER PLACE N.W.

DESIGNED BY	DRAWN BY	AS BUILT
TITLE	TITLE	SUBMITTED BY
DATE	DATE	TITLE
APPROVED		DATE
ASS'T CITY ENGINEER		REVIEWED BY
DATE		TITLE
WATER ENGINEER		DATE
DATE	DATE	SHEET NO. 1 OF 1 SHEETS
DRAWING NUMBER	S.A.S.-53-15	