OK 12/1/03 plans 1/16/04 EDS

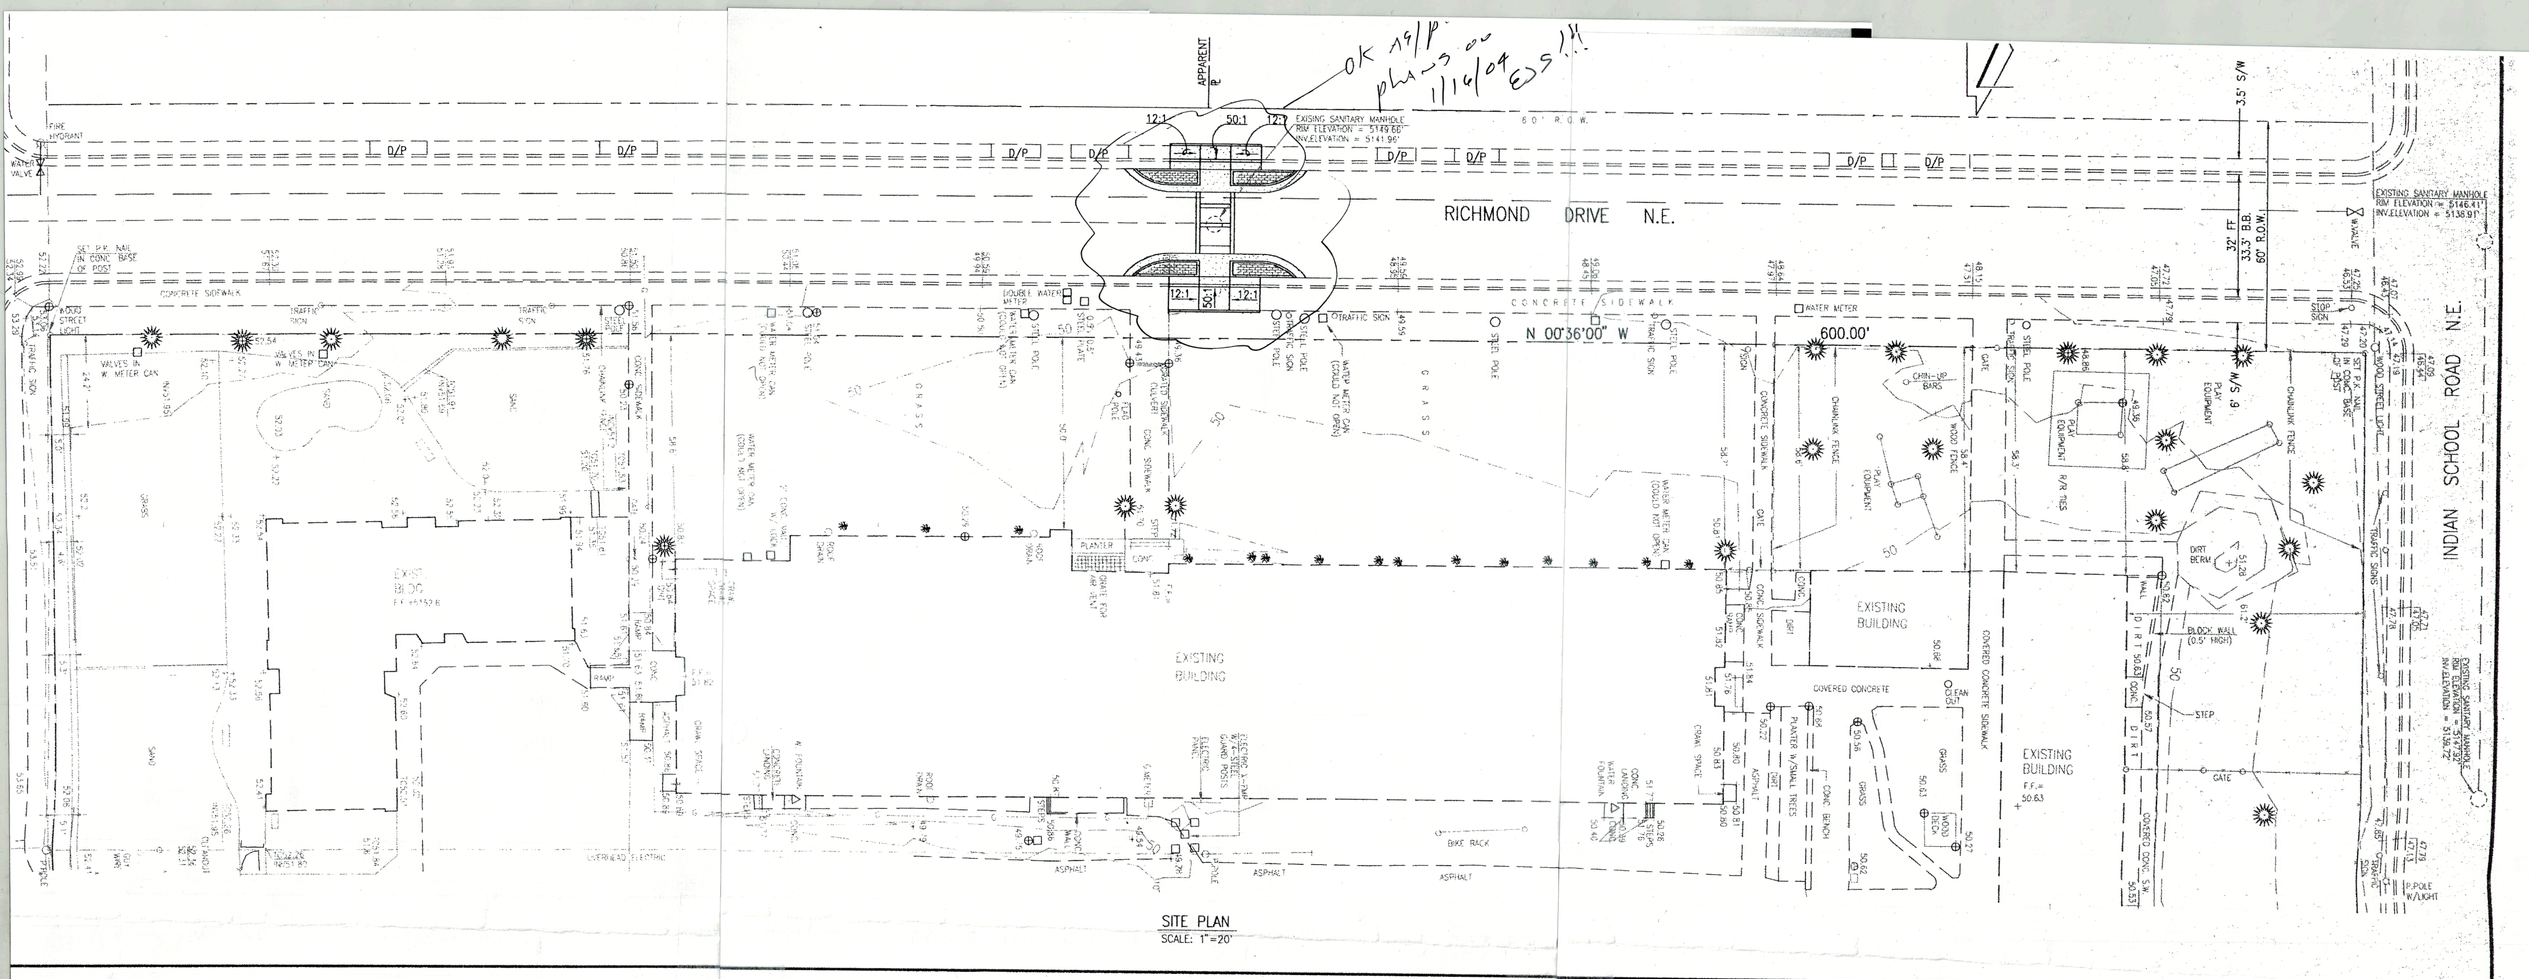

SITE PLAN
SCALE: 1"=20'

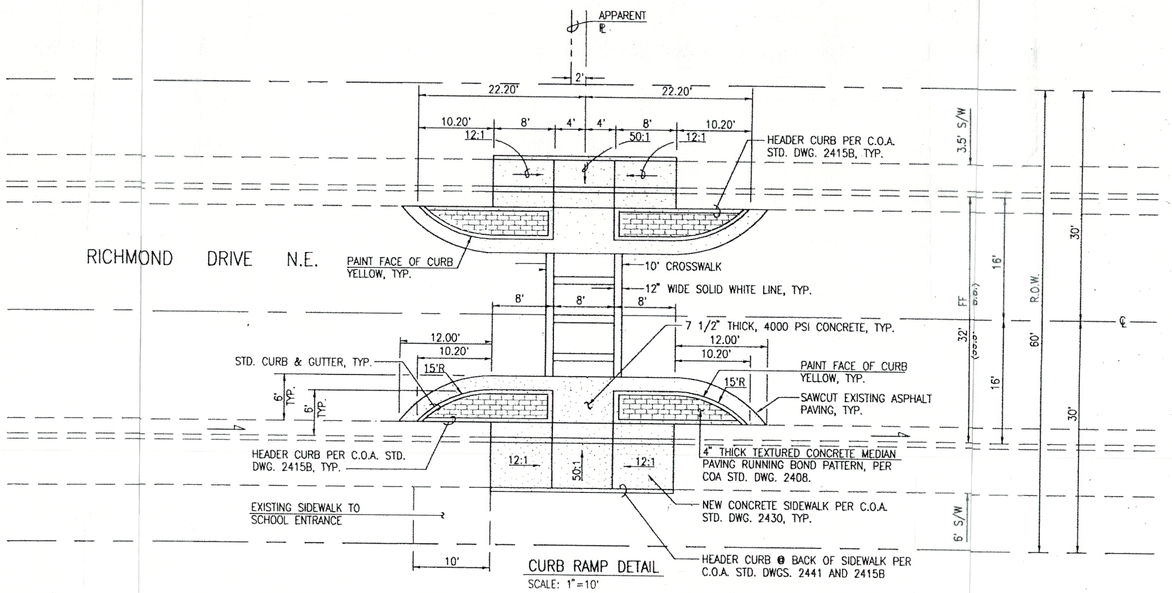

CURB RAMP DETAIL
SCALE: 1"=10'

W.O. 7150.12
Montezuma Sidewalk Improvements 12-18-2003

JEFFREY G. MORTENSEN NEW MEXICO 8547 REGISTERED PROFESSIONAL ENGINEER

JEFF MORTENSEN & ASSOCIATES, INC.
6010-B MIDWAY PARK BLVD. N.E.
ALBUQUERQUE NEW MEXICO 87109
ENGINEERS SURVEYORS (505) 345-4250
FAX: 505 345-4254 Email: jmainc@swcp.com

RICHMOND DRIVE N.E. CROSSWALK
MONTEZUMA ELEMENTARY SCHOOL

DESIGNED BY J.G.M.
DRAWN BY J.L.P.
APPROVED BY J.G.M.

NO.	DATE	BY	REVISIONS

JOB NO. 2003.182.7
DATE 12-2003
SHEET 1 OF 1