




PNC 2003-1
7150.15
TLC

LEGAL DESCRIPTION
T 11 N
R 3 E
SEC 32
MAGEE MAP 22

UNIFORM PROPERTY CODE
1-014-061

114P ATTENDED THROUGH
MAY 1988

F-14-Z
PLANNING DEPARTMENT

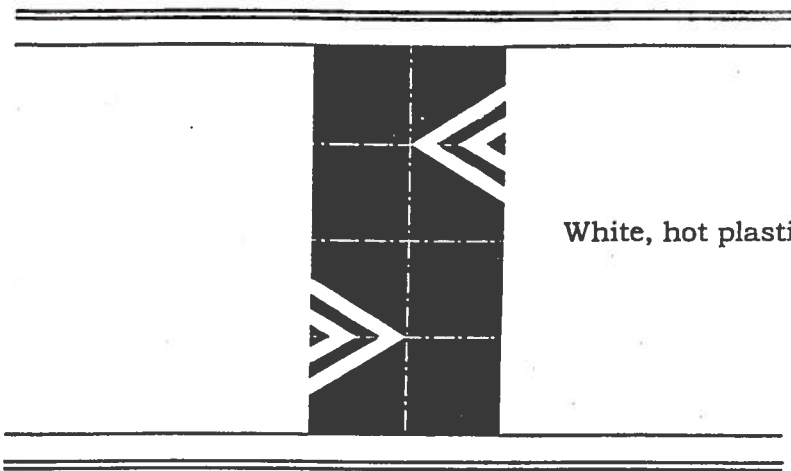

White, hot plastic markings

MARKING PLAN

Not To Scale




E-14



Install Type A speed humps

Install "SPEED HUMPS" signs as shown

SPEED HUMP PROFILE

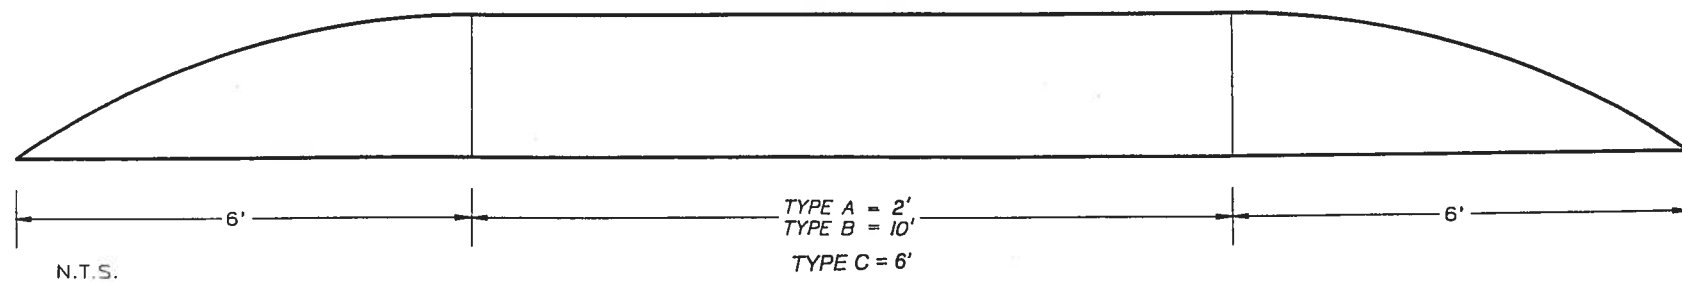

APPROACH DETAIL

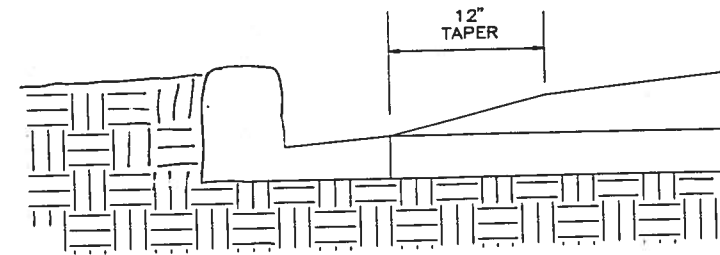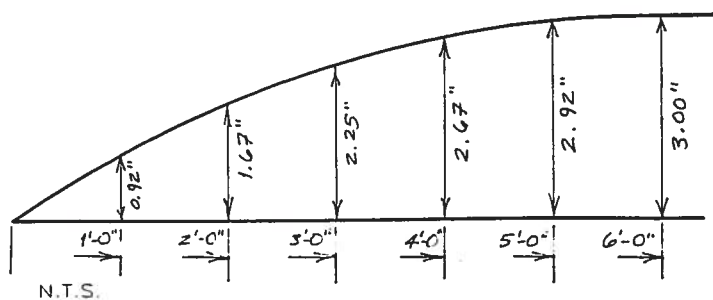

N.T.S. CURB TREATMENT




City of Albuquerque

P. O. BOX 1293 ALBUQUERQUE, NEW MEXICO 87103
PUBLIC WORKS DEPARTMENT - TRAFFIC ENGINEERING DIVISION


7150.15
5th Street NW

Palo Duro to Delamar
Speed Hump Installation

Approved By: Ronald E. Hassett
Date: 2-12-04

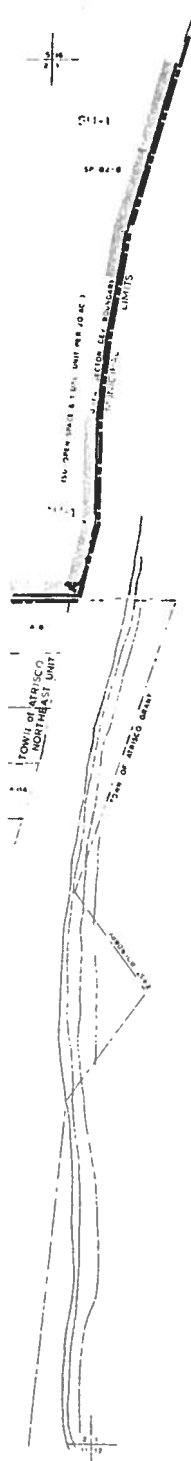

RIO GRANDE

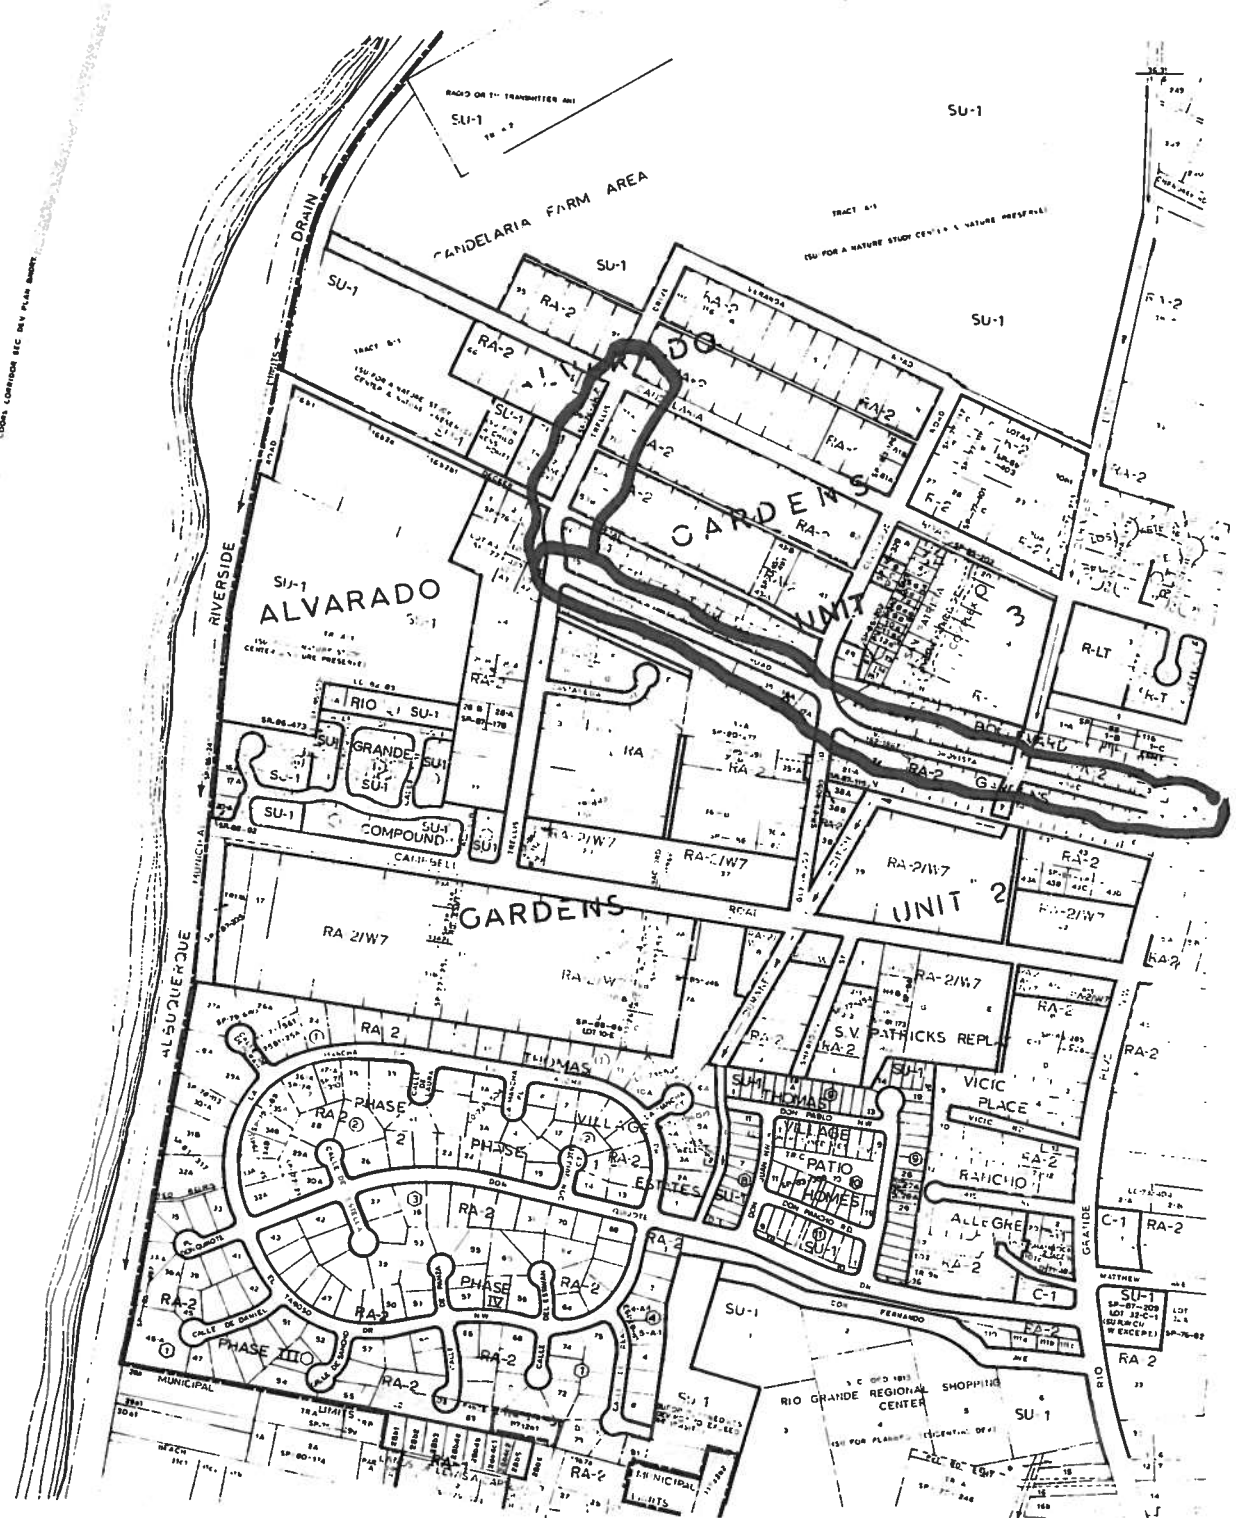


PWC 2003-1
7150.15
TLC

SYMBOL	DESCRIPTION
(Symbol)	1 TO 4
(Symbol)	5 TO 8
(Symbol)	9 TO 12

APPROVED FOR THE
CITY OF ALBUQUERQUE
MAY 1988

G-12-Z
CITY OF ALBUQUERQUE
PLANNING DEPARTMENT

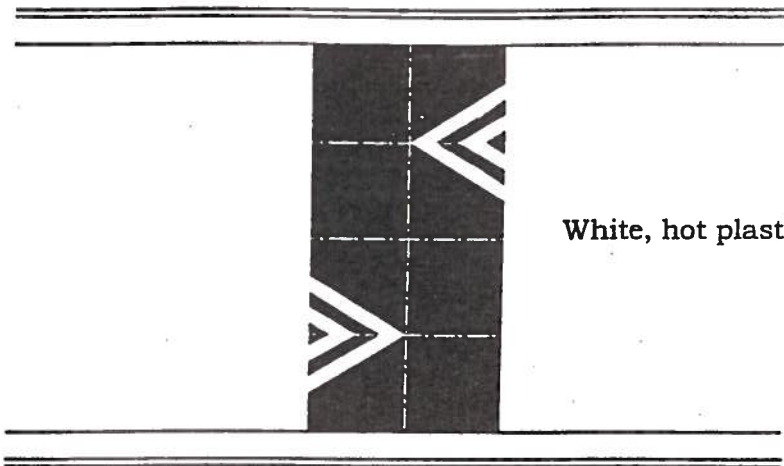

MARKING PLAN

Not To Scale




Install Type A speed humps

Install "SPEED HUMPS" signs as shown



G-12

INSTALL HUMP AND OR SIGN
FIELD VISIT 5/9/06 R. GUTIERREZ

SPEED HUMP PROFILE

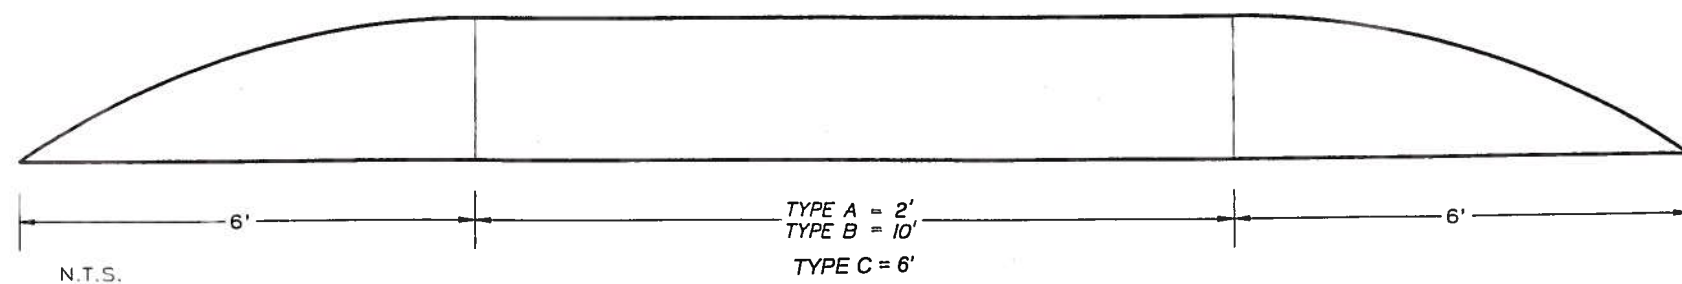

APPROACH DETAIL

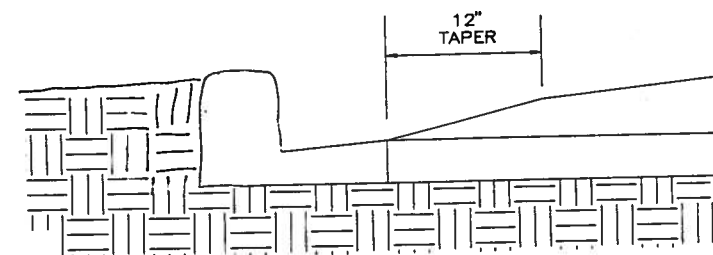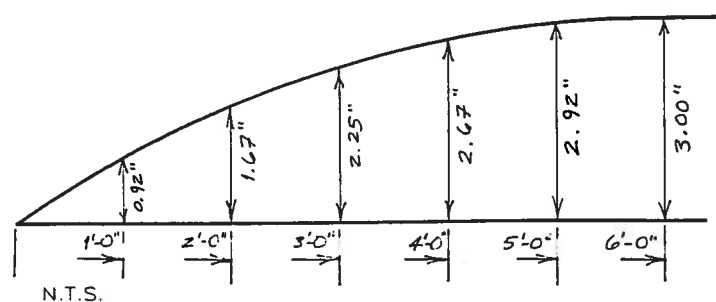

N.T.S. CURB TREATMENT



⁷³⁸⁹³¹⁰
City of Albuquerque

P. O. BOX 1293 ALBUQUERQUE, NEW MEXICO 87103
PUBLIC WORKS DEPARTMENT - TRAFFIC ENGINEERING DIVISION



^{7150.15}

Trellis Dr NW

Oro Vista Rd NW

Speed Hump Installation

Approved By: Ronald E. Hassett
Date: 2-12-04

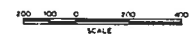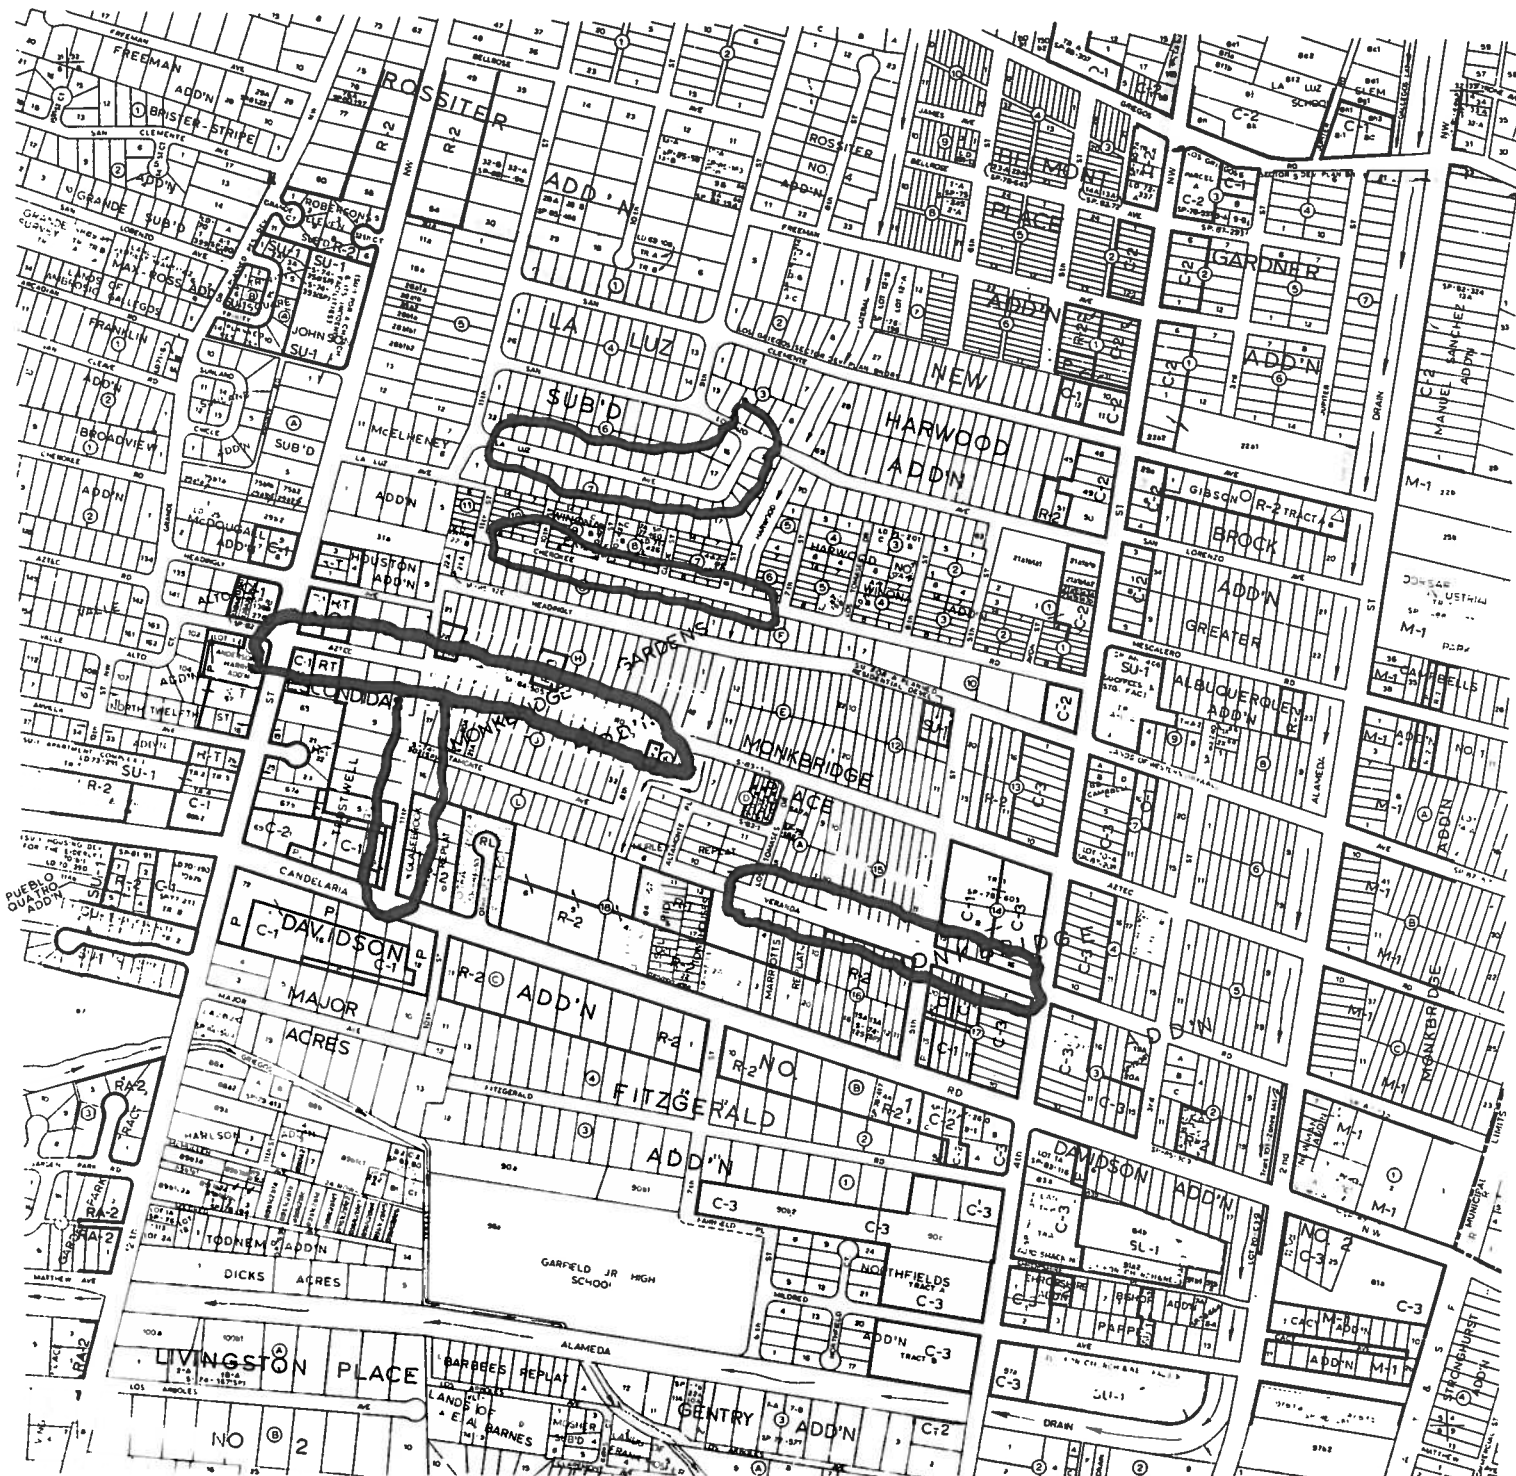


PWC 2003-1
7150.15
TLC

LEGAL DESCRIPTION
T 10 N
R 3 E
SEC 5
PART OF TRACT 33

UNIFORM PROPERTY CODE
1-14-060


MAP AMENDED THROUGH
MAY 1988

G-14-Z
CITY OF ALBUQUERQUE
PLANNING DEPARTMENT

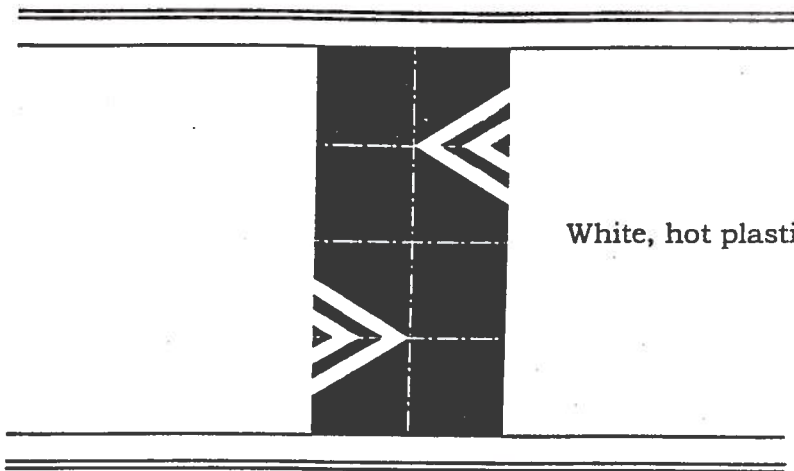

MARKING PLAN

Not To Scale

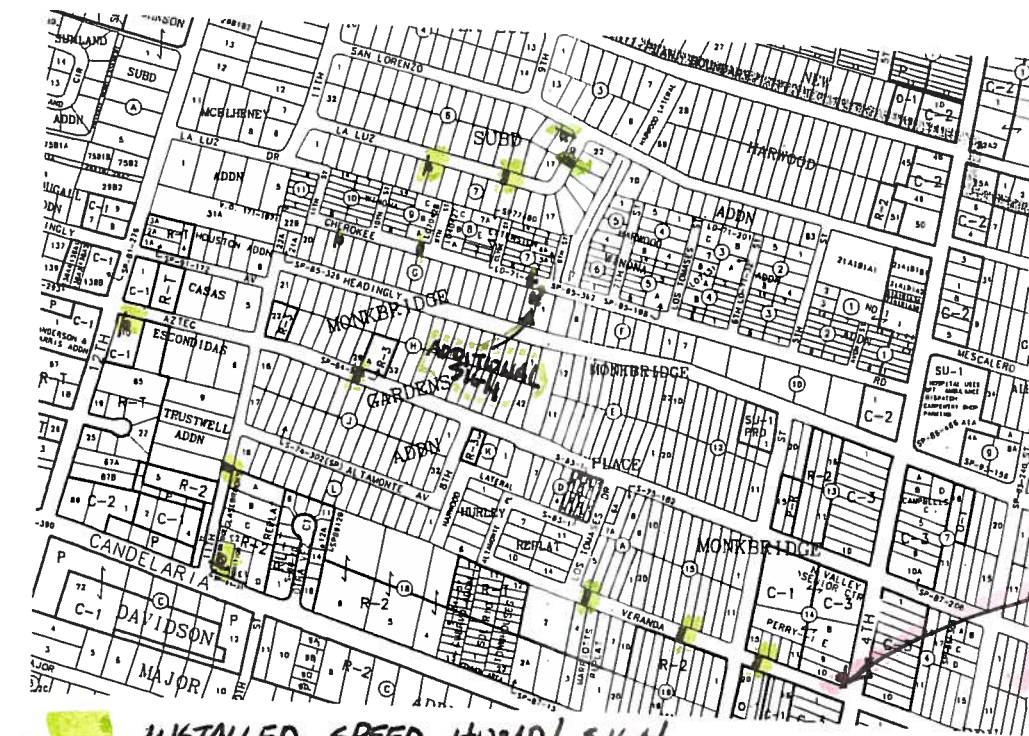

Install Type A speed humps

Install "SPEED HUMPS" signs as shown

ROLE INSTALLED
SIGN REMOVED
WITHIN 5' OF A "NO PARK"
SIGN.


G-14

INSTALLED SPEED HUMP / SIGN



NOT INSTALLED

FIELD VISIT ON 5/9/06, R. GUTIERREZ

SPEED HUMP PROFILE

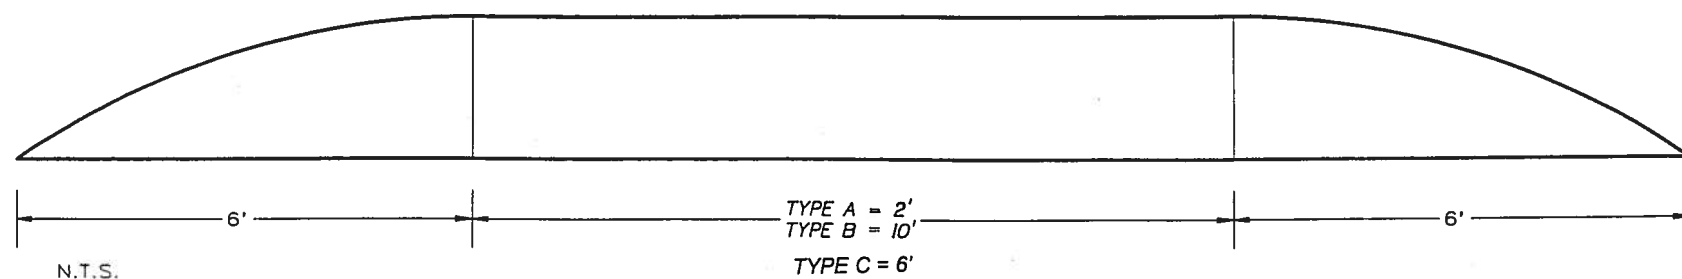

APPROACH DETAIL

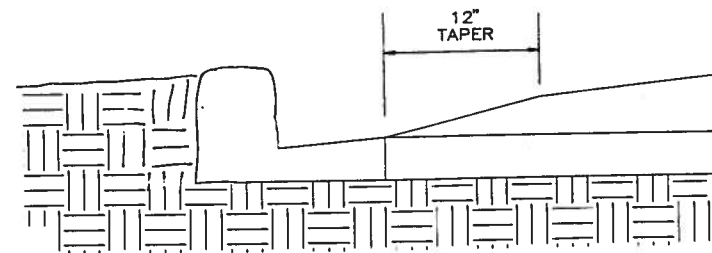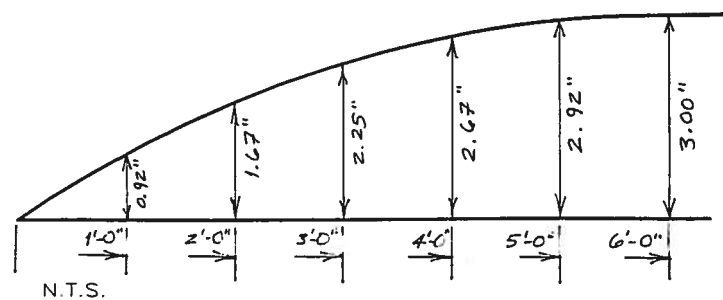

N.T.S. CURB TREATMENT



City of Albuquerque

P. O. BOX 1293 ALBUQUERQUE, NEW MEXICO 87103
PUBLIC WORKS DEPARTMENT - TRAFFIC ENGINEERING DIVISION

7150.15

La Luz Dr NW

Cherokee Rd NW


Aztec Rd NW

Veranda Rd NW

11th Street NW

Speed Hump Installation

Approved By: Ronald E. Hooten
Date: 5-12-04

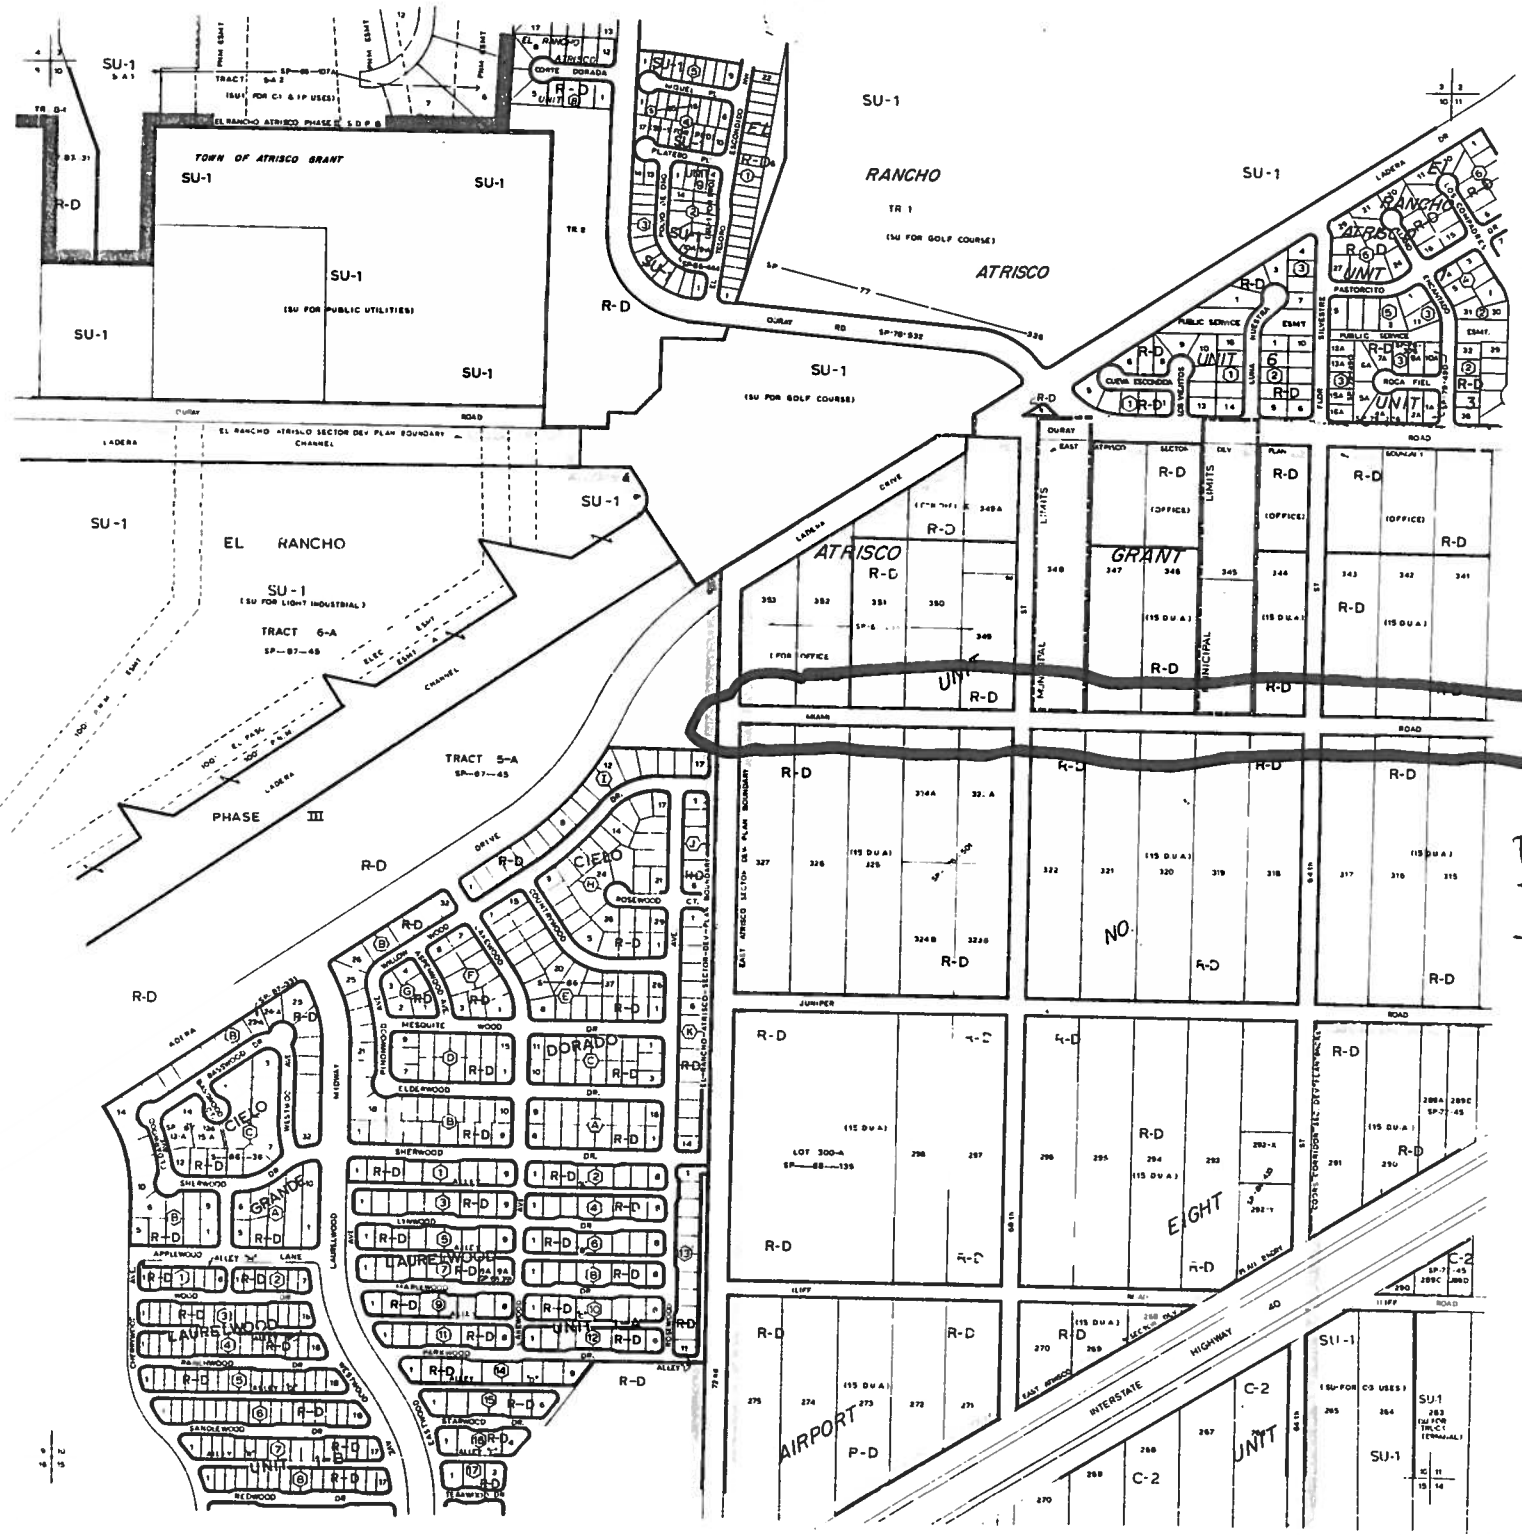

200 100 0 200 400
SCALE

PAIC 2003-1
7150.15
TLC


LEGAL DESCRIPTION
T 10 N
R 2 E
SEC 10

UNIFORM PROPERTY CODE
5-010-058

MAP AMENDED THROUGH
MAY 1989

H-10-Z
CITY OF ALBUQUERQUE
PLANNING DEPARTMENT


5/9/06, NO SIGNS OR SPEED HUMPS INSTALLED.

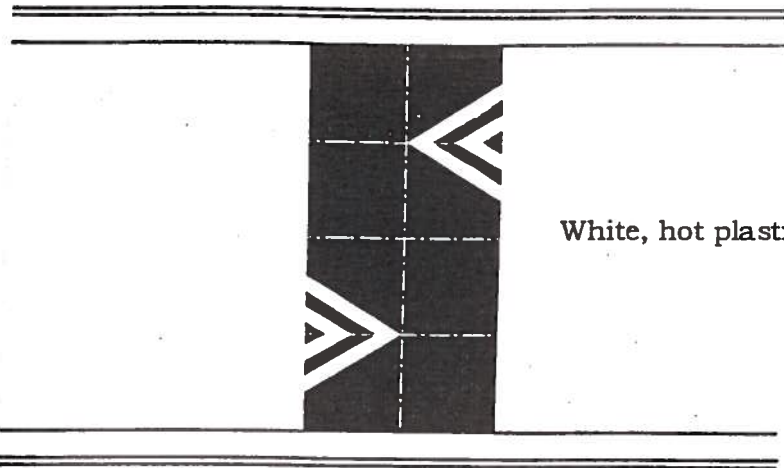

White, hot plastic markings

MARKING PLAN

Not To Scale

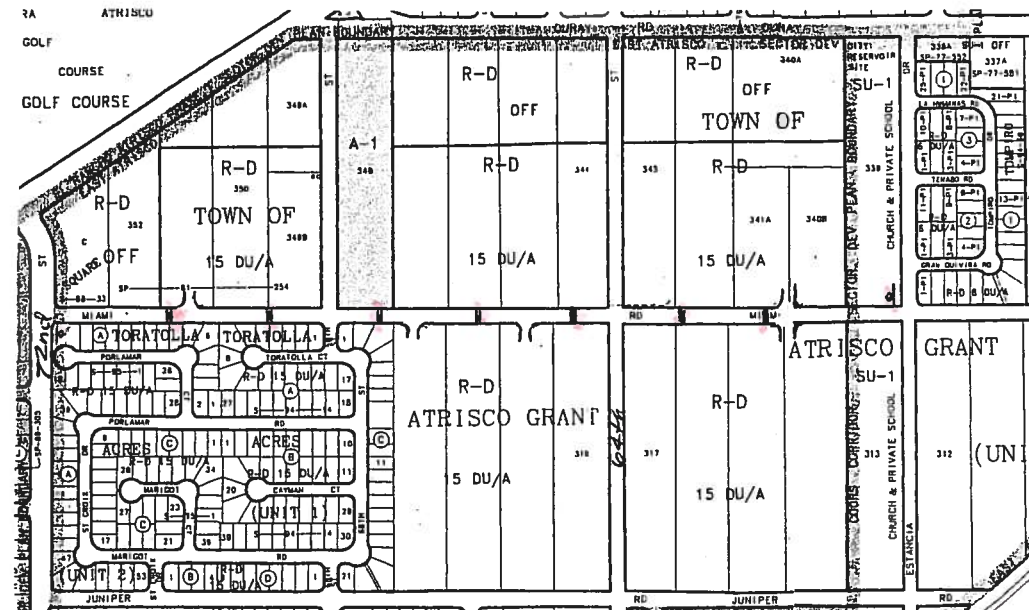


Install Type A speed humps



Install "SPEED HUMPS" signs as shown

H-10

SPEED HUMP PROFILE

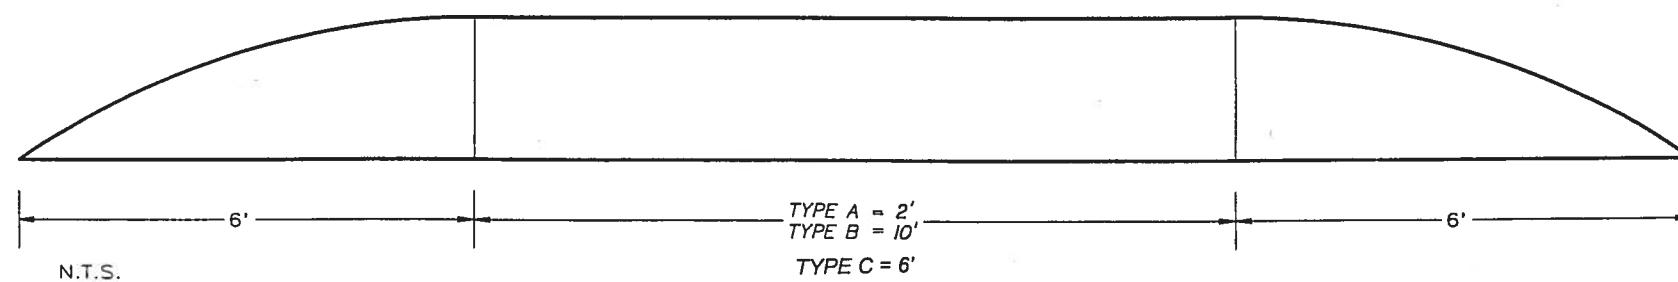

APPROACH DETAIL

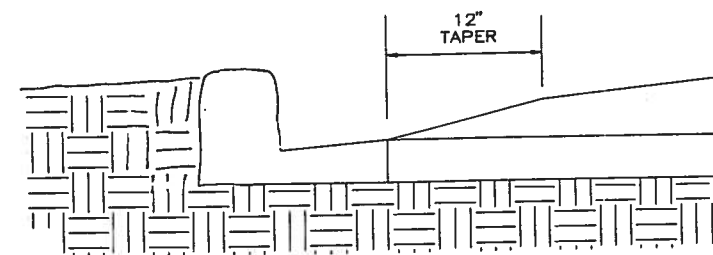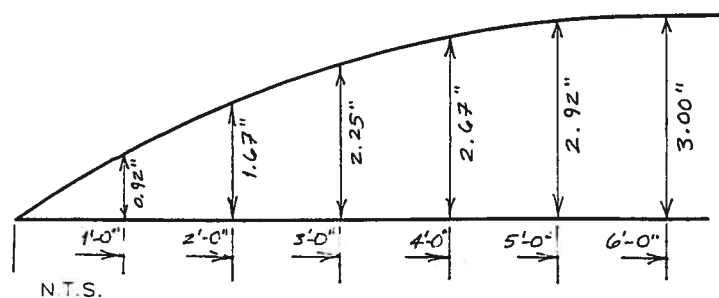

N.T.S. CURB TREATMENT



7389470
City of Albuquerque

P. O. BOX 1293 ALBUQUERQUE, NEW MEXICO 87103
PUBLIC WORKS DEPARTMENT - TRAFFIC ENGINEERING DIVISION

7150.15
Miami NW

Estancia to 72nd
Speed Hump Installation

Approved By: Ronald E. Harsett
Date: 3-1-04