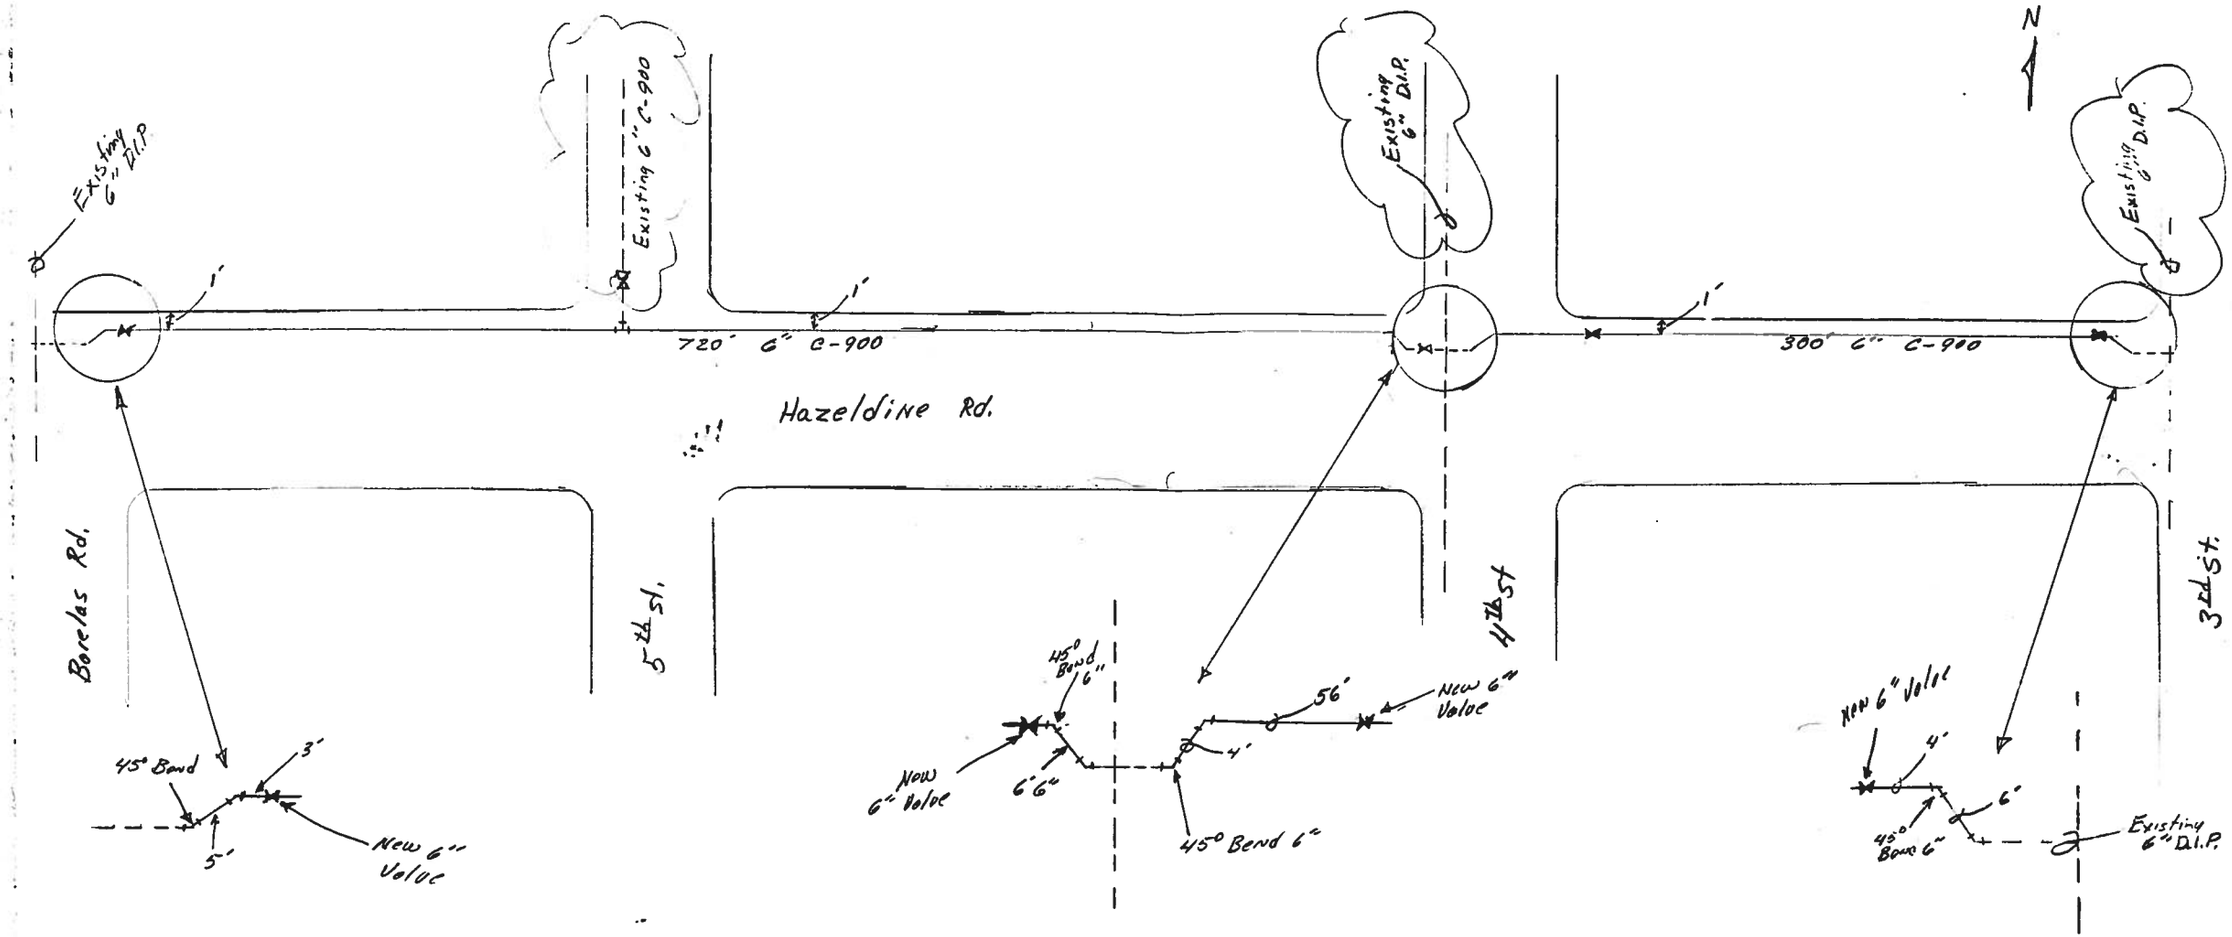

P.W. 2003-02
Project # 7200.04 map # K-14
Hazeldine water Line Replacement.
Work By: J.R. Hale Const.
As-Built: Bobby Smith COA. INSP